


REV 5		TBO NO: MCFI-INV24		PROJECT MEASURE	
BUILDING: AUX		DUKE PIPING CLASS: CL.2 (R/SWE SECT III)			
		SYSTEM SYMBOL: CHEMICAL & MECHANICAL CONTROL			
		PIPING SPEC.: NV-11 PS 1504.2			
		DRAWING NO.: MC 188-22.01-00			
NO	REVISION	DATE	BY	DATE	DATE
1	FOR CONST.				

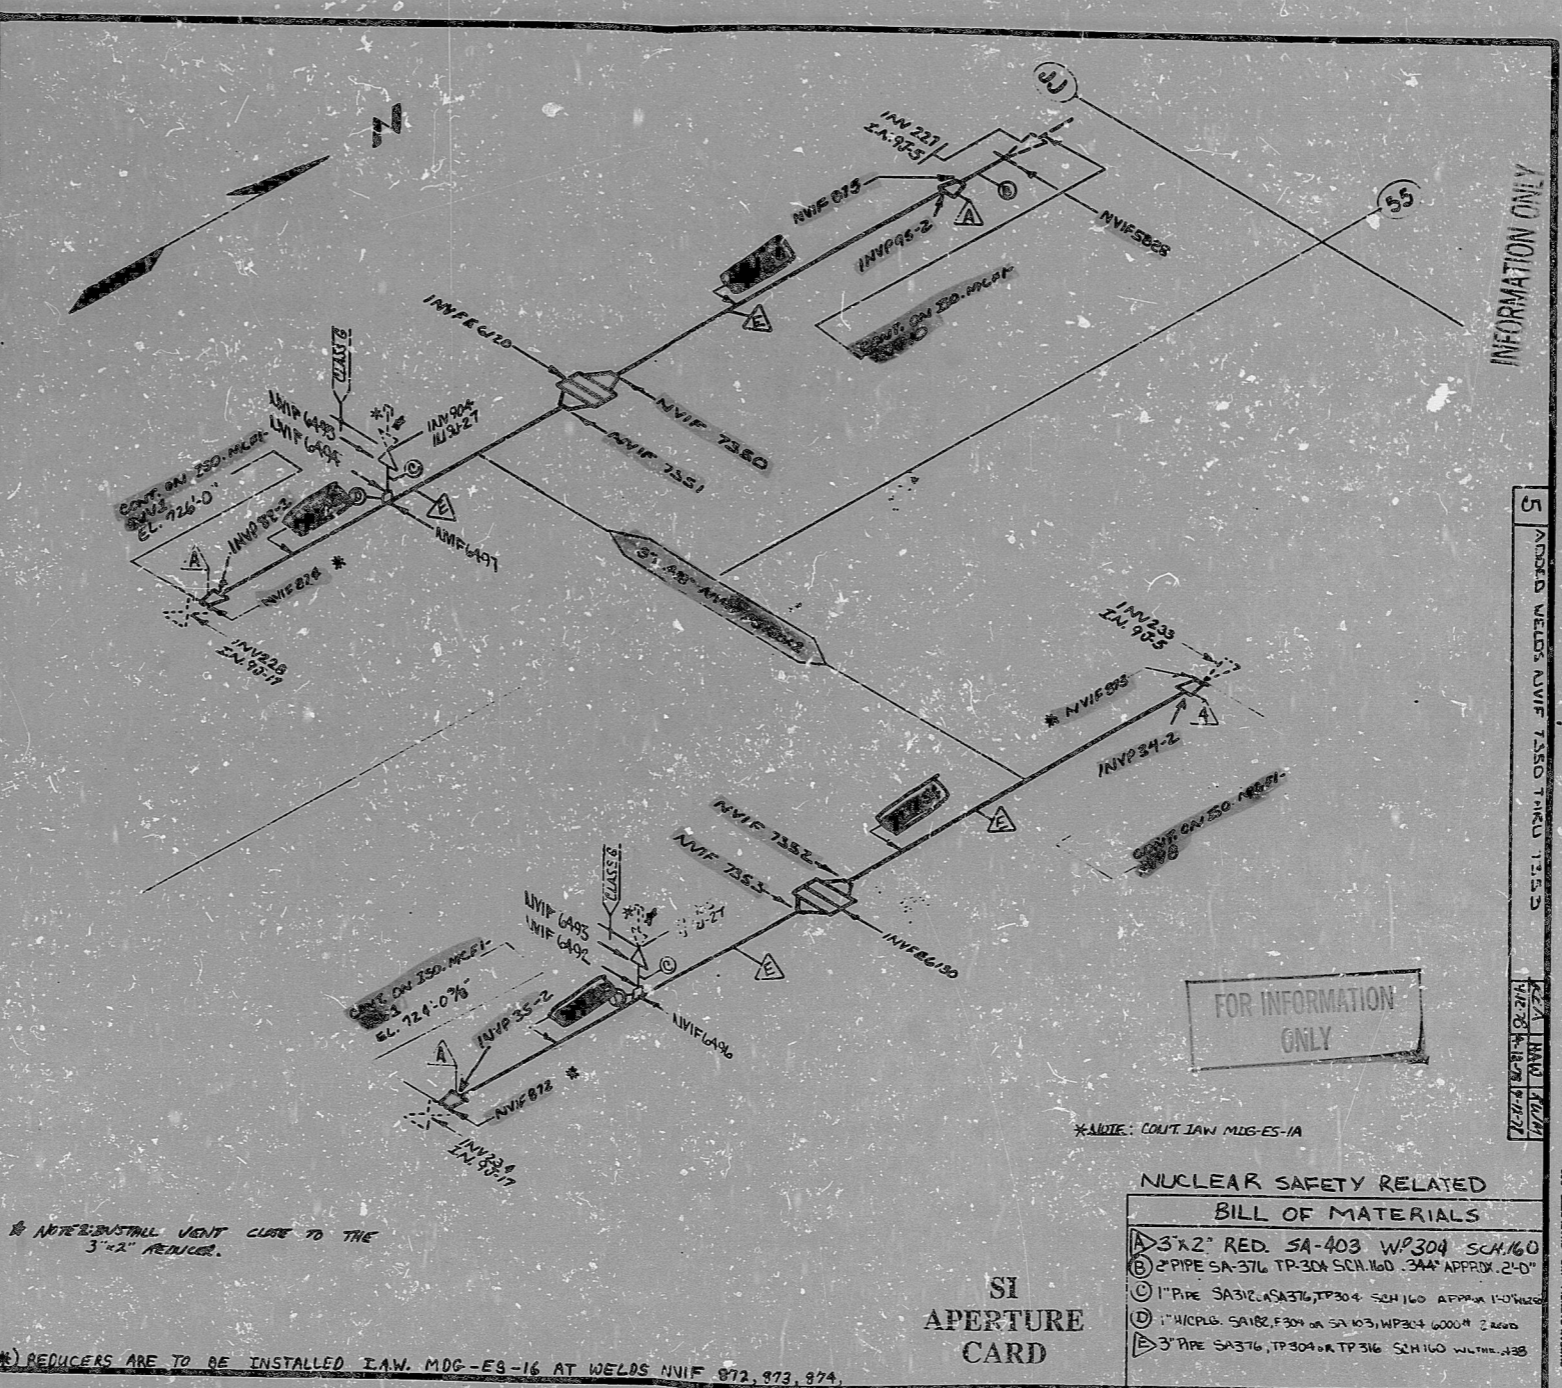

FOR INFORMATION ONLY

NUCLEAR SAFETY RELATED  
BILL OF MATERIALS

①	3"x2" RED. SA-403 WP304 SCH160
②	2" PIPE SA-37L TP304 SCH160 .344" APPROX 2'-0"
③	1" PIPE SA312 SA376 TP304 SCH160 APPROX 1'-0"
④	1" NIPPLE SA182 F304 or SA 103 WP304 60004 2.000
⑤	3" PIPE SA376 TP304 TP316 SCH160 WITH .133

INFORMATION ONLY

5  
ADDED WELDS NVIF 7550 THRU 7553  
REVISED DRAWING DATE 1/27/55

PDR RIDS

9301190255

