


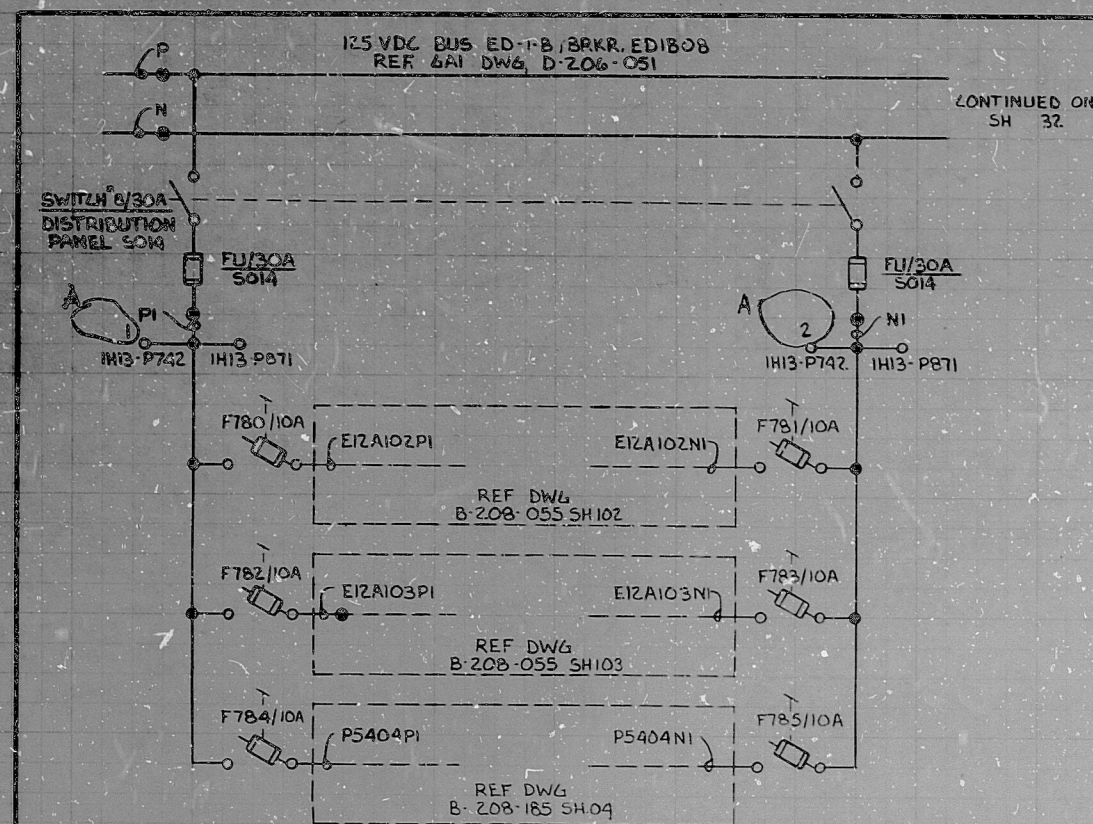

LEGEND:-

- EXTERNAL WIRE MARK (SEE NOTE 2)
- INTERNAL WIRE MARK
- F780 - BUCHANAN GANGED, FUSE BLOCK
- F785
- CLASS 1E DIV. 2 THIS SHEET
- 1H13-P742A - TERMINATION CAB. 05-5

NOTES:-

1. DEVICES WITHOUT LOCATION MARKS ARE LOCATED IN 1H13-P871.
2. POTENTIAL WIRE MARKS ARE PREFIXED BY:
SYSTEM AND SHEET NUMBER (EXAMPLE: R4230PI).
3. DEVICE DESIGNATIONS ARE PREFIXED BY:
UNIT AND SYSTEM NUMBER (EXAMPLE: 1R42-F780).

REFERENCES:-

- D-206-051 GAI 125V DC ONE LINE DIAGRAM
- B-211-215 SH. 5 GAI BLOCK DIAG

TERA
APERTURE
CARD

NUCLEAR SAFETY RELATED

THE CLEVELAND ELECTRIC ILLUMINATING CO.

PERRY NUCLEAR POWER PLANT UNIT 1

ELECTRICAL-ELEMENTARY DIAGRAM

DC SYSTEM

AUX RELAY PANEL 1H13-P871
POWER DISTRIBUTION

8-25-77	CONSTRUCTION	TFF
	PRELIMINARY	
DATE	RELEASED FOR	ENGR.

GILBERT ASSOCIATES, INC.
ENGINEERS AND CONSULTANTS

ADDED FTS AND 1H13-P742A
TO LEGEND

READING
PA.

A WJL NBS DEG MJS 1-31-77

044549-000 BS DPR DEG TFF 8-25-77

04 4549 B-208-215 R42 30 A

REV	MADE	CHKD	APPROVALS	DATE	REV	MADE	CHKD	APPROVALS	DATE	REV	MADE	CHKD	APPROVALS	DATE	REV	MADE	CHKD	APPROVALS	DATE	REV	MADE	CHKD	APPROVALS	DATE	REV	MADE	CHKD	APPROVALS	DATE	REV	MADE	CHKD	APPROVALS	DATE	REV	MADE	CHKD	APPROVALS	DATE
-----	------	------	-----------	------	-----	------	------	-----------	------	-----	------	------	-----------	------	-----	------	------	-----------	------	-----	------	------	-----------	------	-----	------	------	-----------	------	-----	------	------	-----------	------	-----	------	------	-----------	------

ELEM DIAG AUX RLY PNL 1H13-P871

DRAWING NUMBER SYSTEM SH. NO. REV.

RIDS PDK

8103310162

