


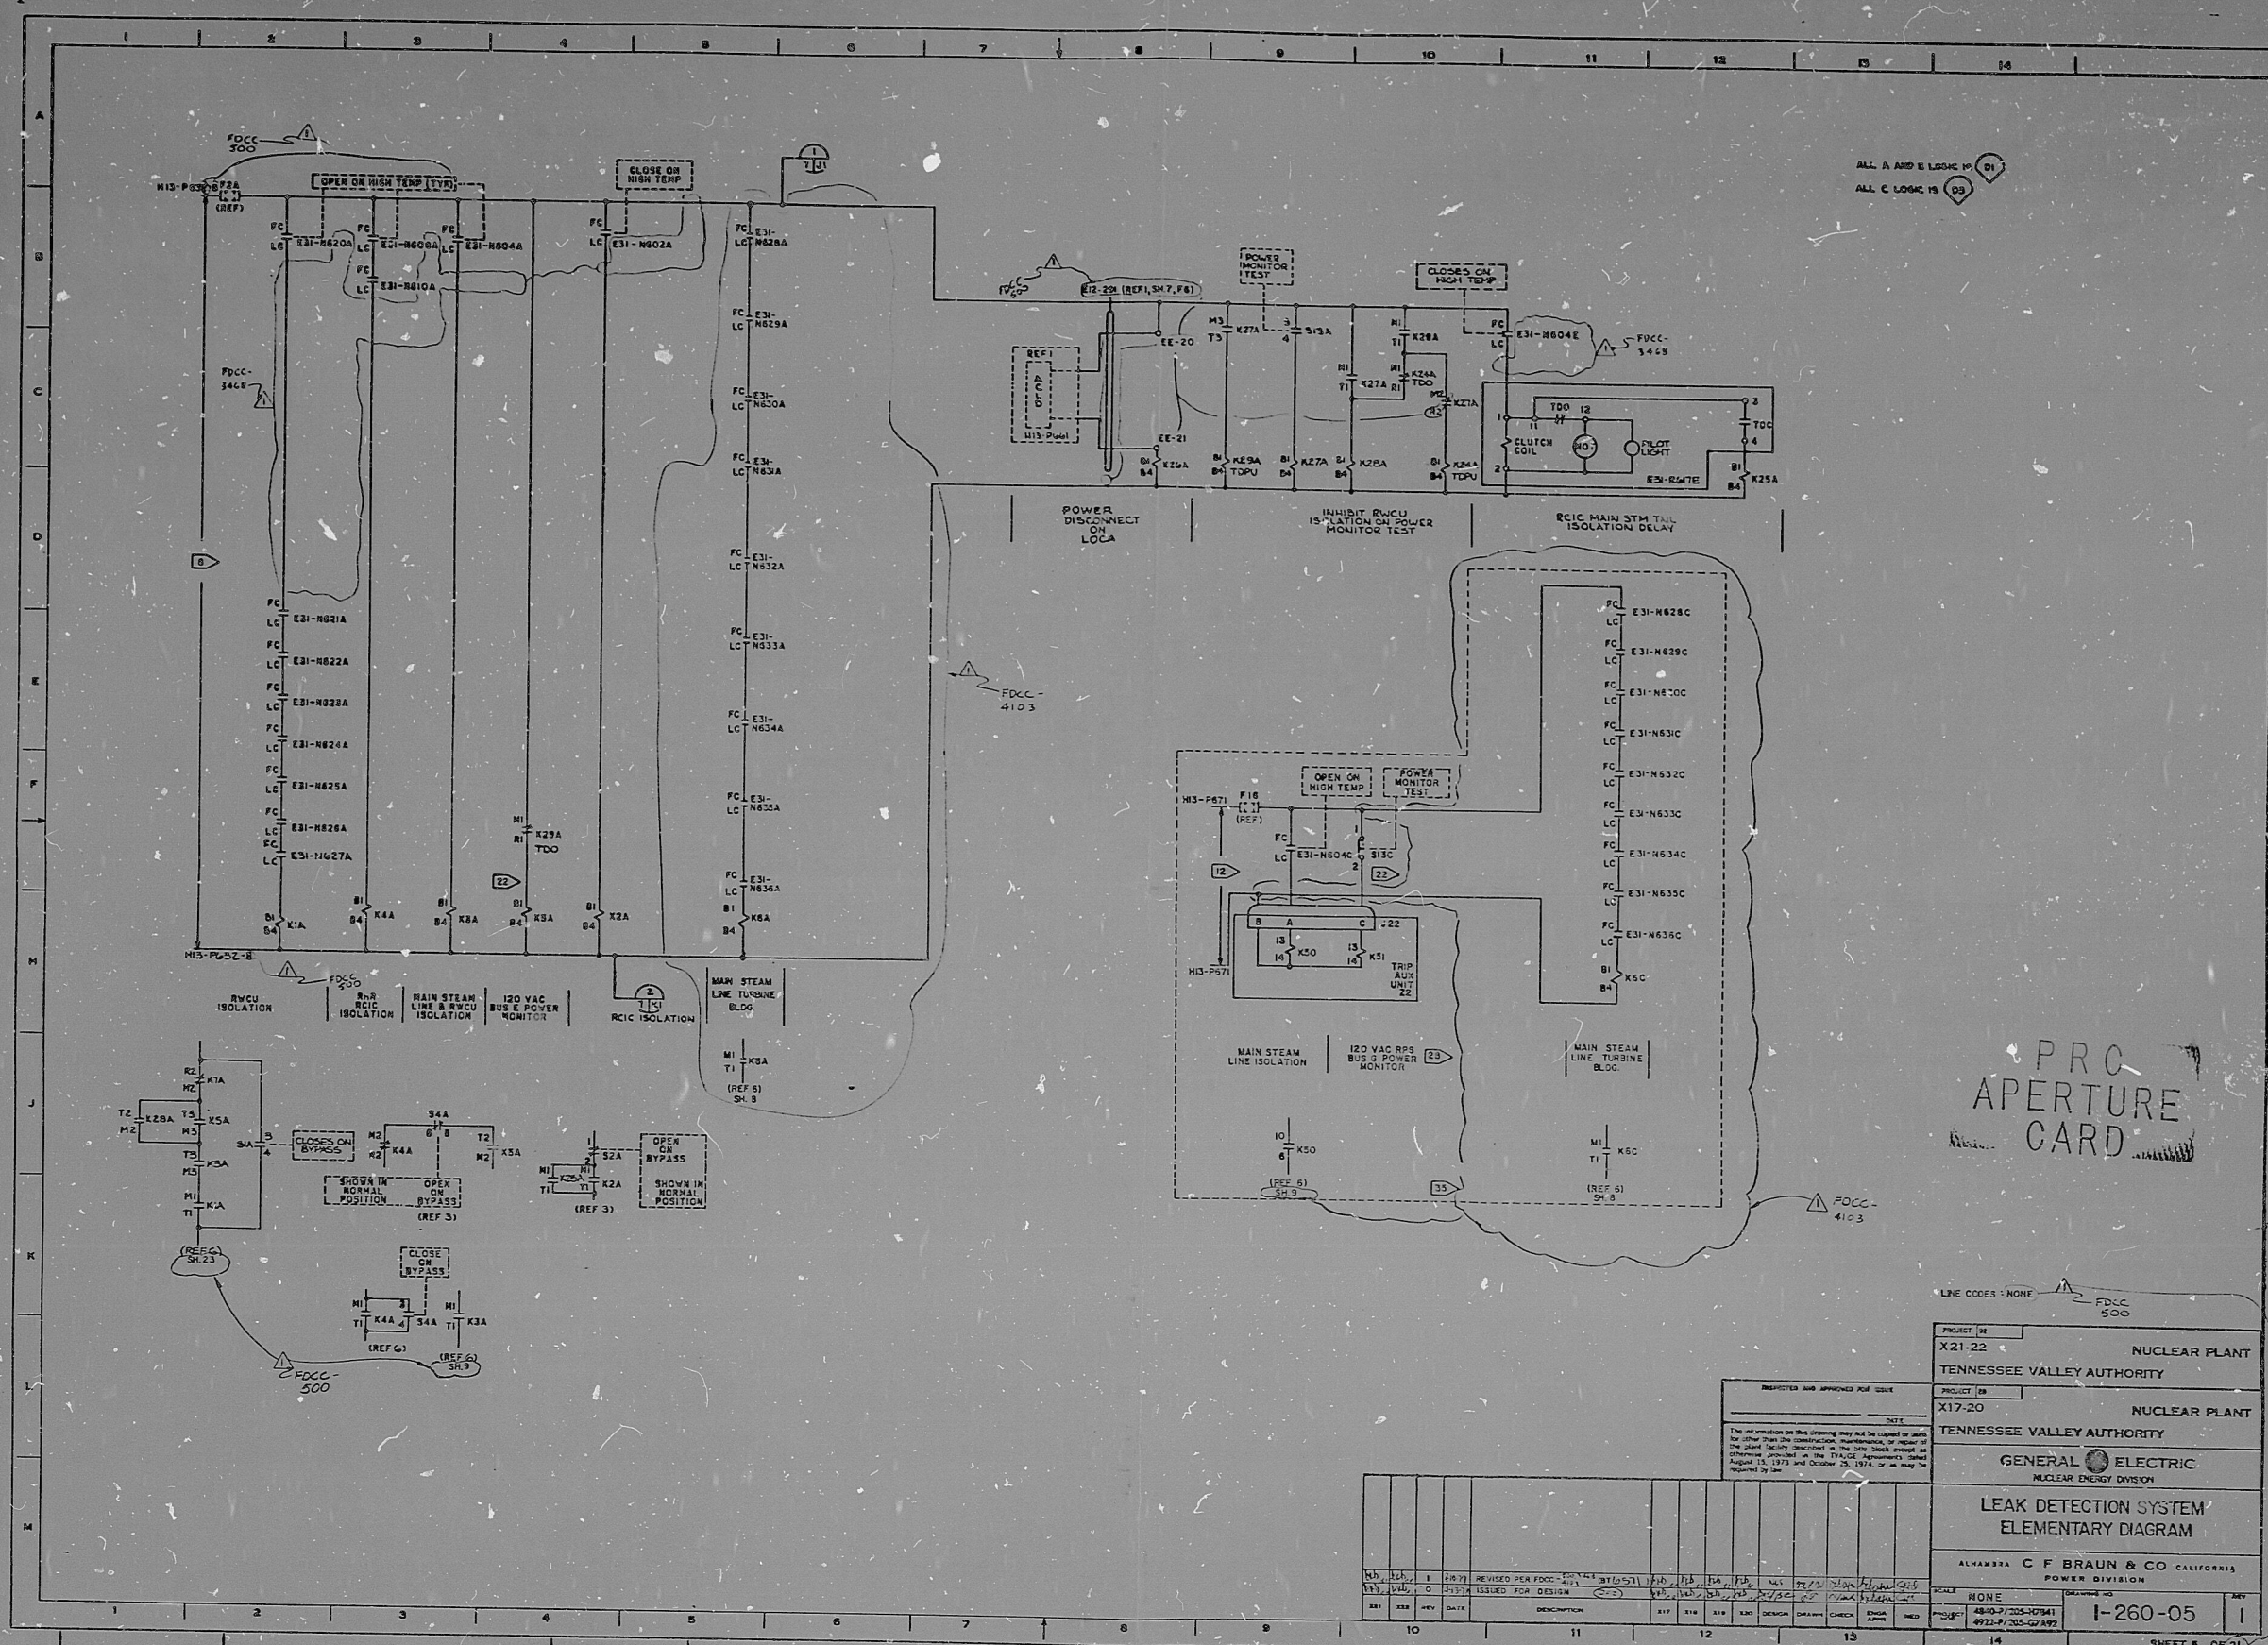

PROJECT NO.	X21-22
PROJECT NAME	NUCLEAR PLANT
PROJECT NO.	X17-20
PROJECT NAME	NUCLEAR PLANT
PROJECT NO.	GENERAL ELECTRIC
PROJECT NAME	NUCLEAR ENERGY DIVISION
PROJECT NO.	LEAK DETECTION SYSTEM
PROJECT NAME	ELEMENTARY DIAGRAM
PROJECT NO.	ALHAMBRA C F BRAUN & CO CALIFORNIA
PROJECT NAME	POWER DIVISION
PROJECT NO.	1-260-05
PROJECT NAME	SHEET 5 OF 21

RDS

8206280356

