


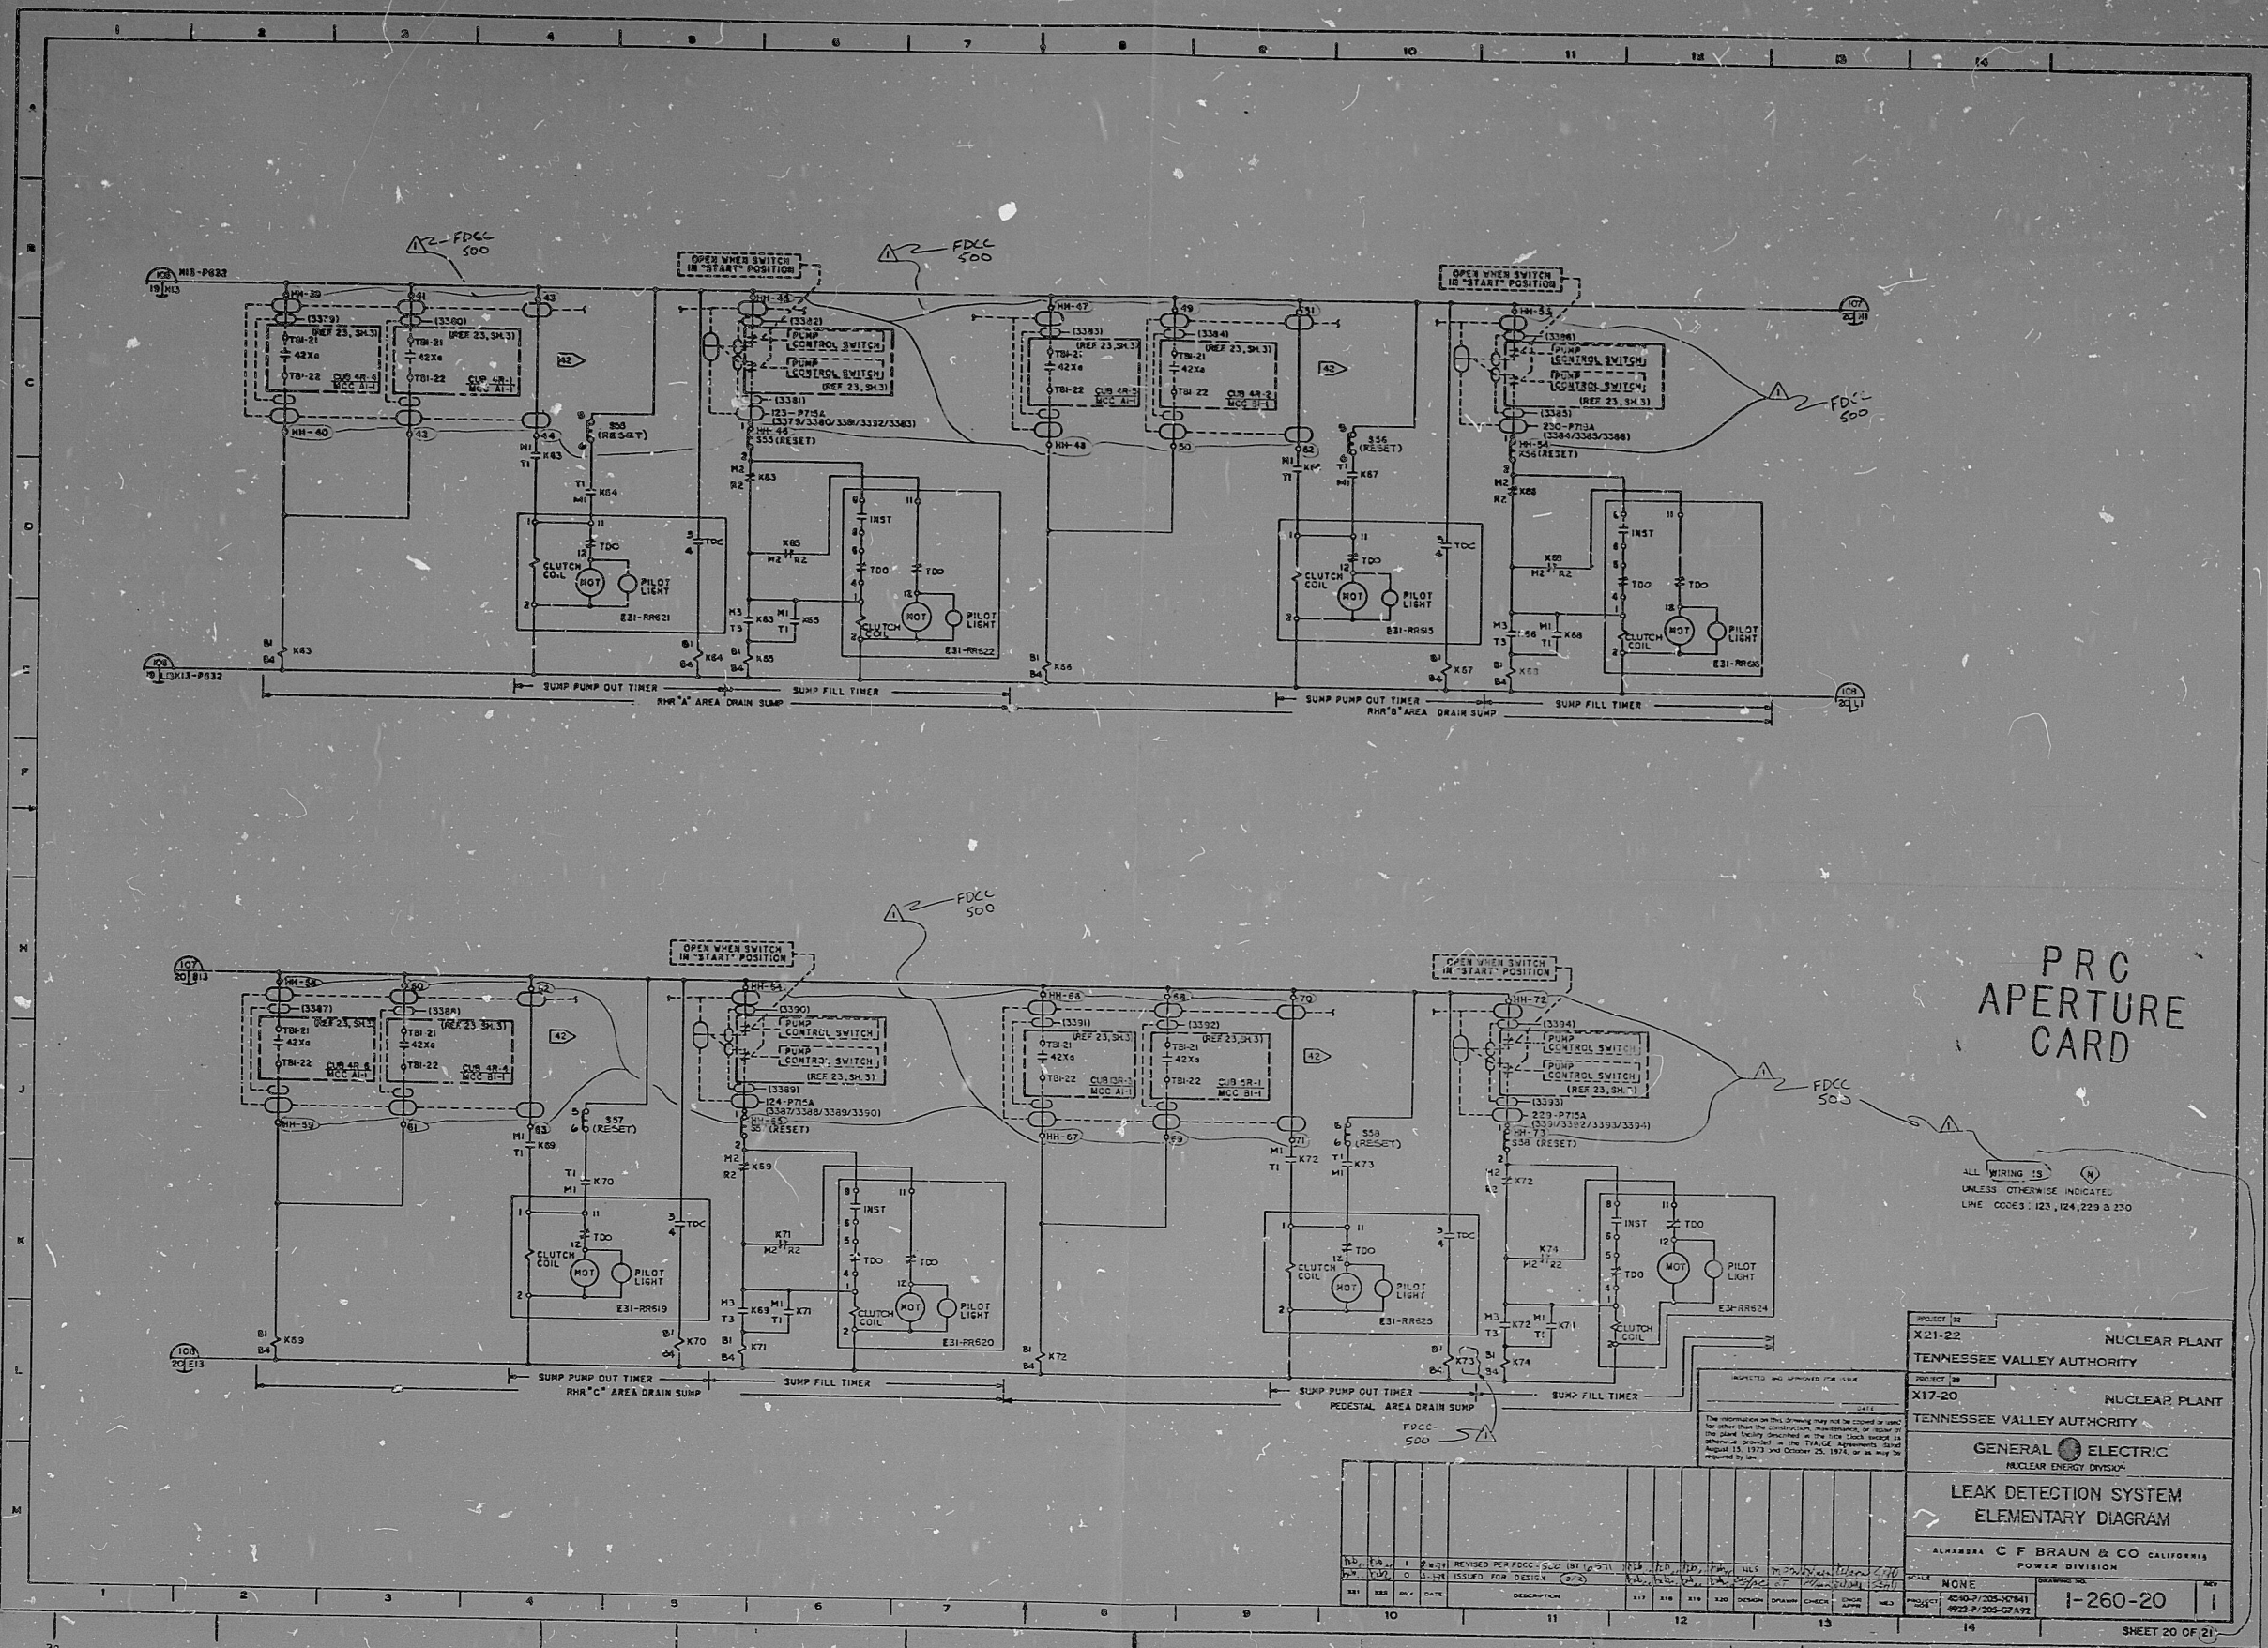



RIDS

8206280382

