


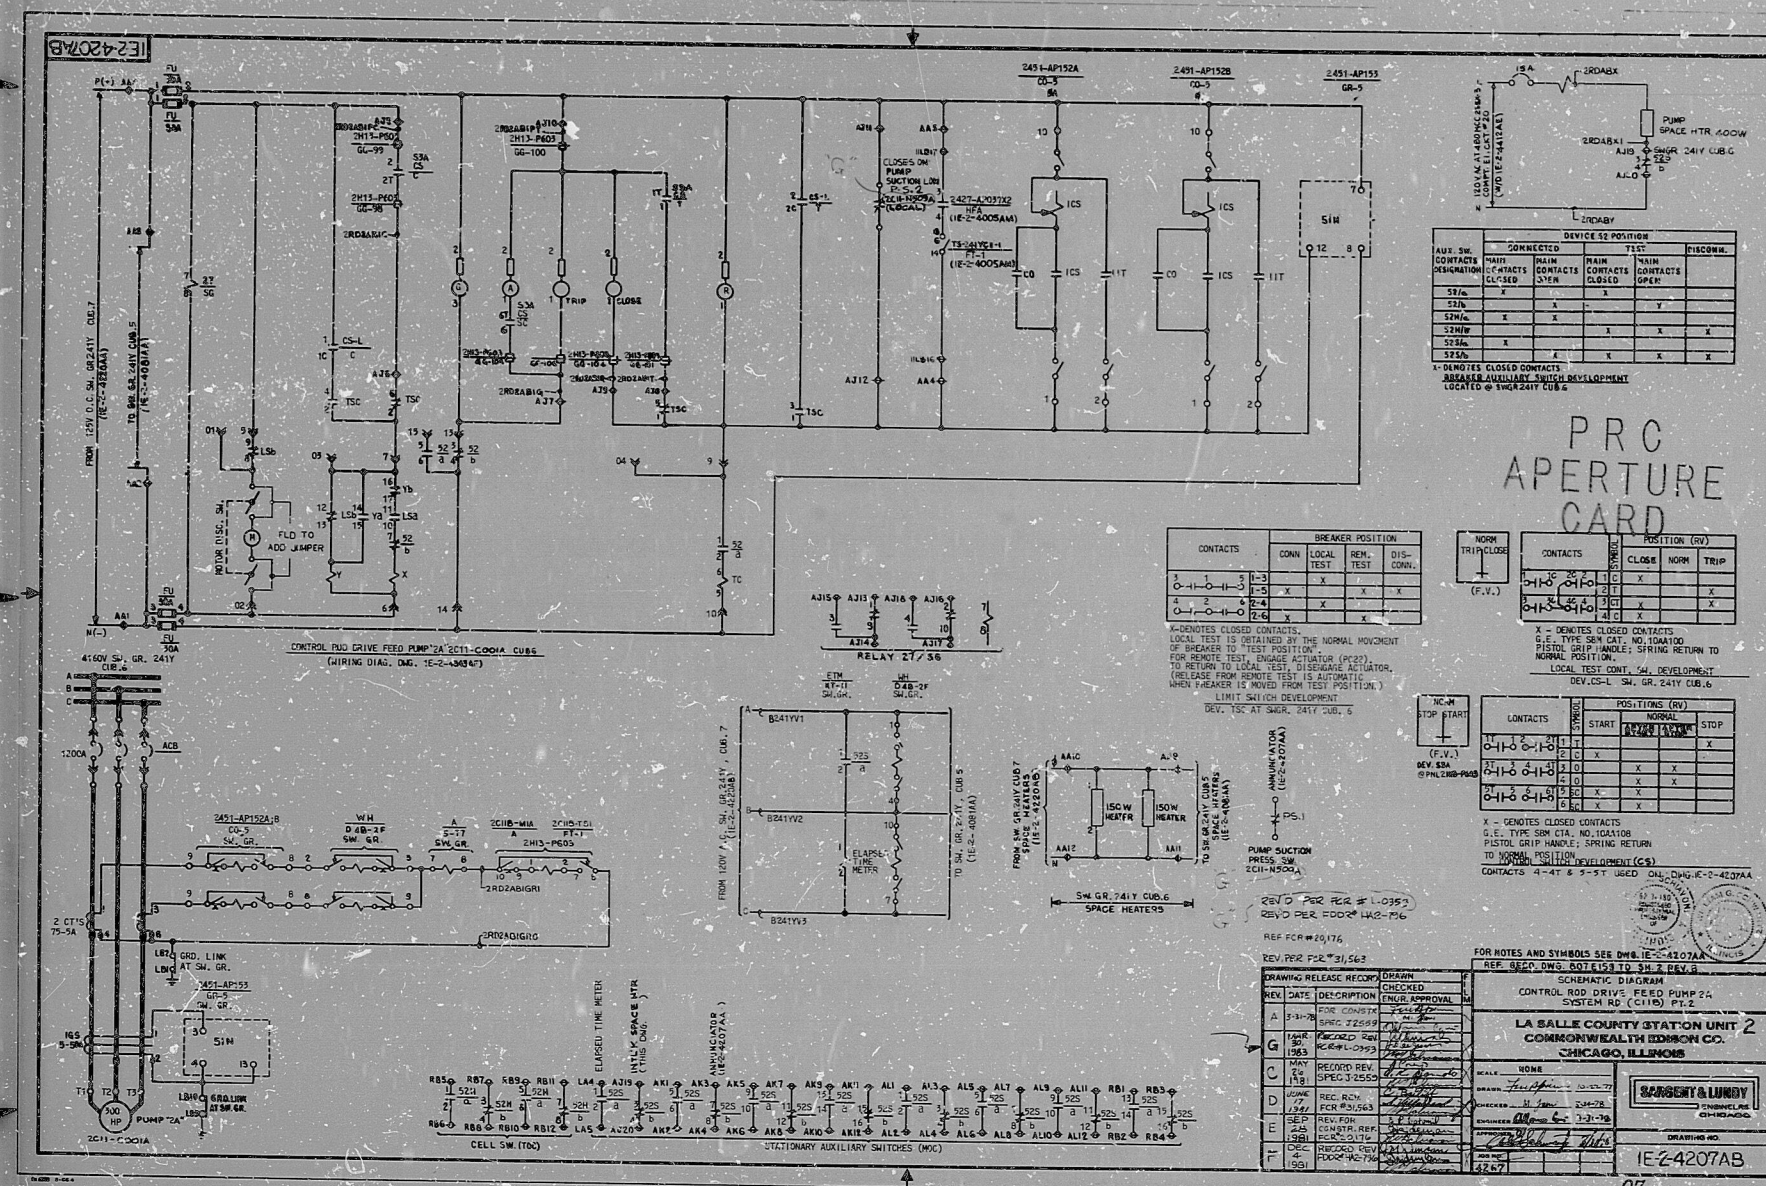

RIDS

8309010017

