


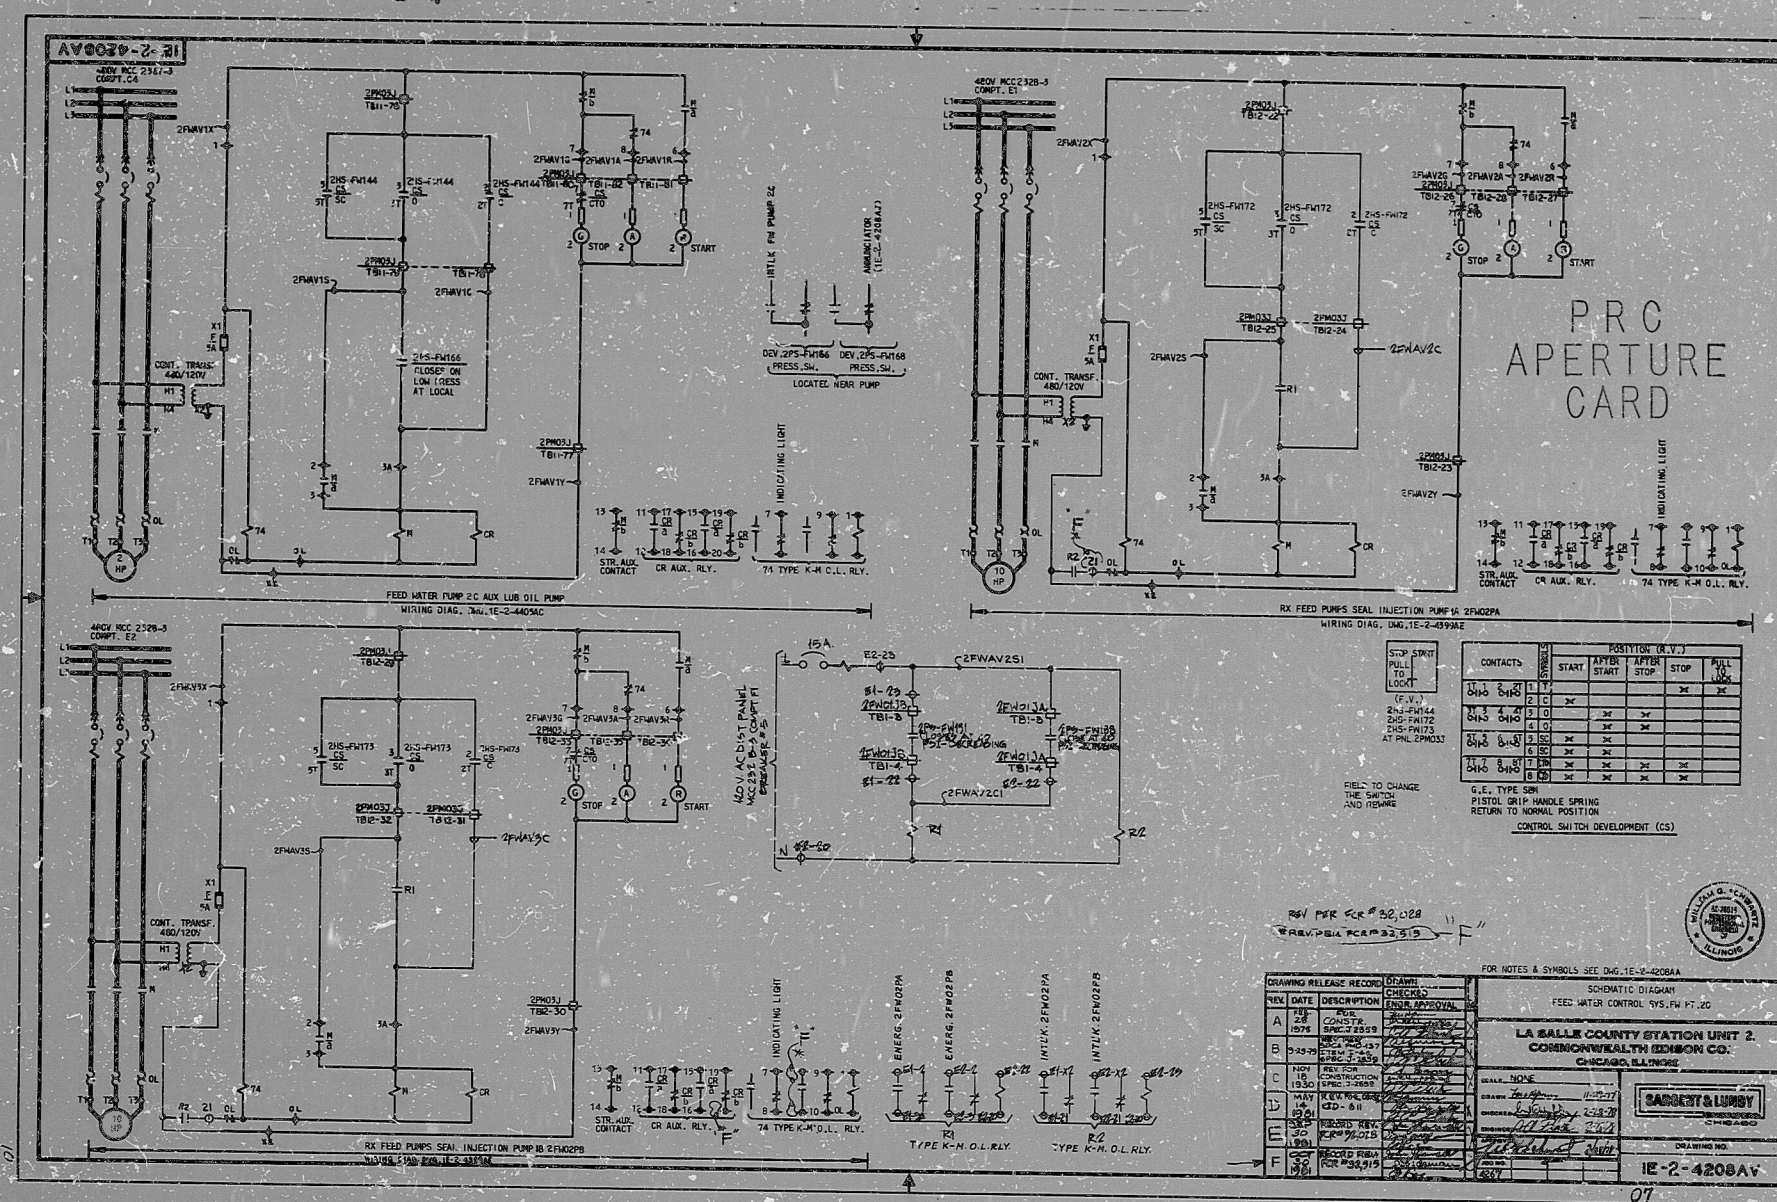

PRC
APERTURE
CARD

CONTACTS	SYMBOL	POSITION (R.V.)			
		START	AFTER START	AFTER STOP	STOP
010 2 010	1 T				
	2 C	X			X
010 3 010	3 O		X	X	
	4 O				
010 5 010	5 SC	X	X		
	6 SC	X			
010 8 010	7 SC	X	X		
	8 SC			X	X

FIELD TO CHANGE
THE SWITCH
AND REWIRE

G.E. TYPE 58M
PISTOL GRIP HANDLE SPRING
RETURN TO NORMAL POSITION

CONTROL SWITCH DEVELOPMENT (C

REV PER ECR # 32,02
REV PER ECR # 32,51


LA SALLE COUNTY STATION UNIT 2
COMMONWEALTH EDISON CO.
CHICAGO, ILL. 60602


CHICAGO, ILL. 60602

DATE RECORDED

IE-2-4208Av

RIDS

8309010047

