


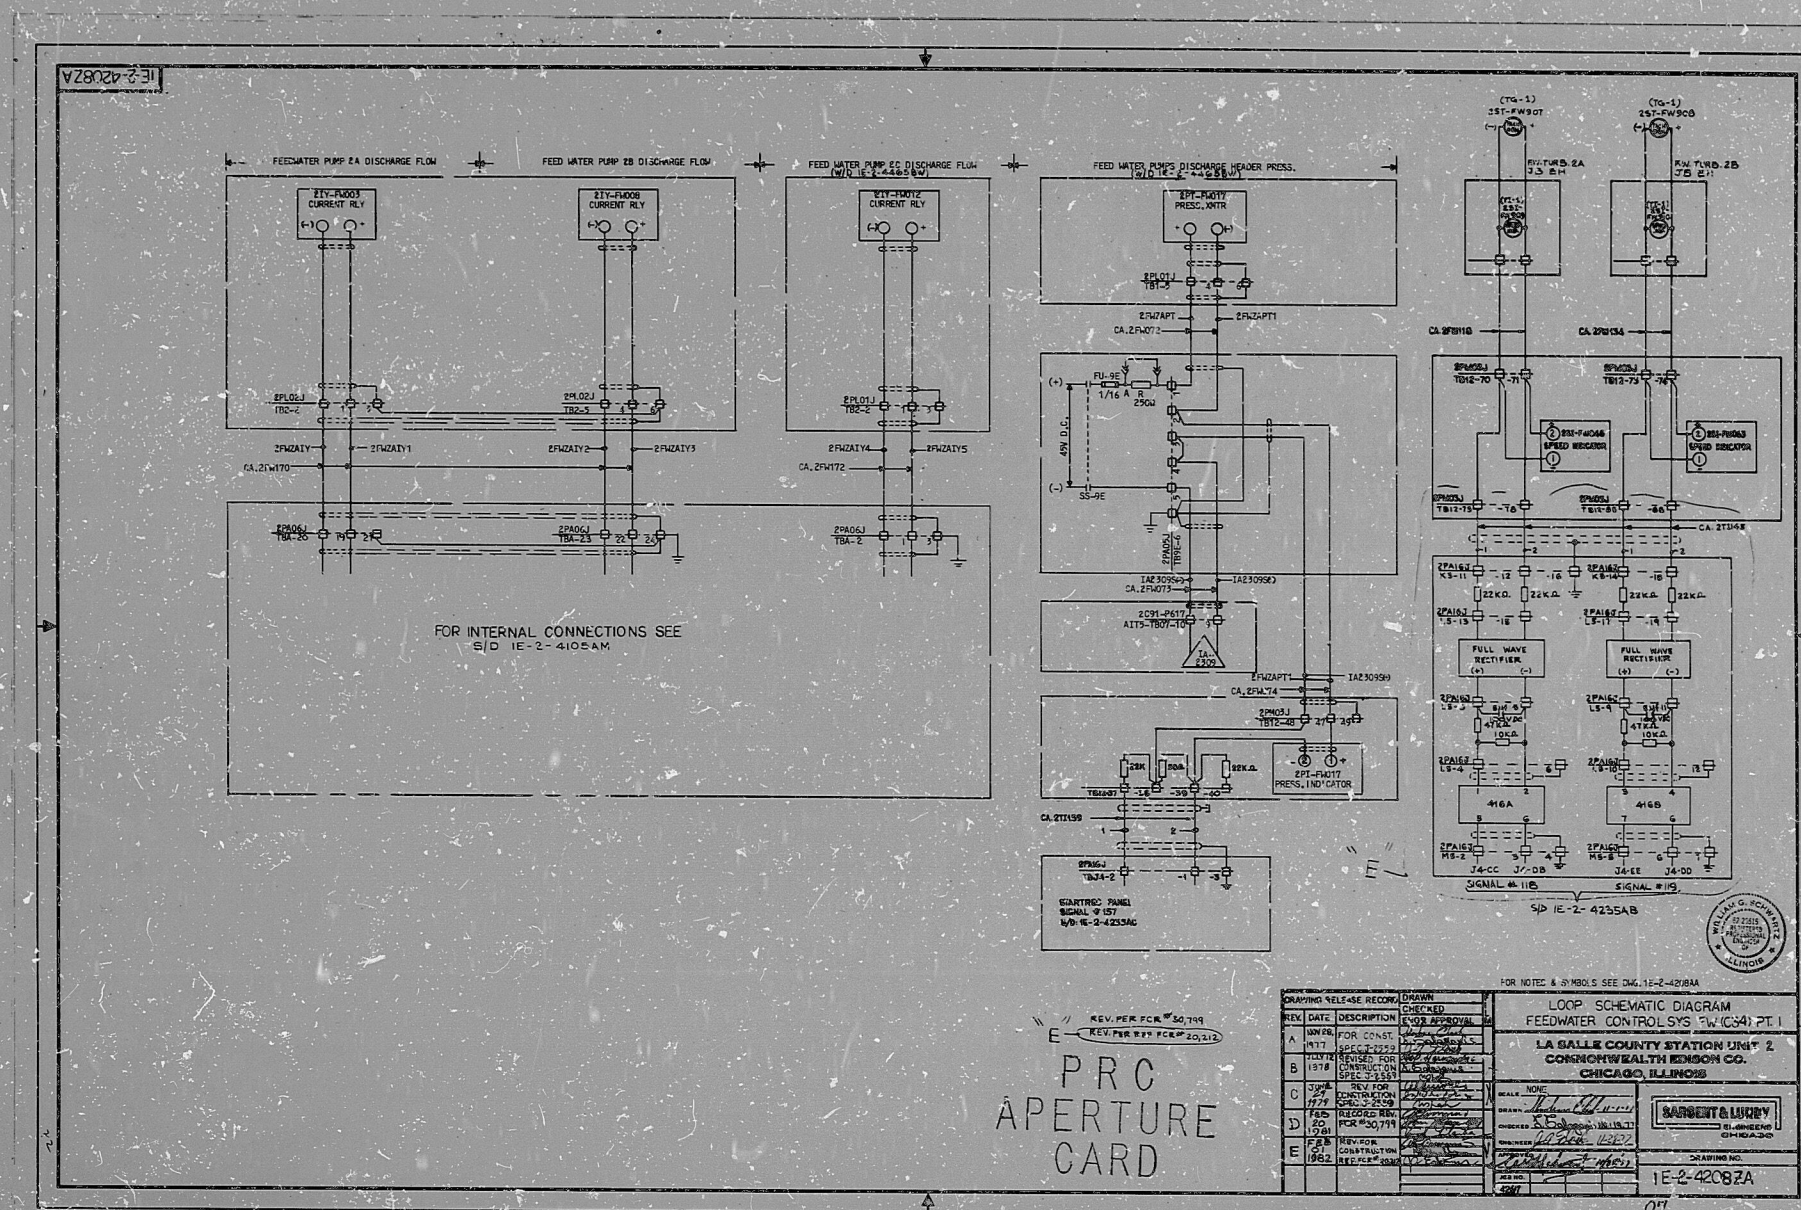

RIDS

8309010064

