


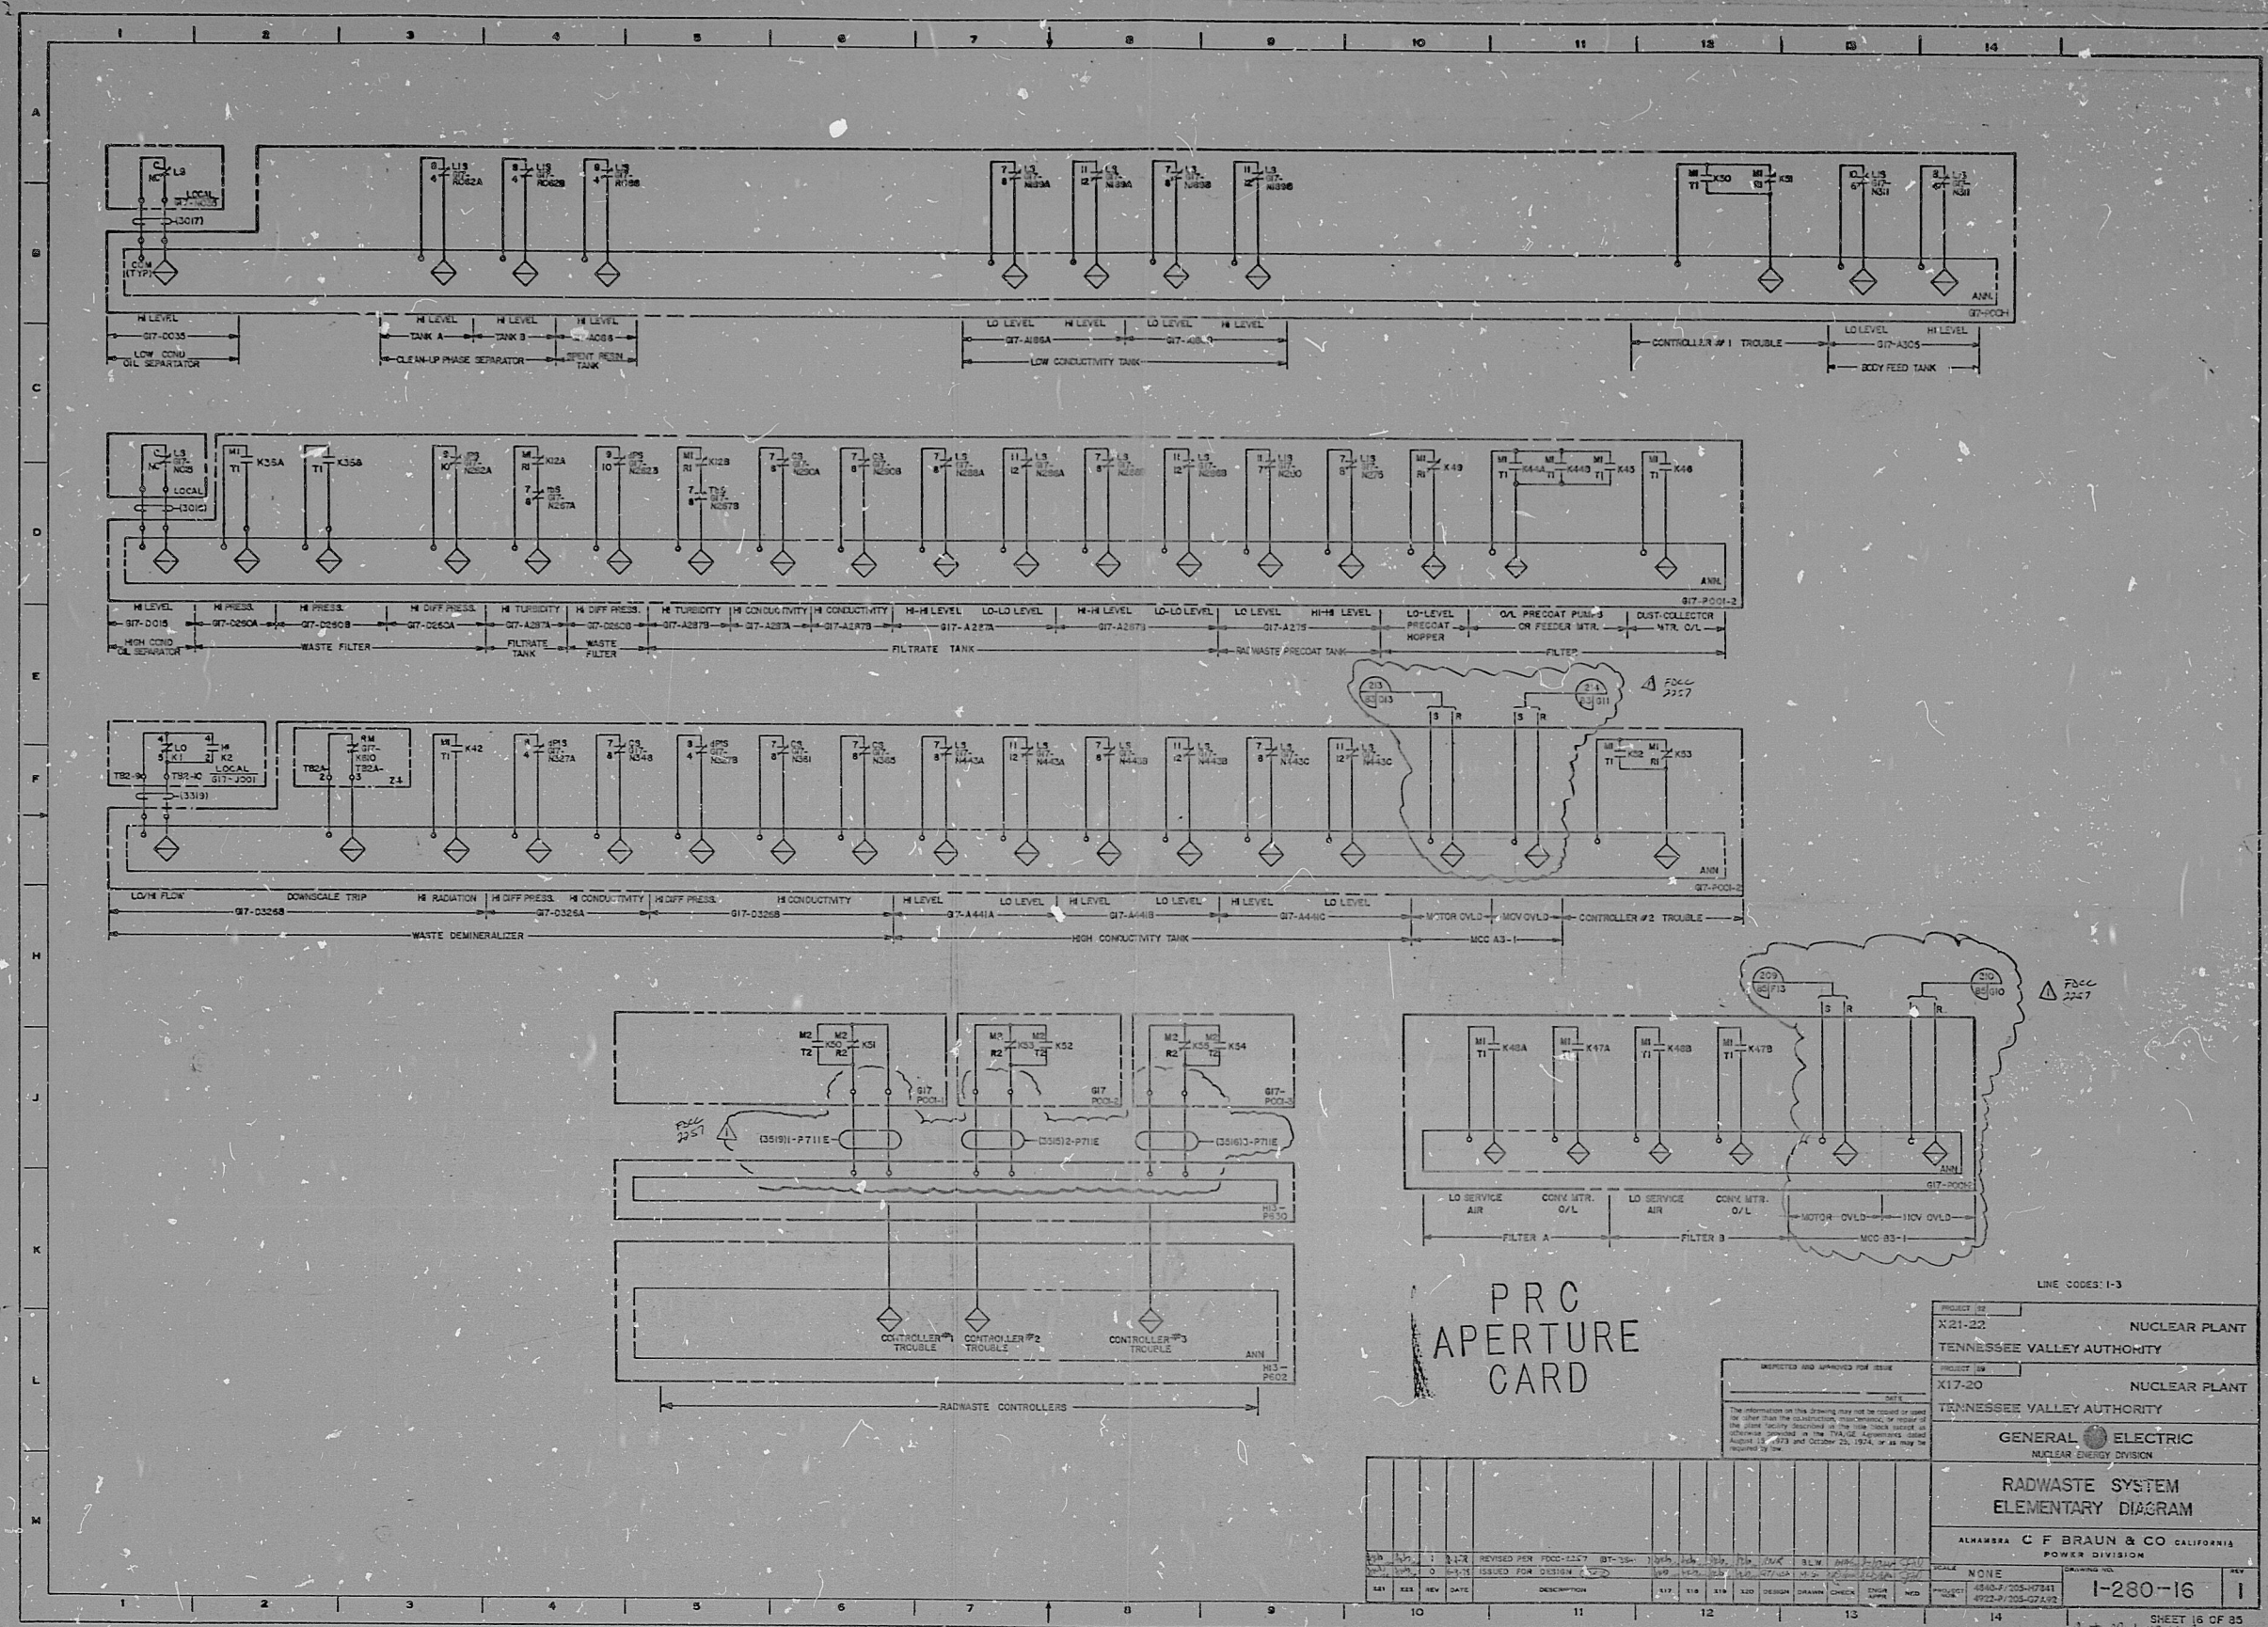



RIDS

806280620

