


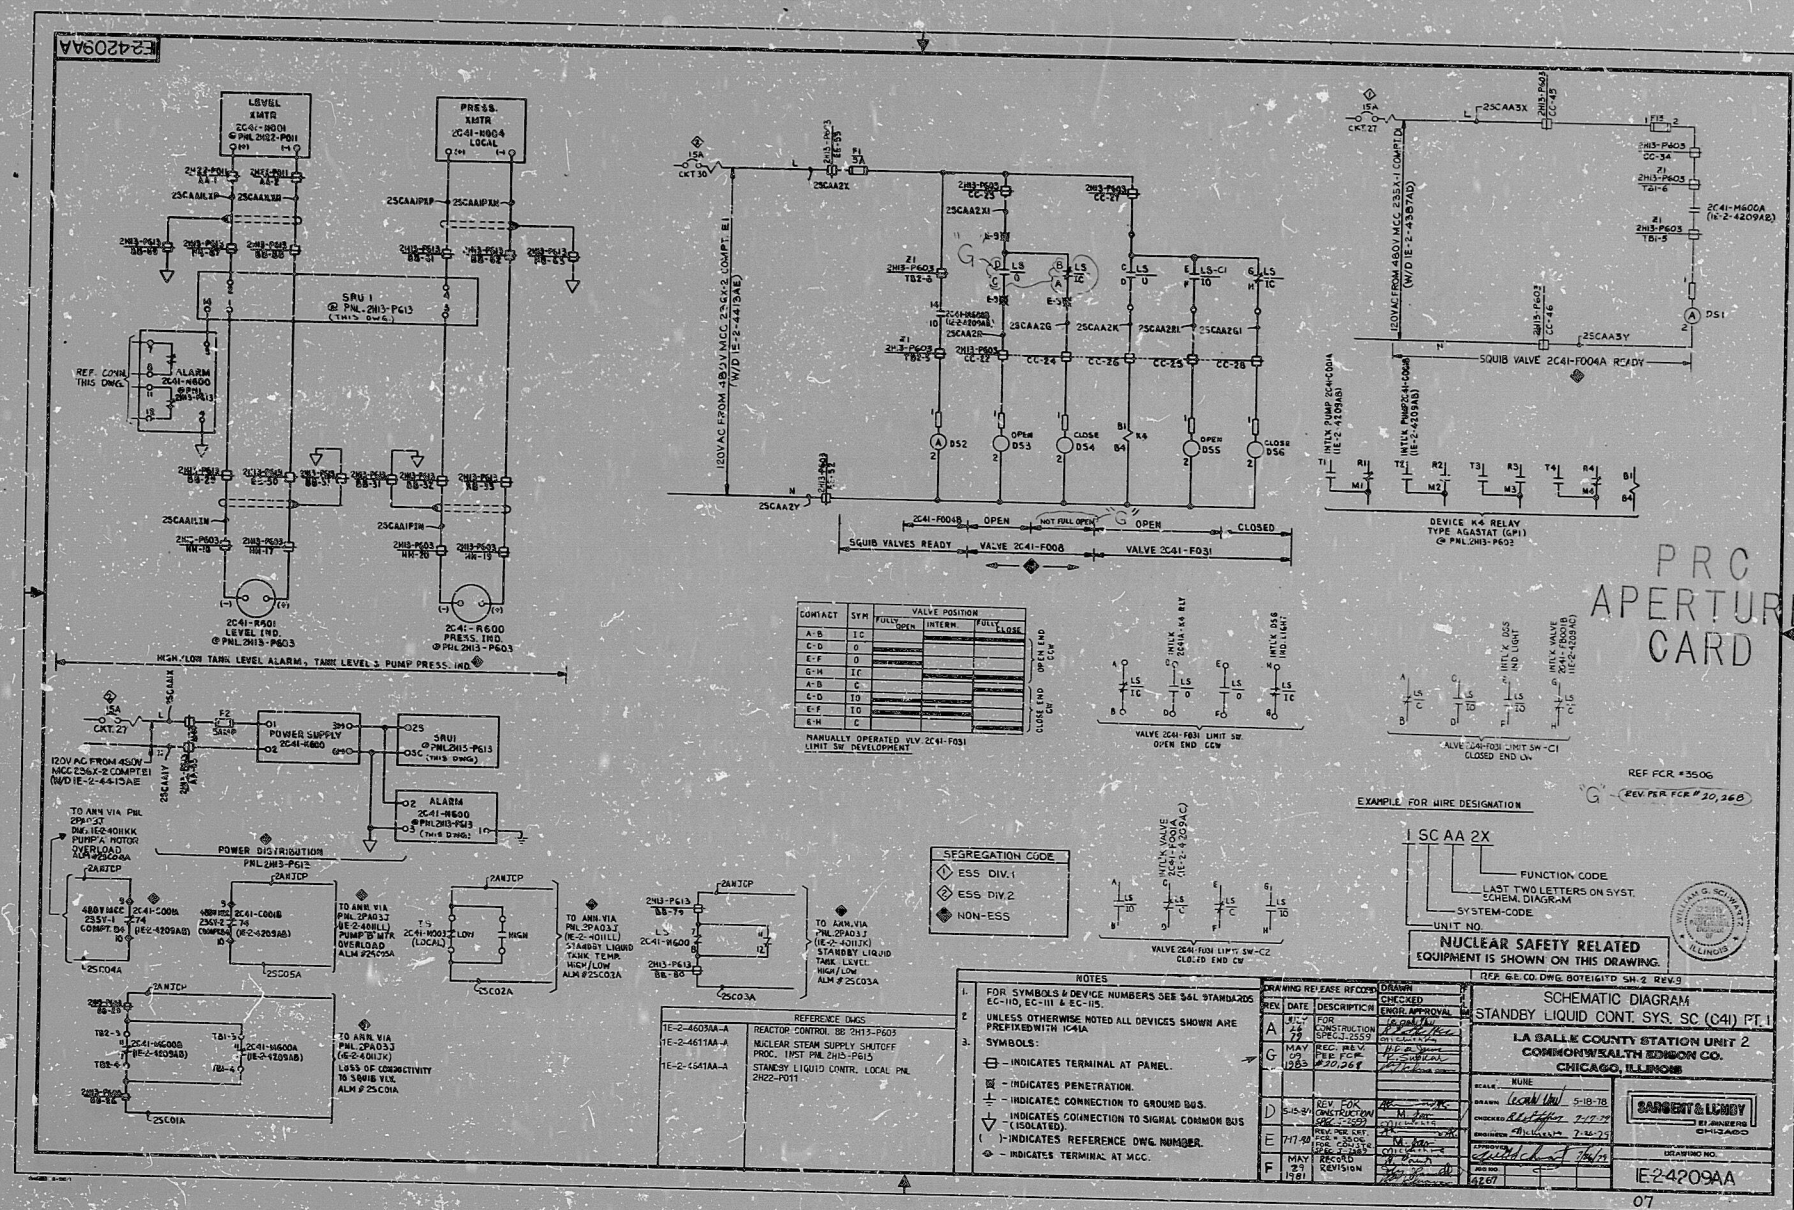

RIDS

8309010105

