


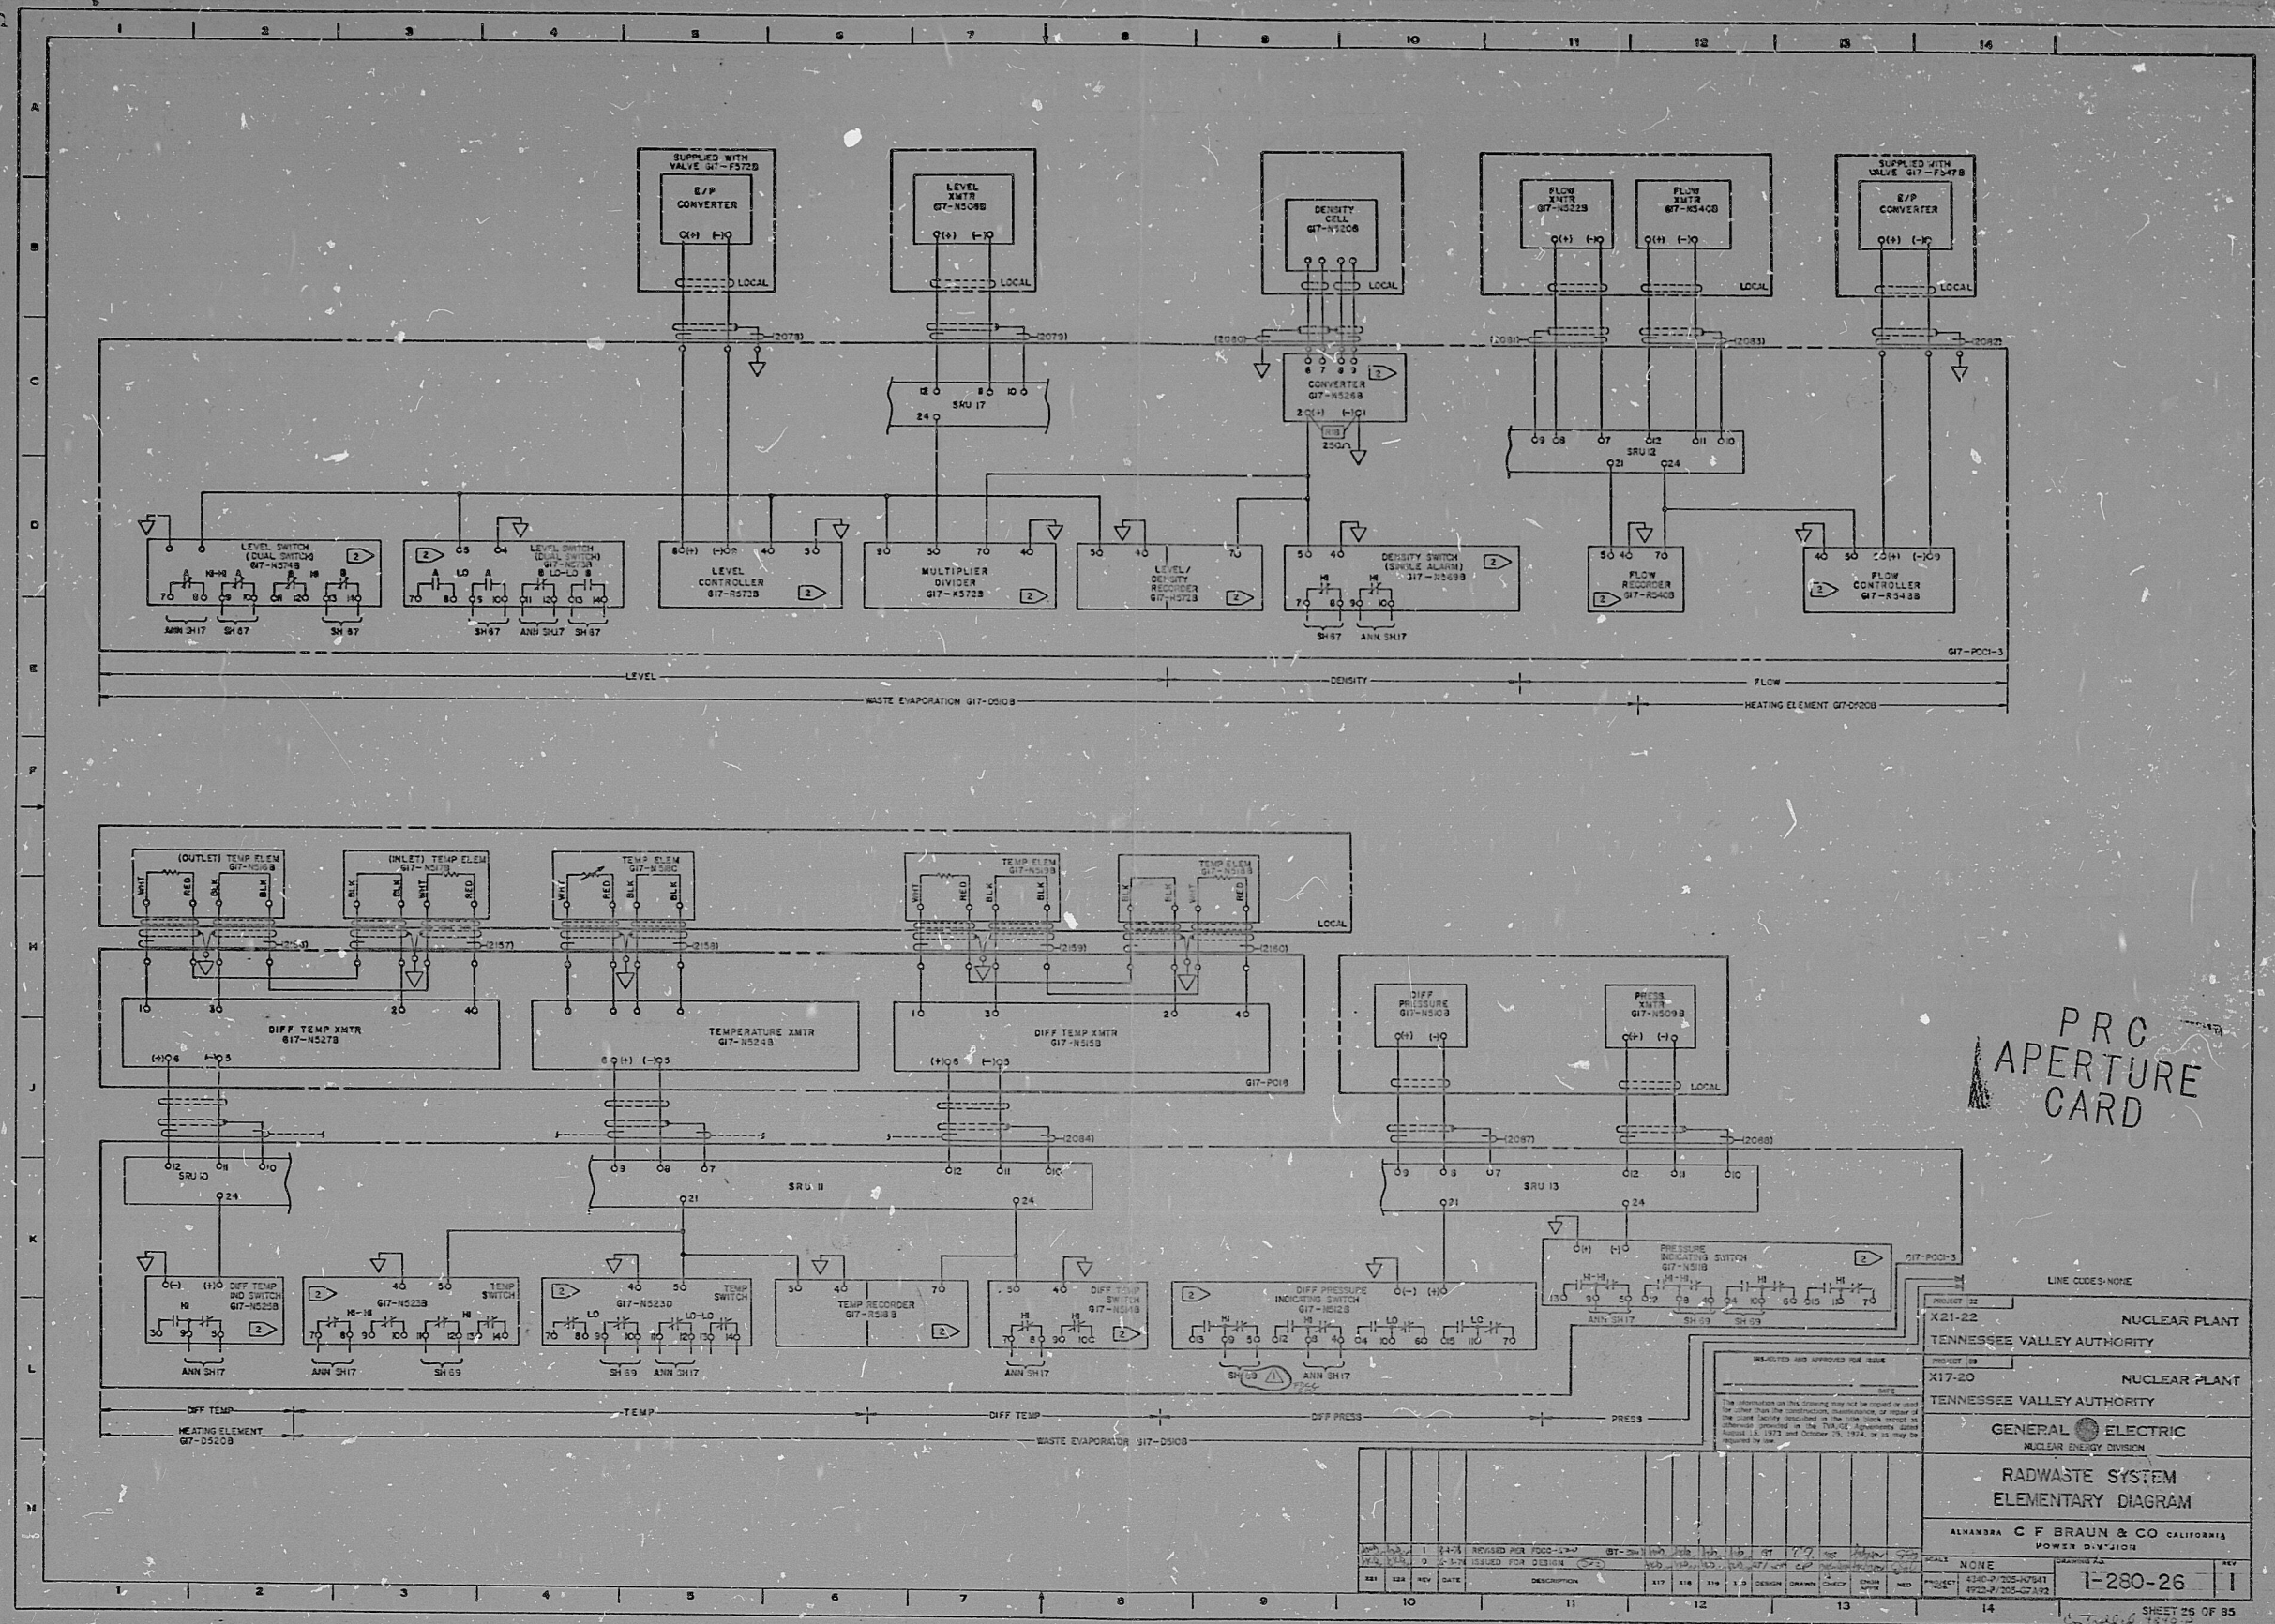

PRC
APERTURE
CARD

LINE CODES: NONE

PROJECT 22	NUCLEAR PLANT
X21-22	NUCLEAR PLANT
PROJECT 18	NUCLEAR PLANT
X17-20	NUCLEAR PLANT
GENERAL ELECTRIC	NUCLEAR ENERGY DIVISION
RADWASTE SYSTEM	
ELEMENTARY DIAGRAM	
ALABAMA C F BRAUN & CO CALIFORNIA	
POWER DIVISION	
SCALE	NONE
PROJECT	4340-7/205-N7541
REV	1-280-26
SHEET 25 OF 85	

RIDS

8206280640

