




RIDS

8309010117

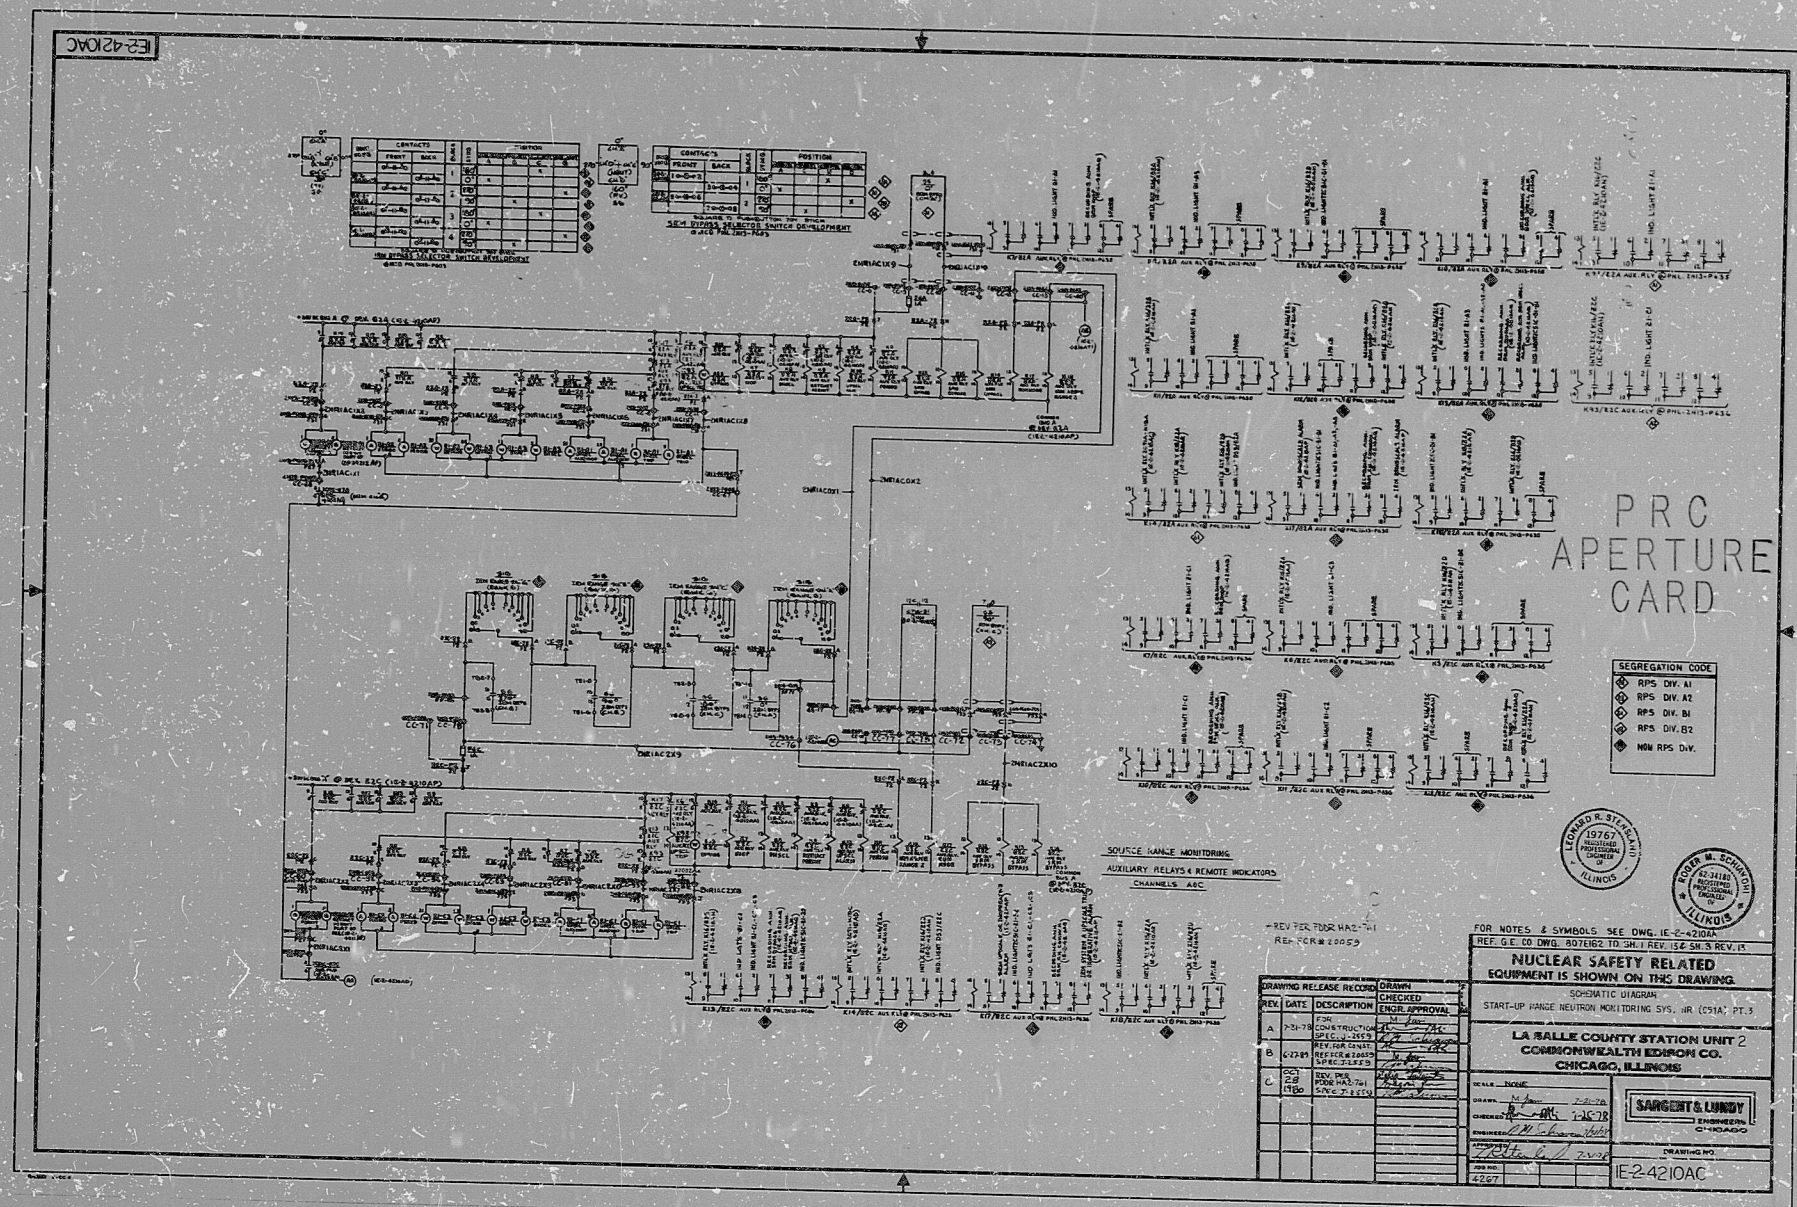