


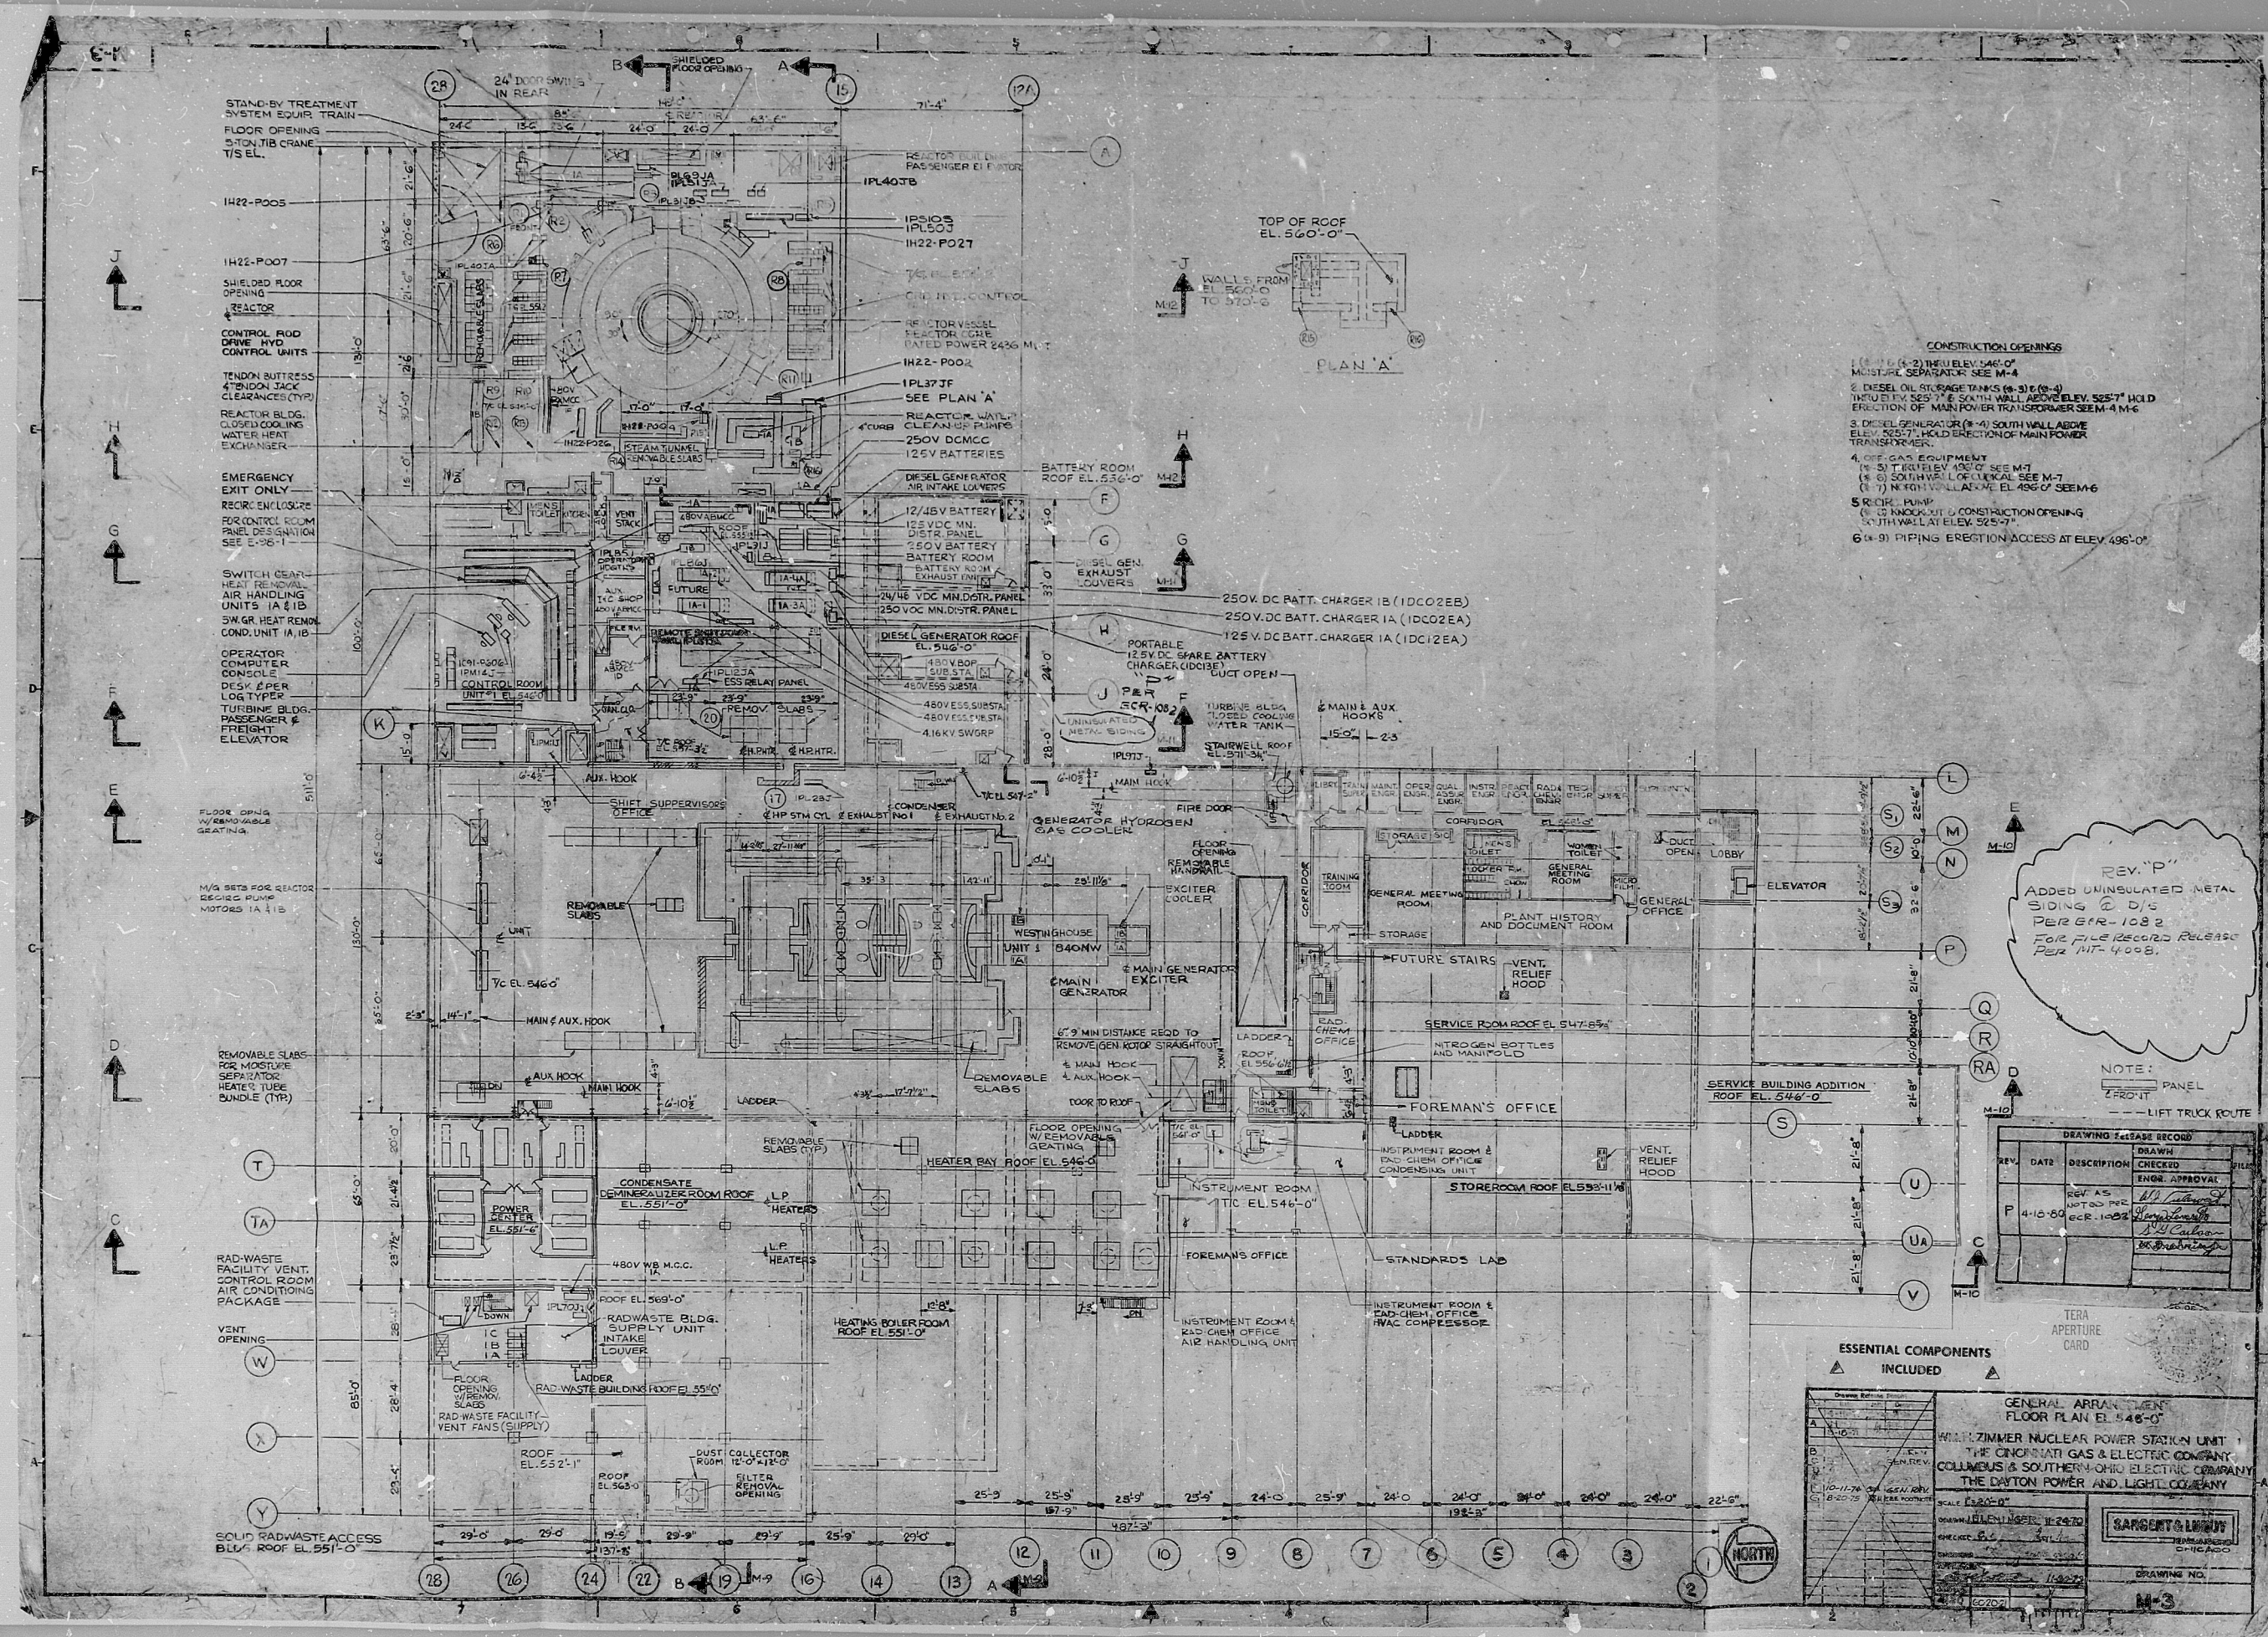

- CONSTRUCTION OPENINGS
- 1. (1) (2) (3) (4) NEW ELEV. 545'-0" MOISTURE SEPARATOR SEE M-4
 - 2. DIESEL OIL STORAGE TANKS (1) (2) (3) (4) NEW ELEV. 525'-7" HOLD ERECTION OF MAIN POWER TRANSFORMER SEE M-4
 - 3. DIESEL GENERATOR (1) (2) SOUTH WALL ABOVE ELEV. 525'-7" HOLD ERECTION OF MAIN POWER TRANSFORMER
 - 4. DIESEL EQUIPMENT (1) (2) (3) 

REV. "P"
ADDED UNINSULATED METAL
SIDING 2 D/S
PER BAR-1082
FOR FILE RECORD RELEASE
PER INT. 4008.

NOTE:
FRONT PANEL
— LIFT TRUCK ROUTE

REV.	DATE	DESCRIPTION	DRAWN	CHECKED	APPROVED

ESSENTIAL COMPONENTS INCLUDED

GENERAL ARRANGEMENT FLOOR PLAN EL 546'-0"

W. H. ZIMMER NUCLEAR POWER STATION UNIT 1
COLUMBUS & SOUTHERN OHIO ELECTRIC COMPANY
THE DAYTON POWER AND LIGHT COMPANY

SCALE: 1/8" = 1'-0"



SARGENT & LUNDY
CHICAGO, ILL.

DRAWING NO. M-3

RIDS-PDR

8104010209

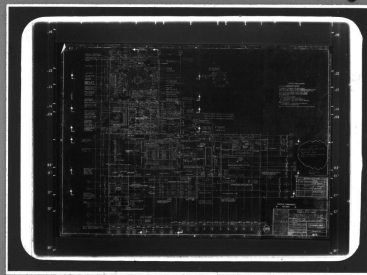

DDAFAC