


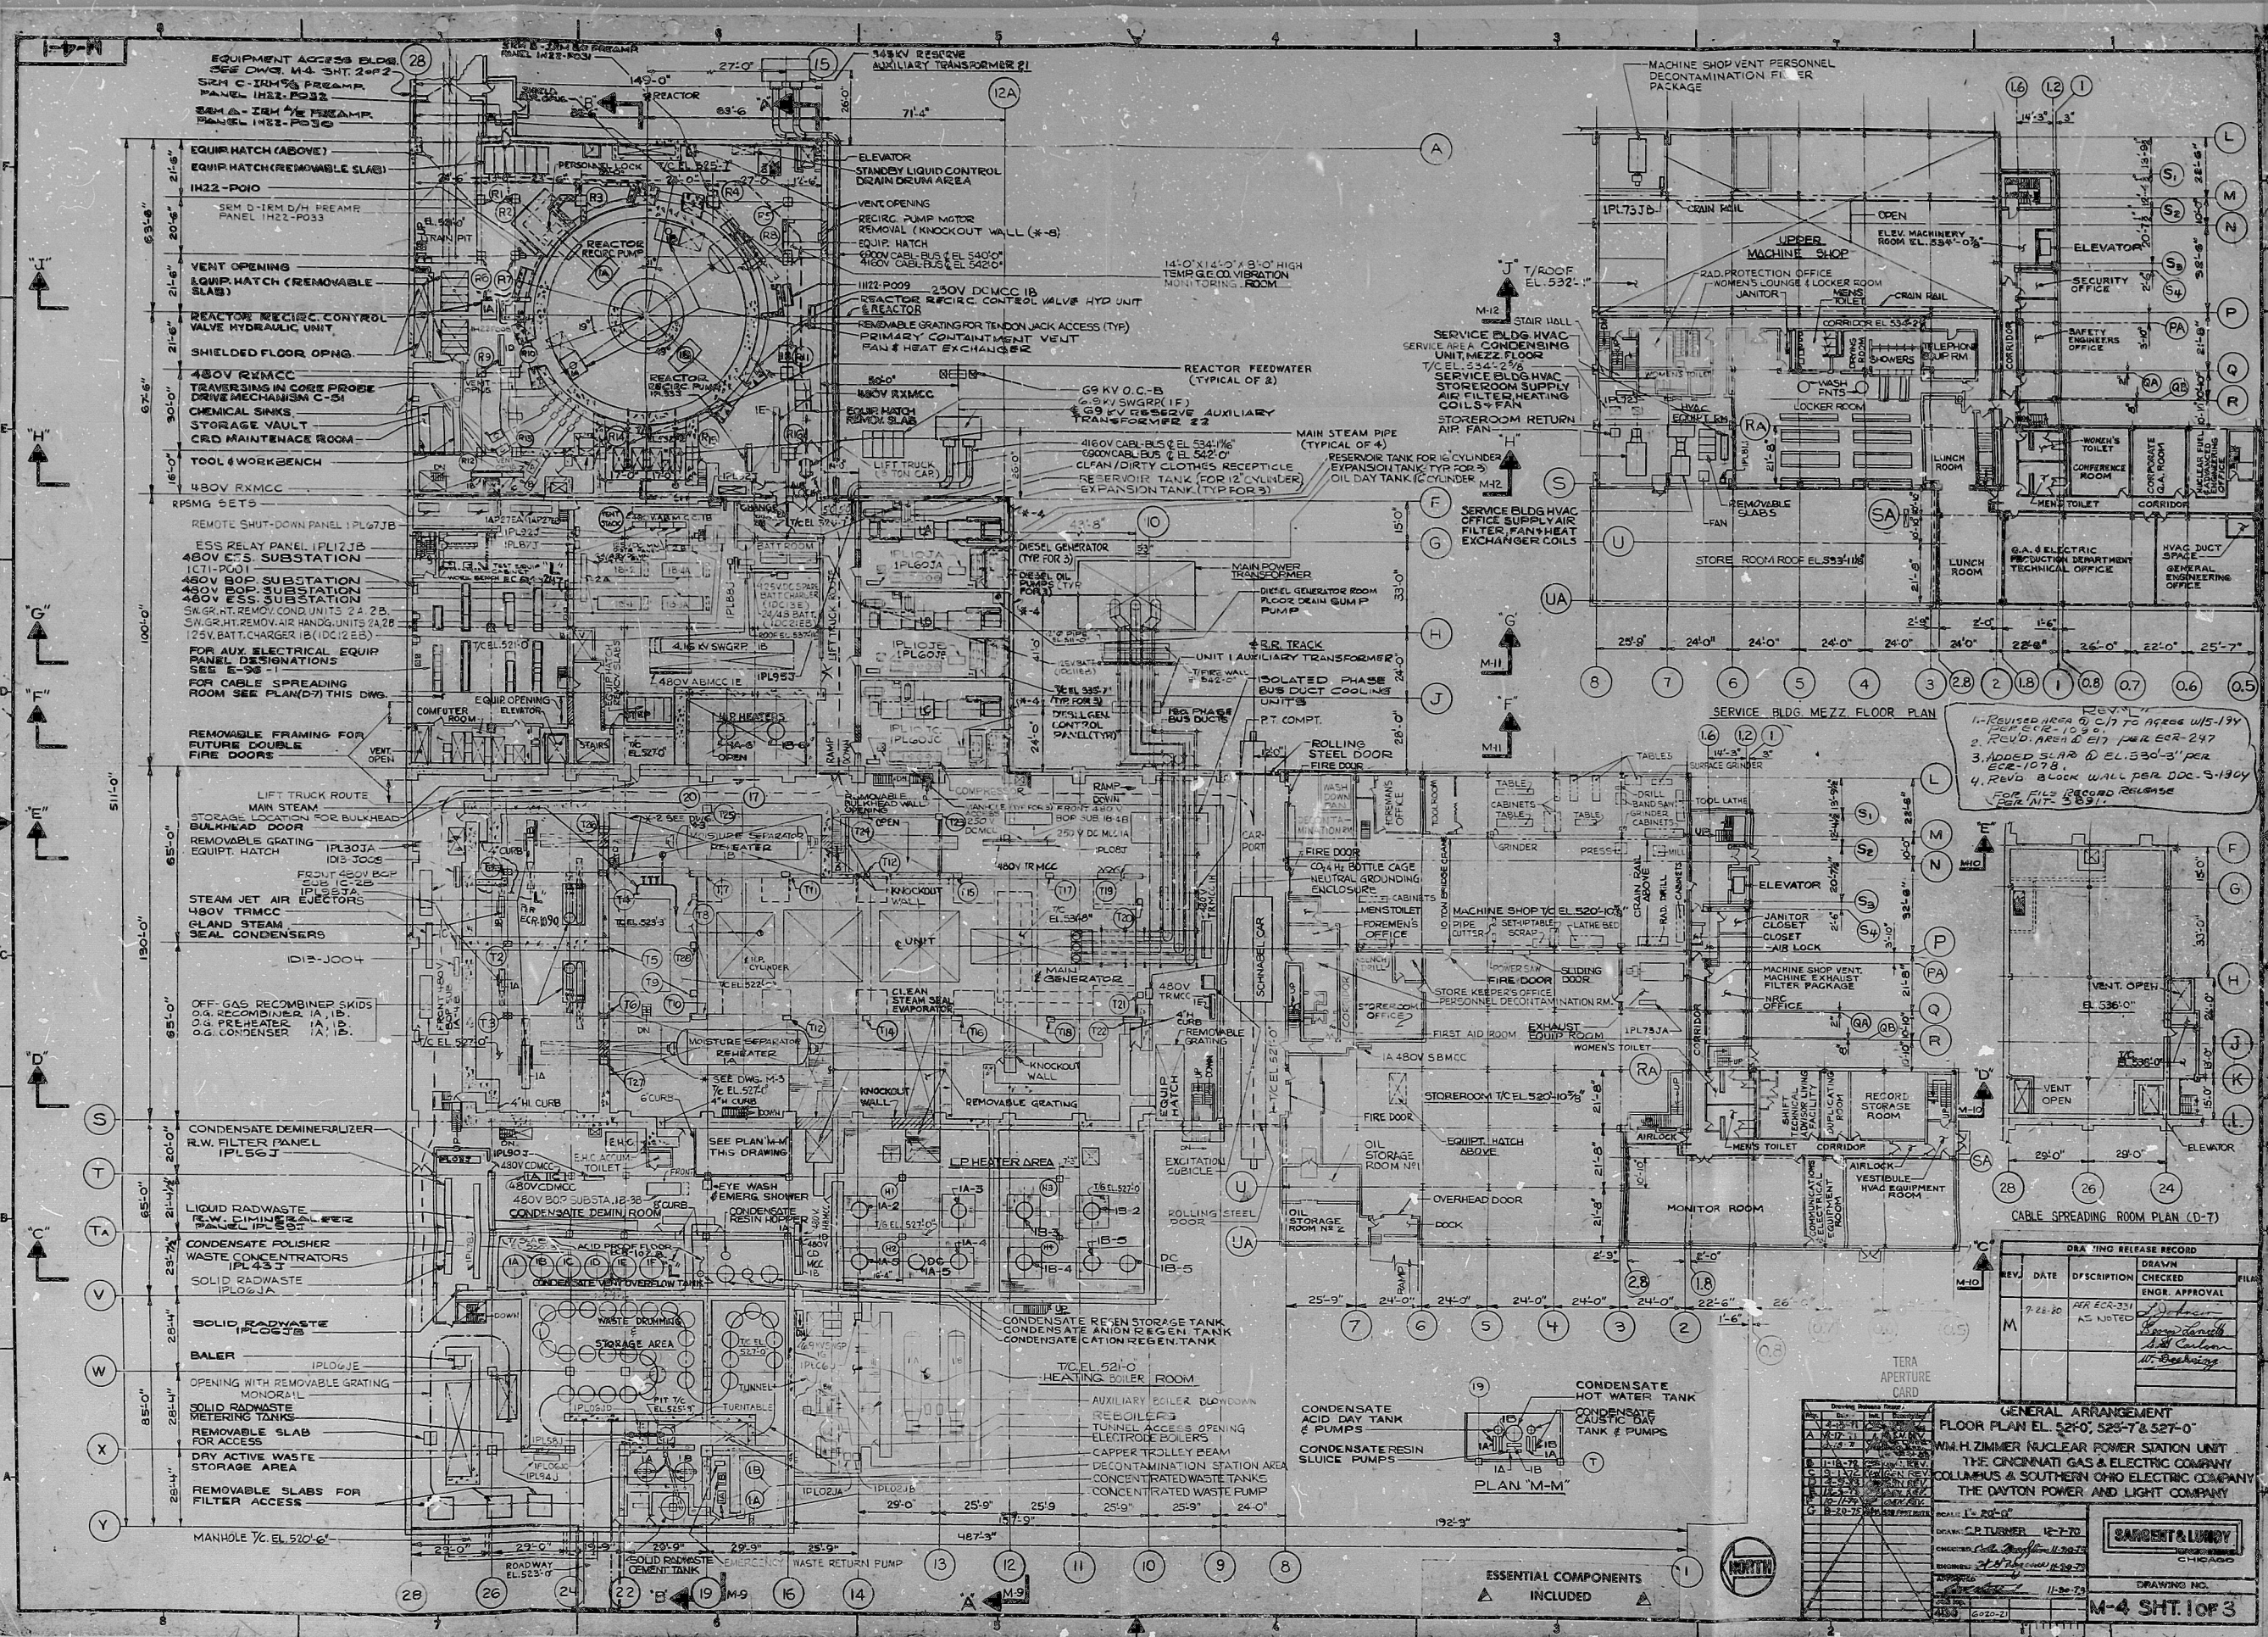

22

















REDS-PDR

8104010218

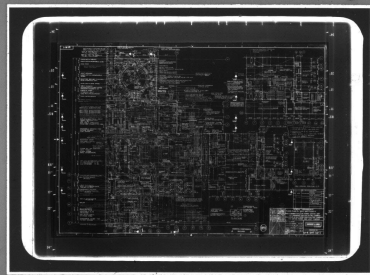

DDAFWC