

106

106

22"

22"

11"

11"

5'8"

5'8"

8.5"

8.5"

11"

11"

17"


17"

22"

22"

34"

34"

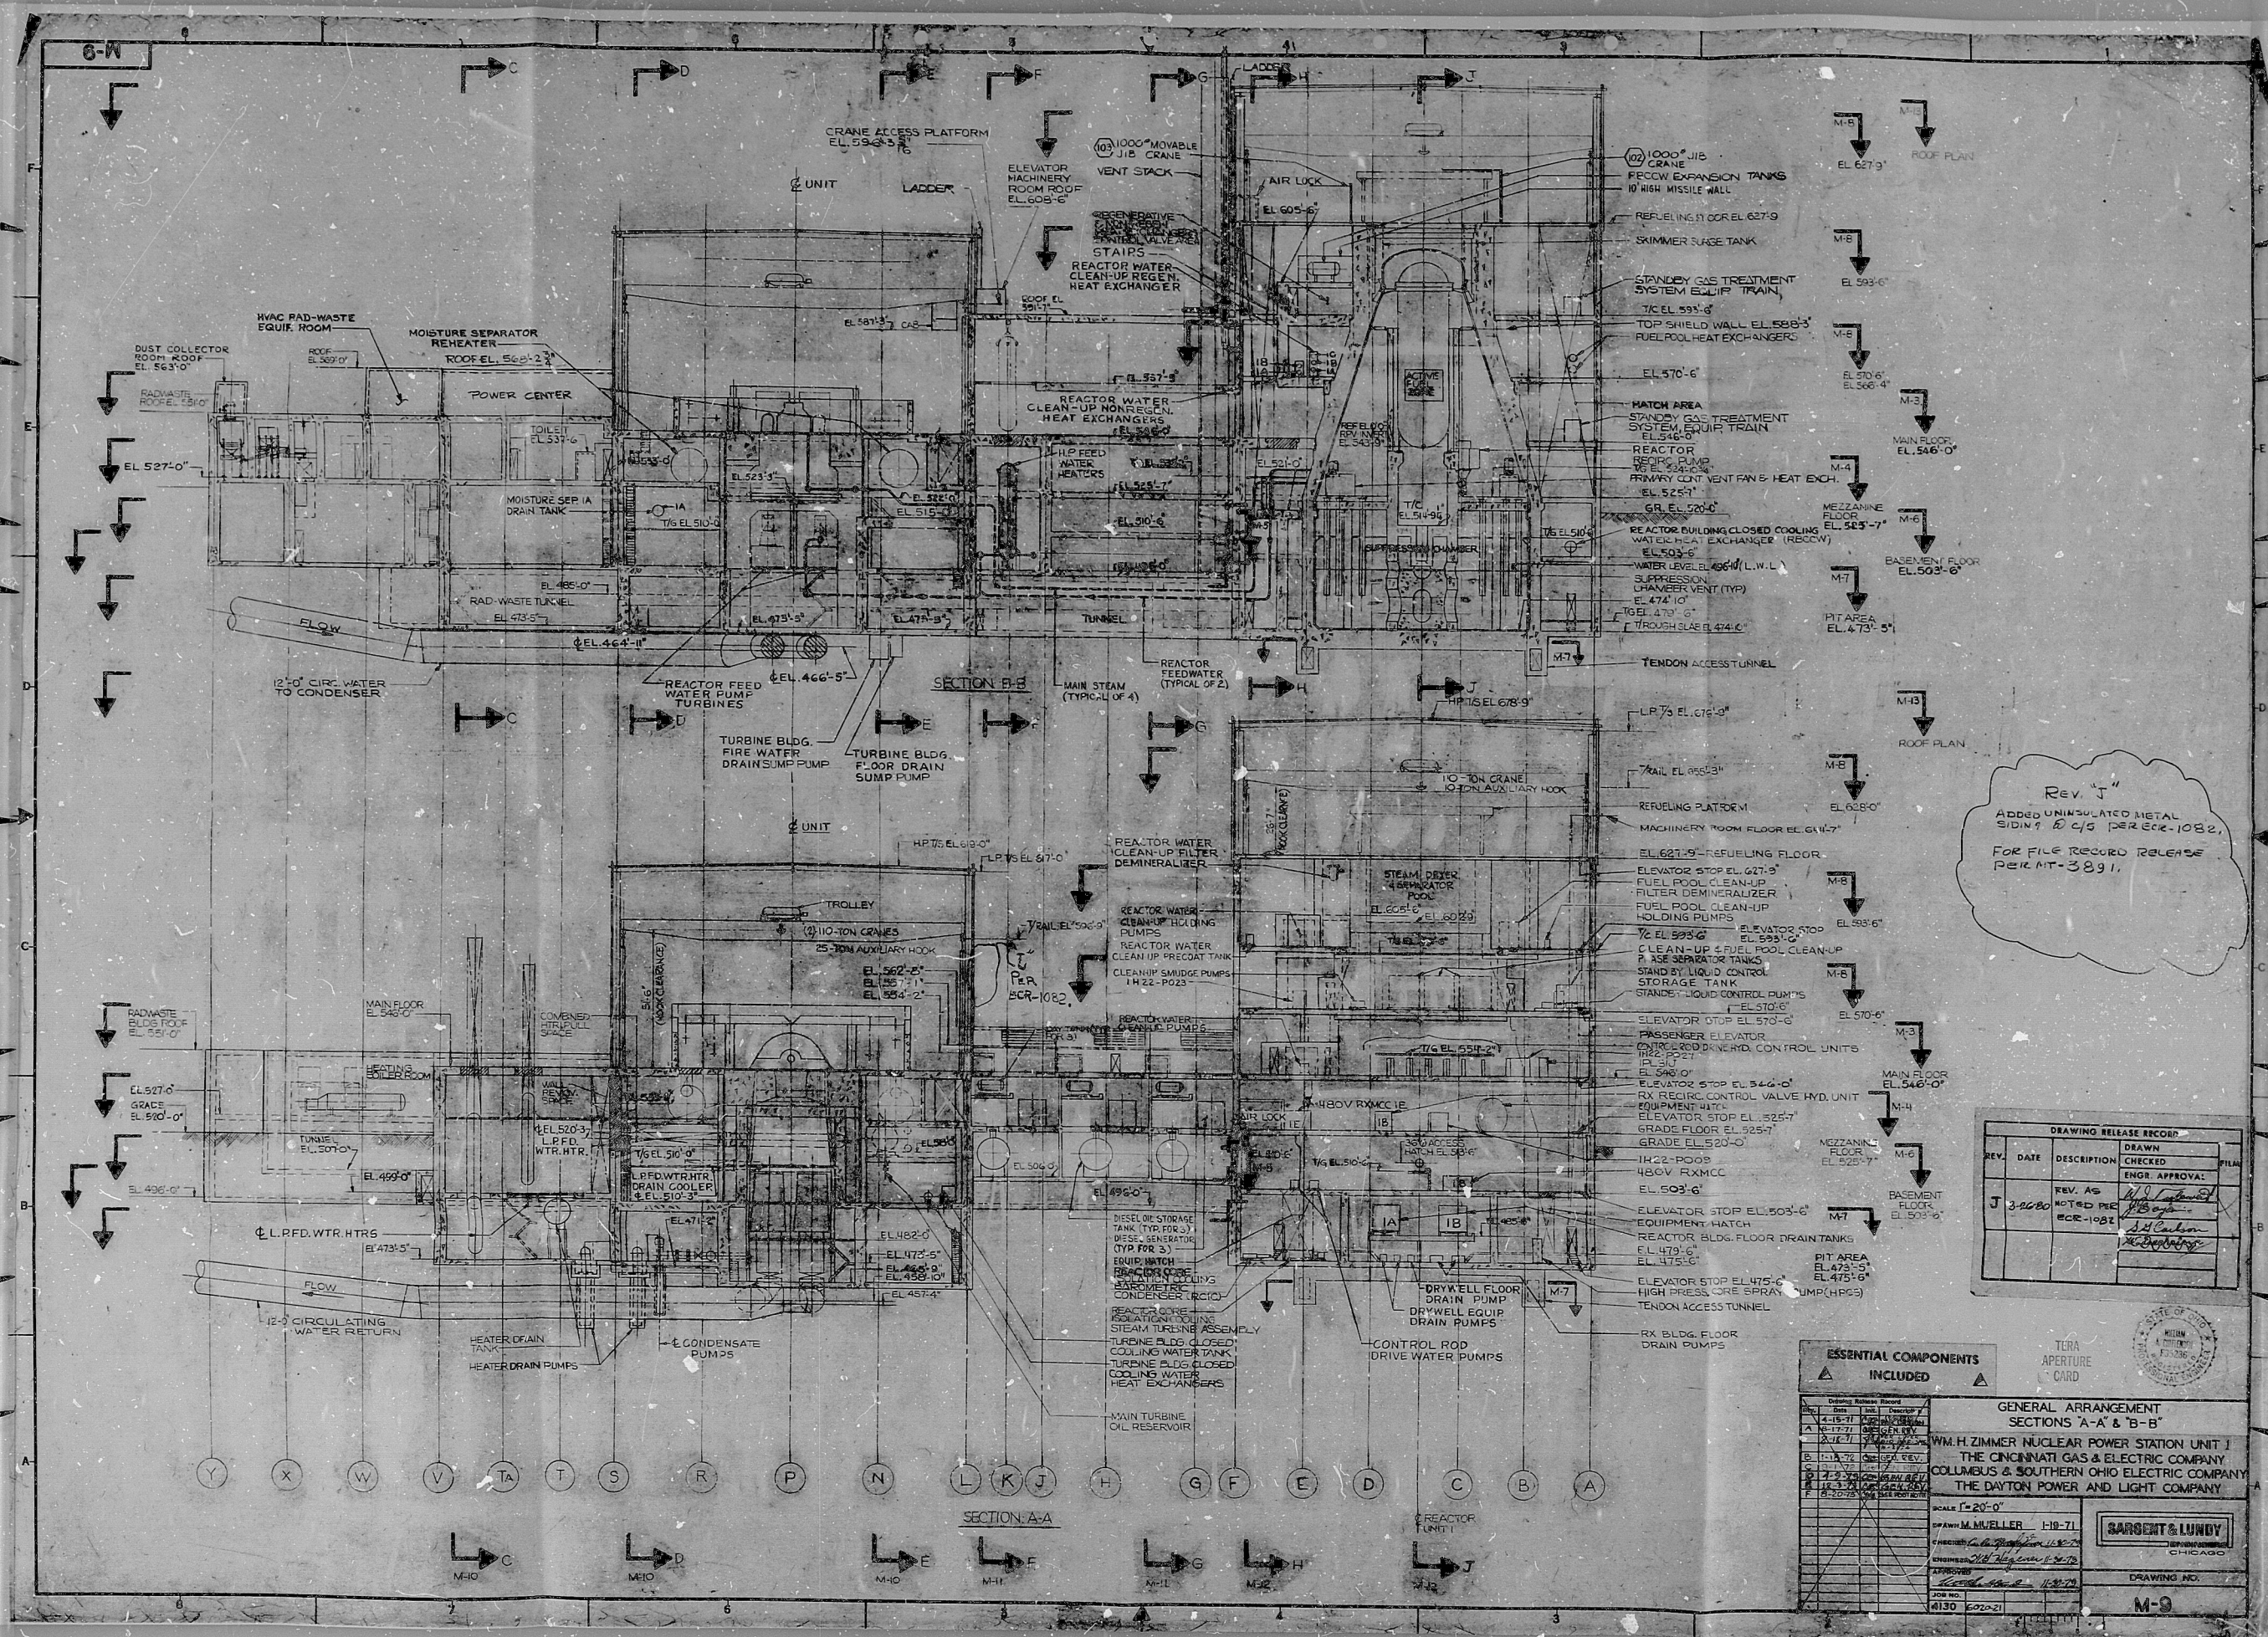

Rev. J
ADDED UNINSULATED METAL
SIDING TO C/S PER ECR-1082.
FOR FILE RECORD RELEASE
PER MIT-3891.

DRAWING RELEASE RECORD				
REV.	DATE	DESCRIPTION	DRAWN	FILED
J	3-26-80	REV. AS NOTED PER ECR-1082	[Signature]	[Signature]

ESSENTIAL COMPONENTS INCLUDED


GENERAL ARRANGEMENT SECTIONS A-A & B-B

WM. H. ZIMMER NUCLEAR POWER STATION UNIT 1
THE CINCINNATI GAS & ELECTRIC COMPANY
COLUMBUS & SOUTHERN OHIO ELECTRIC COMPANY
THE DAYTON POWER AND LIGHT COMPANY

SCALE: 1" = 20'-0"

DESIGNED BY: M. MUELLER, H-10-71
CHECKED BY: [Signature]
APPROVED BY: [Signature]
DATE: 1-18-78

SARGENT & LUNDY
CHICAGO, ILL.

DRAWING NO. M-9

RDS-PDR

8104010230

