


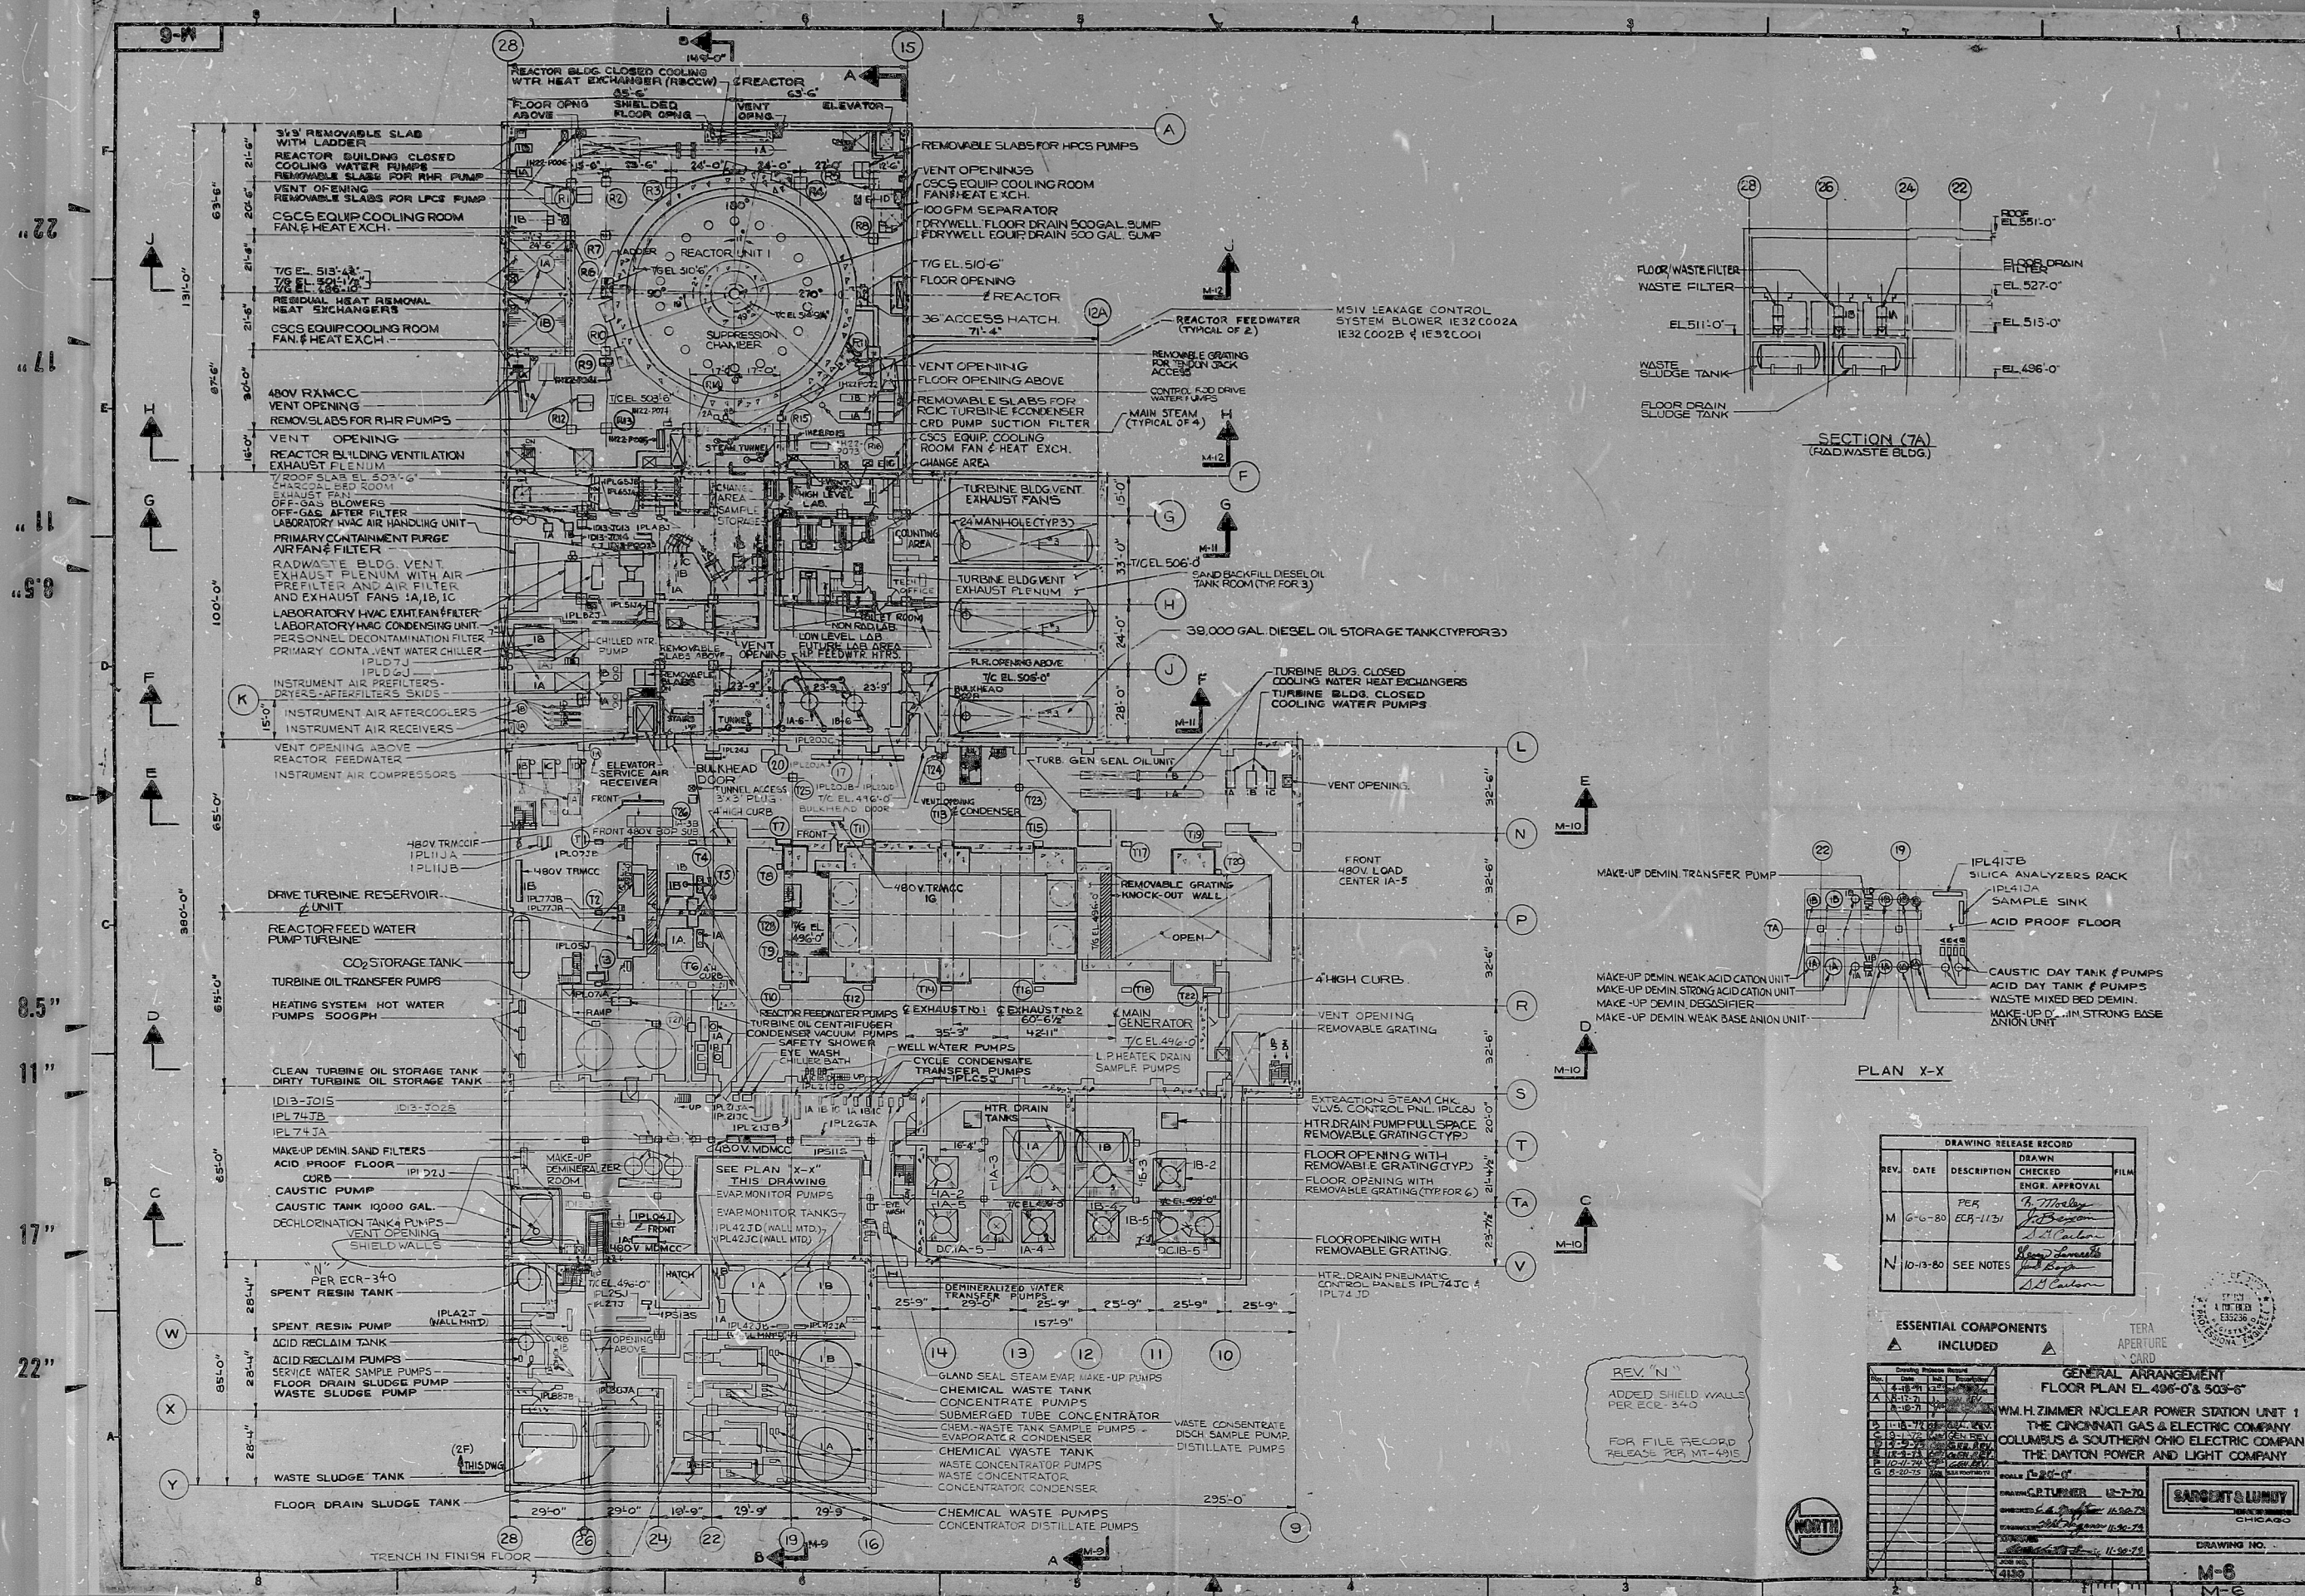

DEDS-PDR

8104010243

