


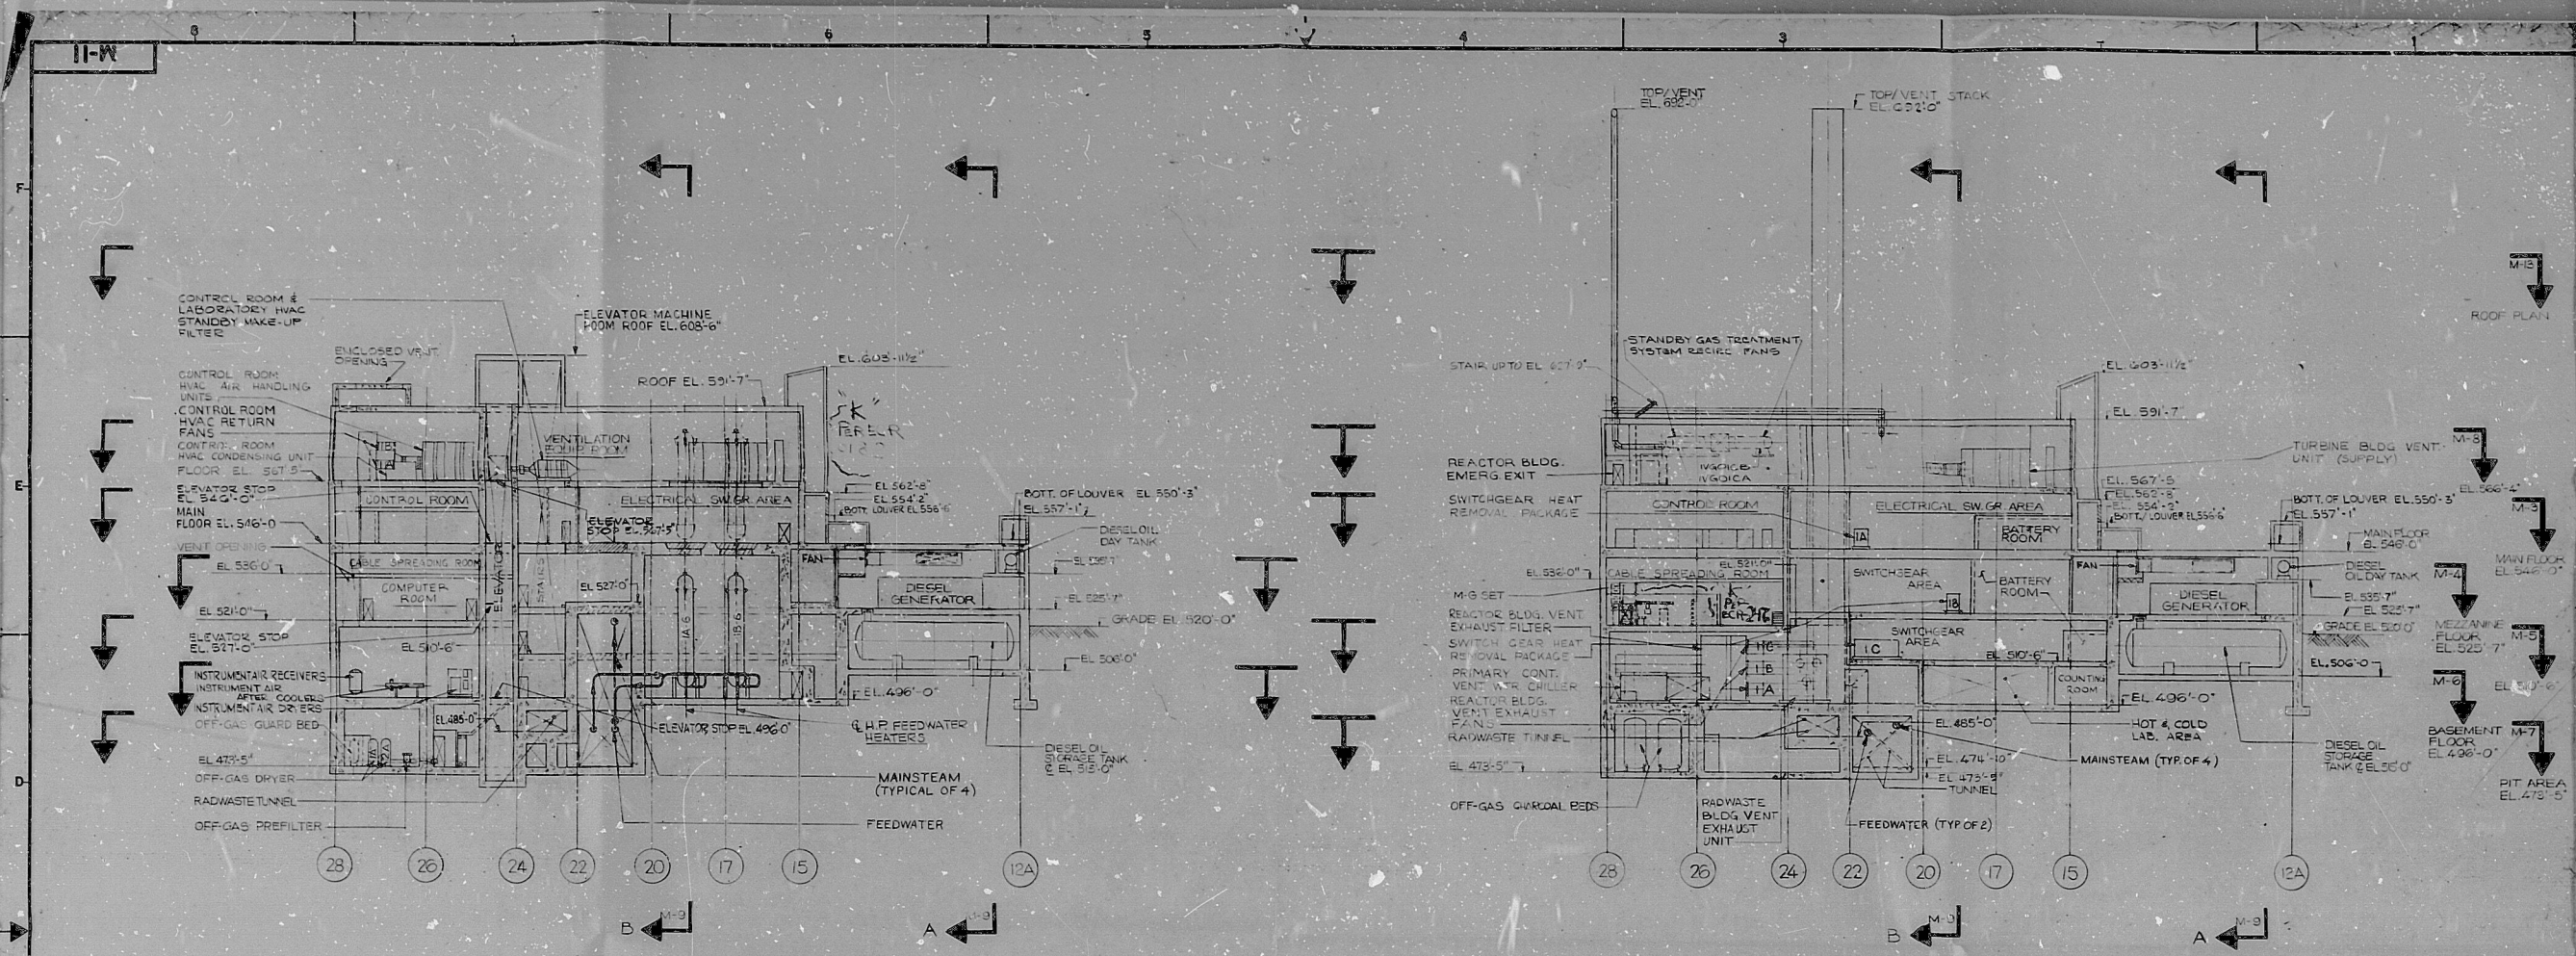

Rev. "K"
 REV. AREA 2 E/B PER ECR-247
 2. ADDED AIR INTAKE ENCLOSURE
 ROOF @ E/7 PER ECR-1082.
 FOR FILE RECORD RELEASE
 PER MT-3891.

DRAWING RELEASE RECORD			
REV.	DATE	DESCRIPTION	FILED
		DRAWN	
		CHKD	
		ENGR. APPROVAL	
K	3-26-81	AS NOTED ECR-1082	

12-27-77 ECR-1082		TERA APERTURE CARD GENERAL ARRANGEMENT SECTIONS F-F & G-G WM. H. ZIMMER NUCLEAR POWER STATION UNIT 1 THE CINCINNATI GAS & ELECTRIC COMPANY COLUMBUS & SOUTHERN OHIO ELECTRIC COMPANY THE DAYTON POWER AND LIGHT COMPANY
SCALE 1/8"=1'-0" DRAWN J. SISON CHECKED J. A. LUNDY ENGINEER J. A. LUNDY DATE 11-30-77 JOB NO. 4130	SARGENT & LUNDY CHICAGO, ILL. DRAWING NO. M-11 M-11	

RDS-QIR

8104010248

