


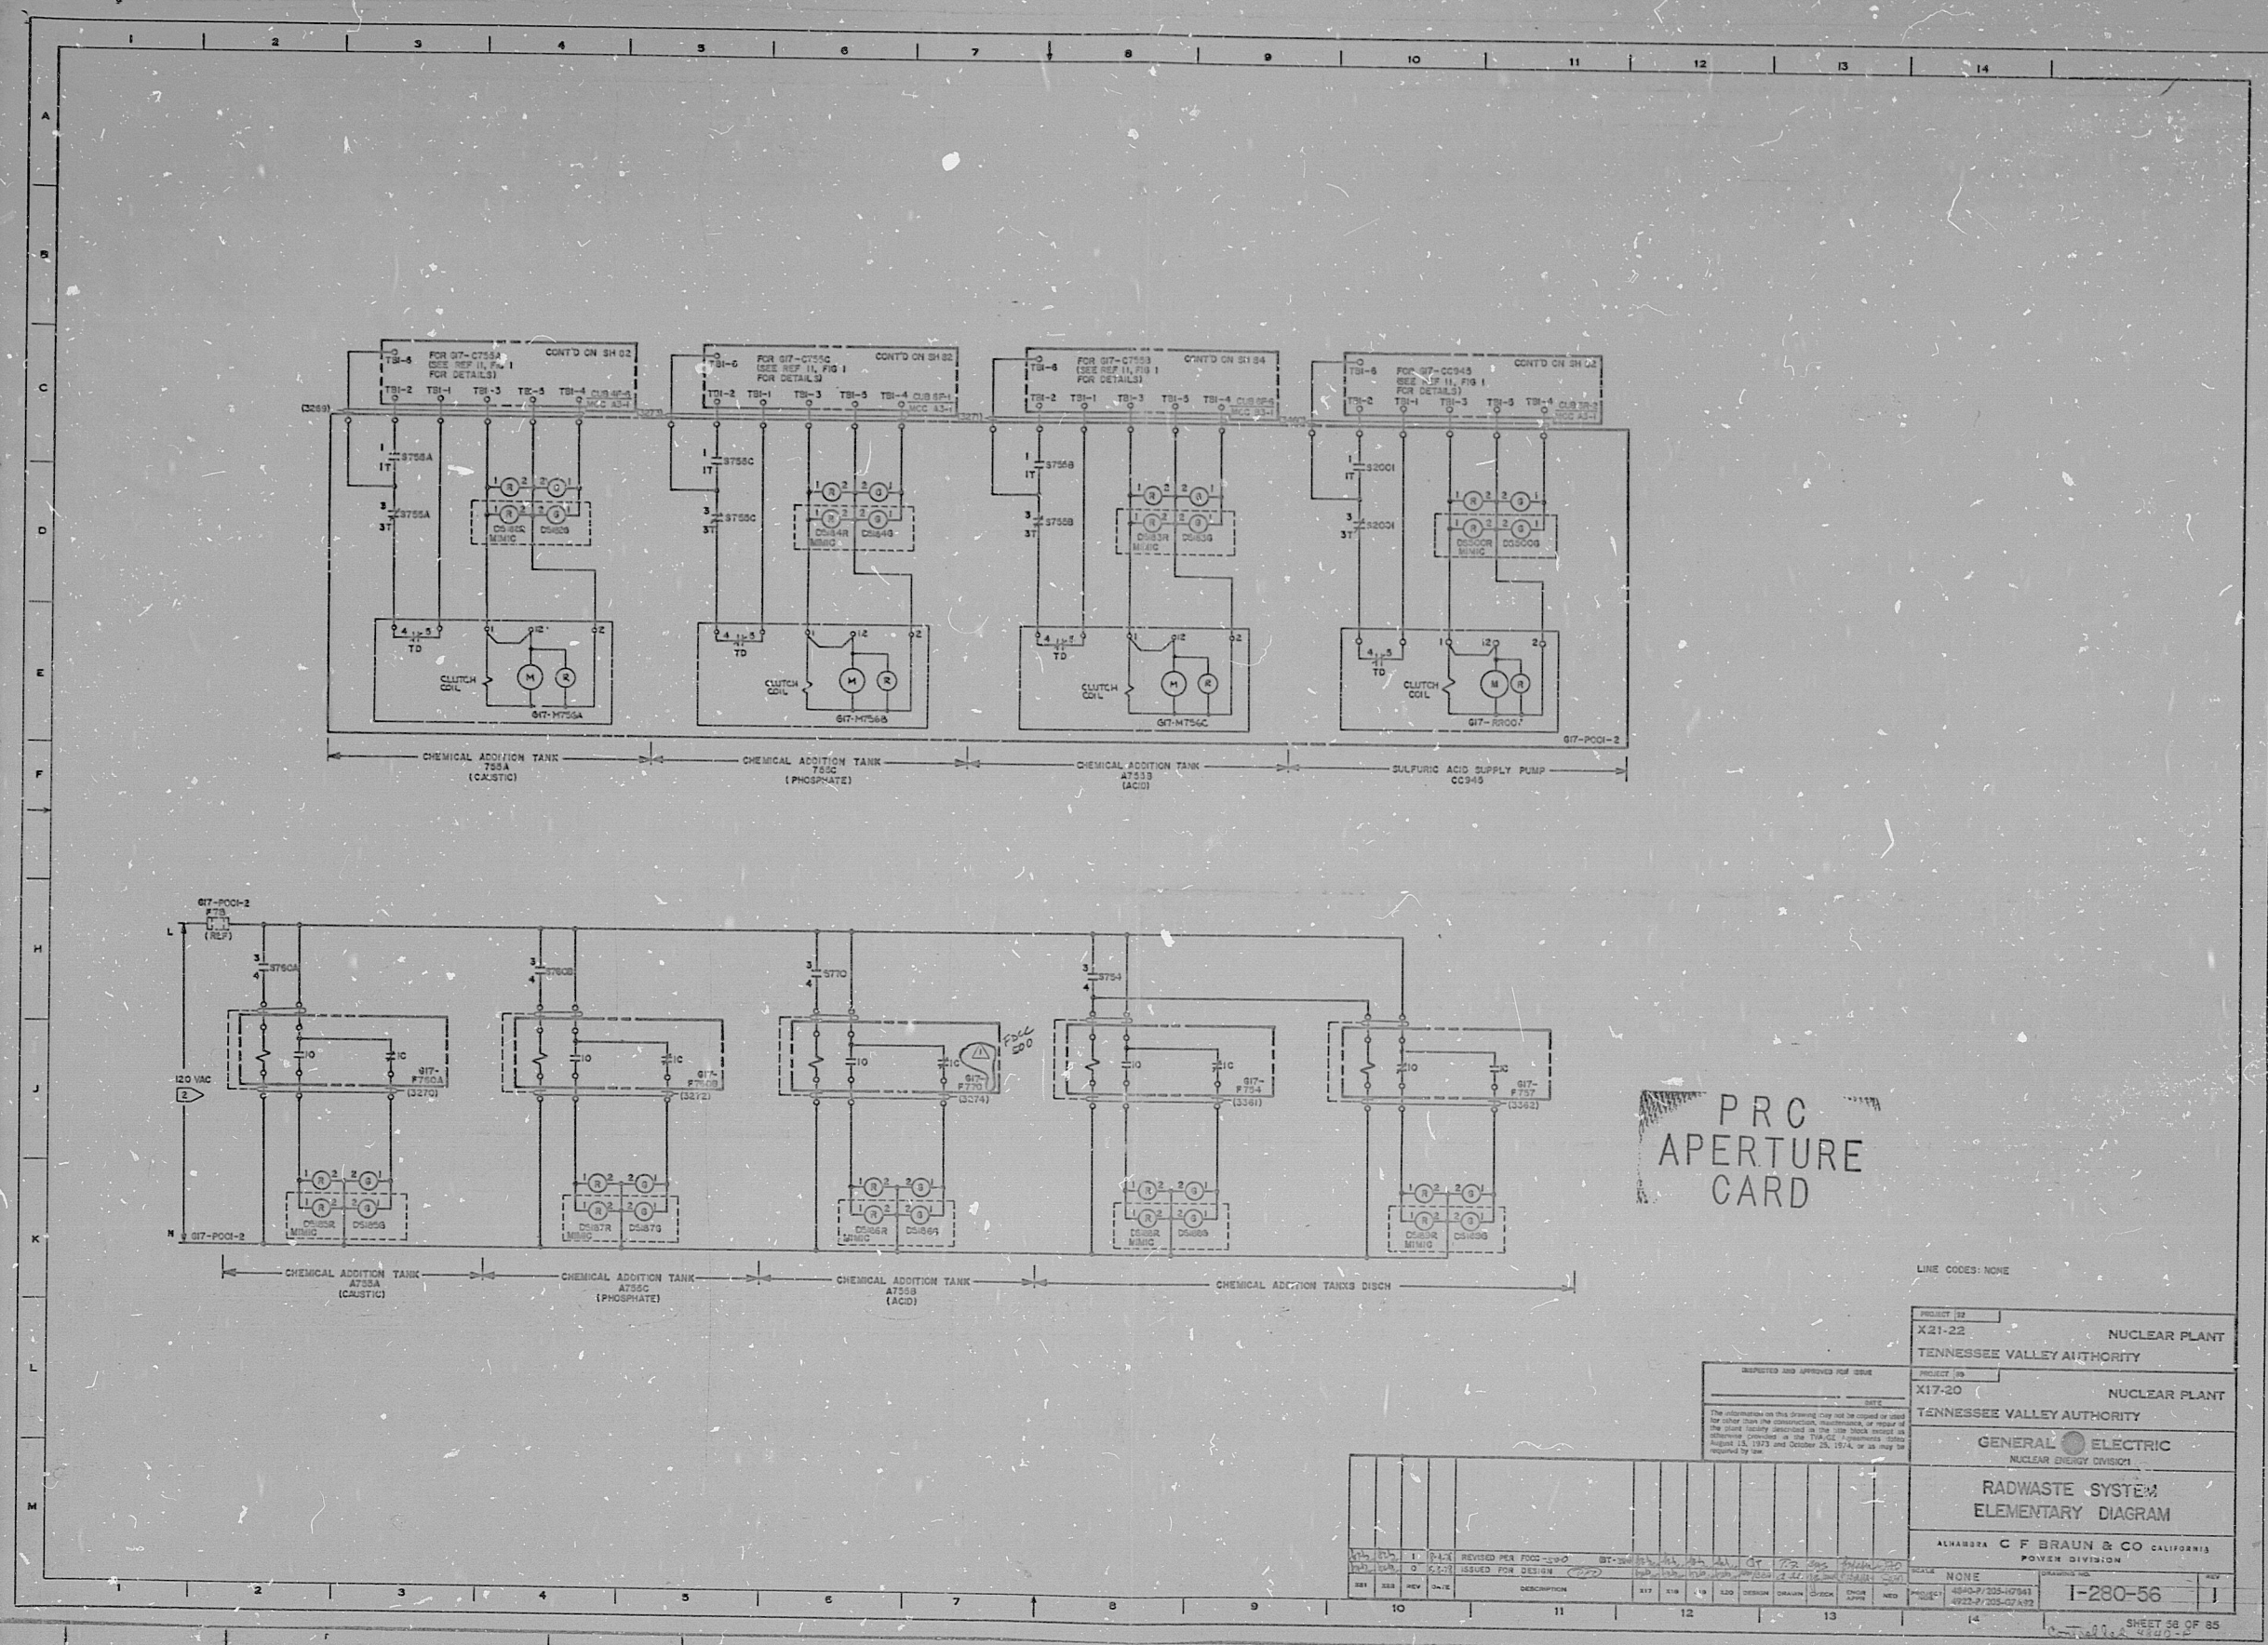



RIDS

8206290054

