


This drawing and the design it covers are the property of BECHTEL. They are hereby loaned and on the borrower's express agreement that they will not be reproduced, copied, loaned, exhibited, or used except in the private use permitted by any written consent given by the lender to the borrower.

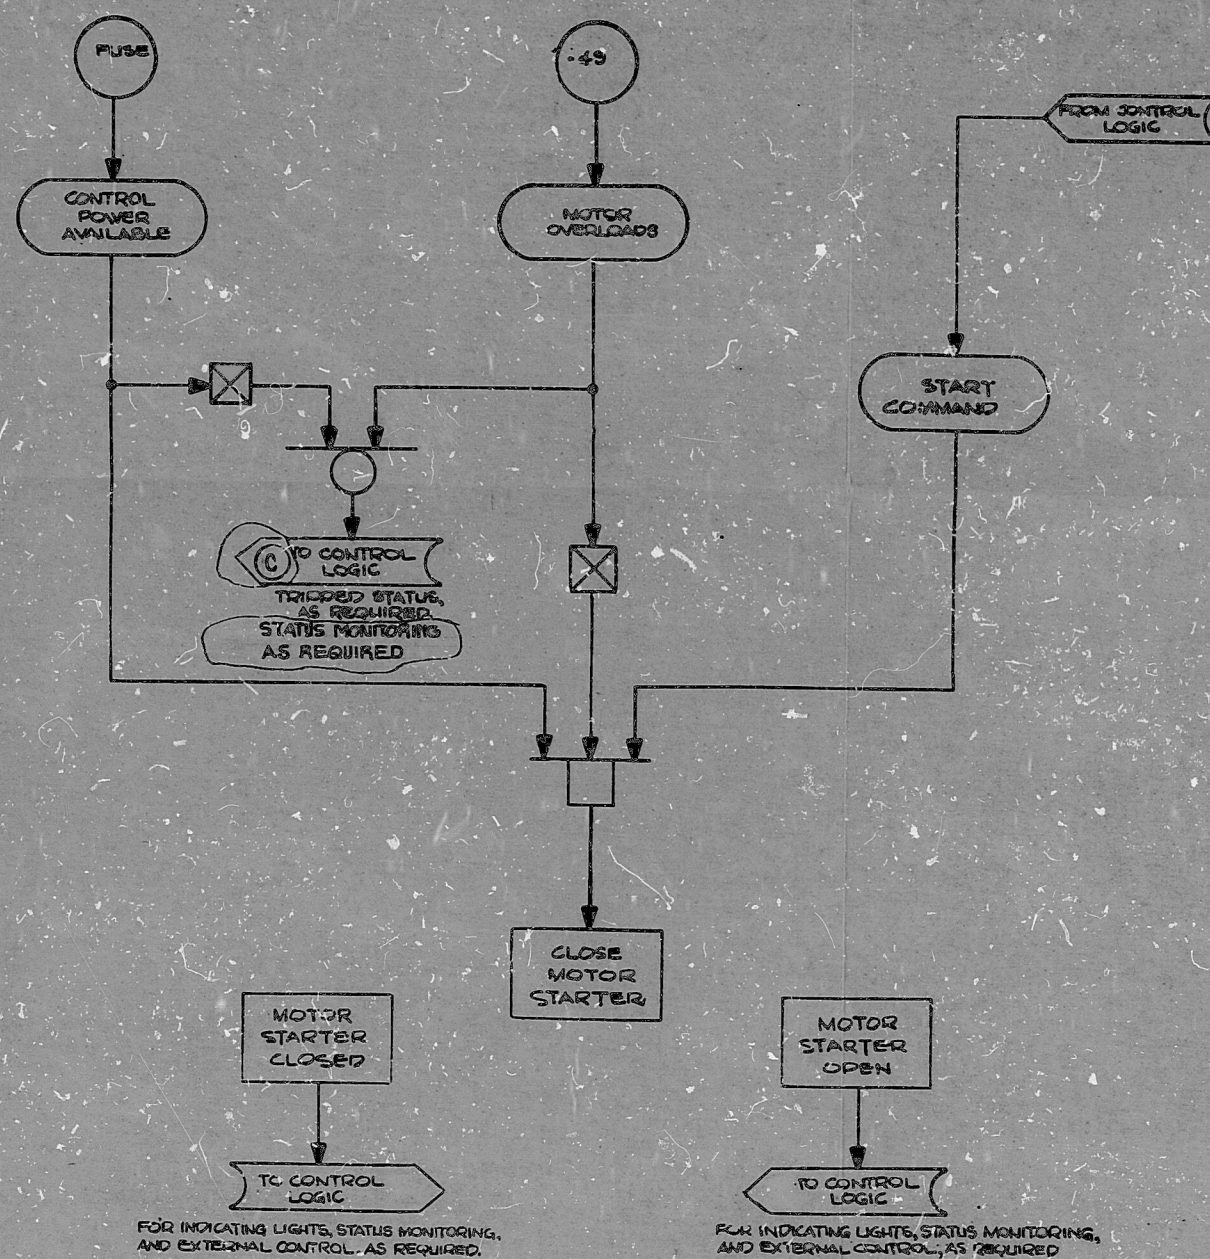

TI
APERTURE
CARD

HOUSTON OFFICE ISSUED
INFORMATION ONLY
STP 14926

Reference Drawings:
1) Logic Symbols: 7-2-40410, 7-2-40411

GENERAL NOTE:
THIS DRAWING REPRESENTS FUNCTIONAL REQUIREMENTS ONLY.

THIS DWG. SUPERSEDES B & A DWG. 52-01-1-Z-2941, SHT. 1, REV. F															NUCLEAR SAFETY RELATED					Q
BECHTEL POWER CORPORATION HOUSTON, TEXAS															REFERENCE LOGIC DIAGRAM MCC STARTER CONTROL					
HOUSTON LIGHTING & POWER CO. SOUTH TEXAS PROJECT															SCALE	JOB NO.	DRAWING NO.	REV.		
CHIEF ENGR. <i>M. M. M.</i>															NONE	14926	42-01-9-Z-40405	Q		

THIS DWG. SUPERSEDES B&A
DWG. 52-01-1-Z-2941, SHT. 1, REV. F

BECHTEL POWER CORPORATION
HOUSTON, TEXAS

HOUSTON LIGHTING & POWER CO.
SOUTH TEXAS PROJECT

SCALE: NONE
JOB NO.: 14926
DRAWING NO.: 42-01-9-Z-40405
REV.: 1

PDR RIDS

950605054L

