


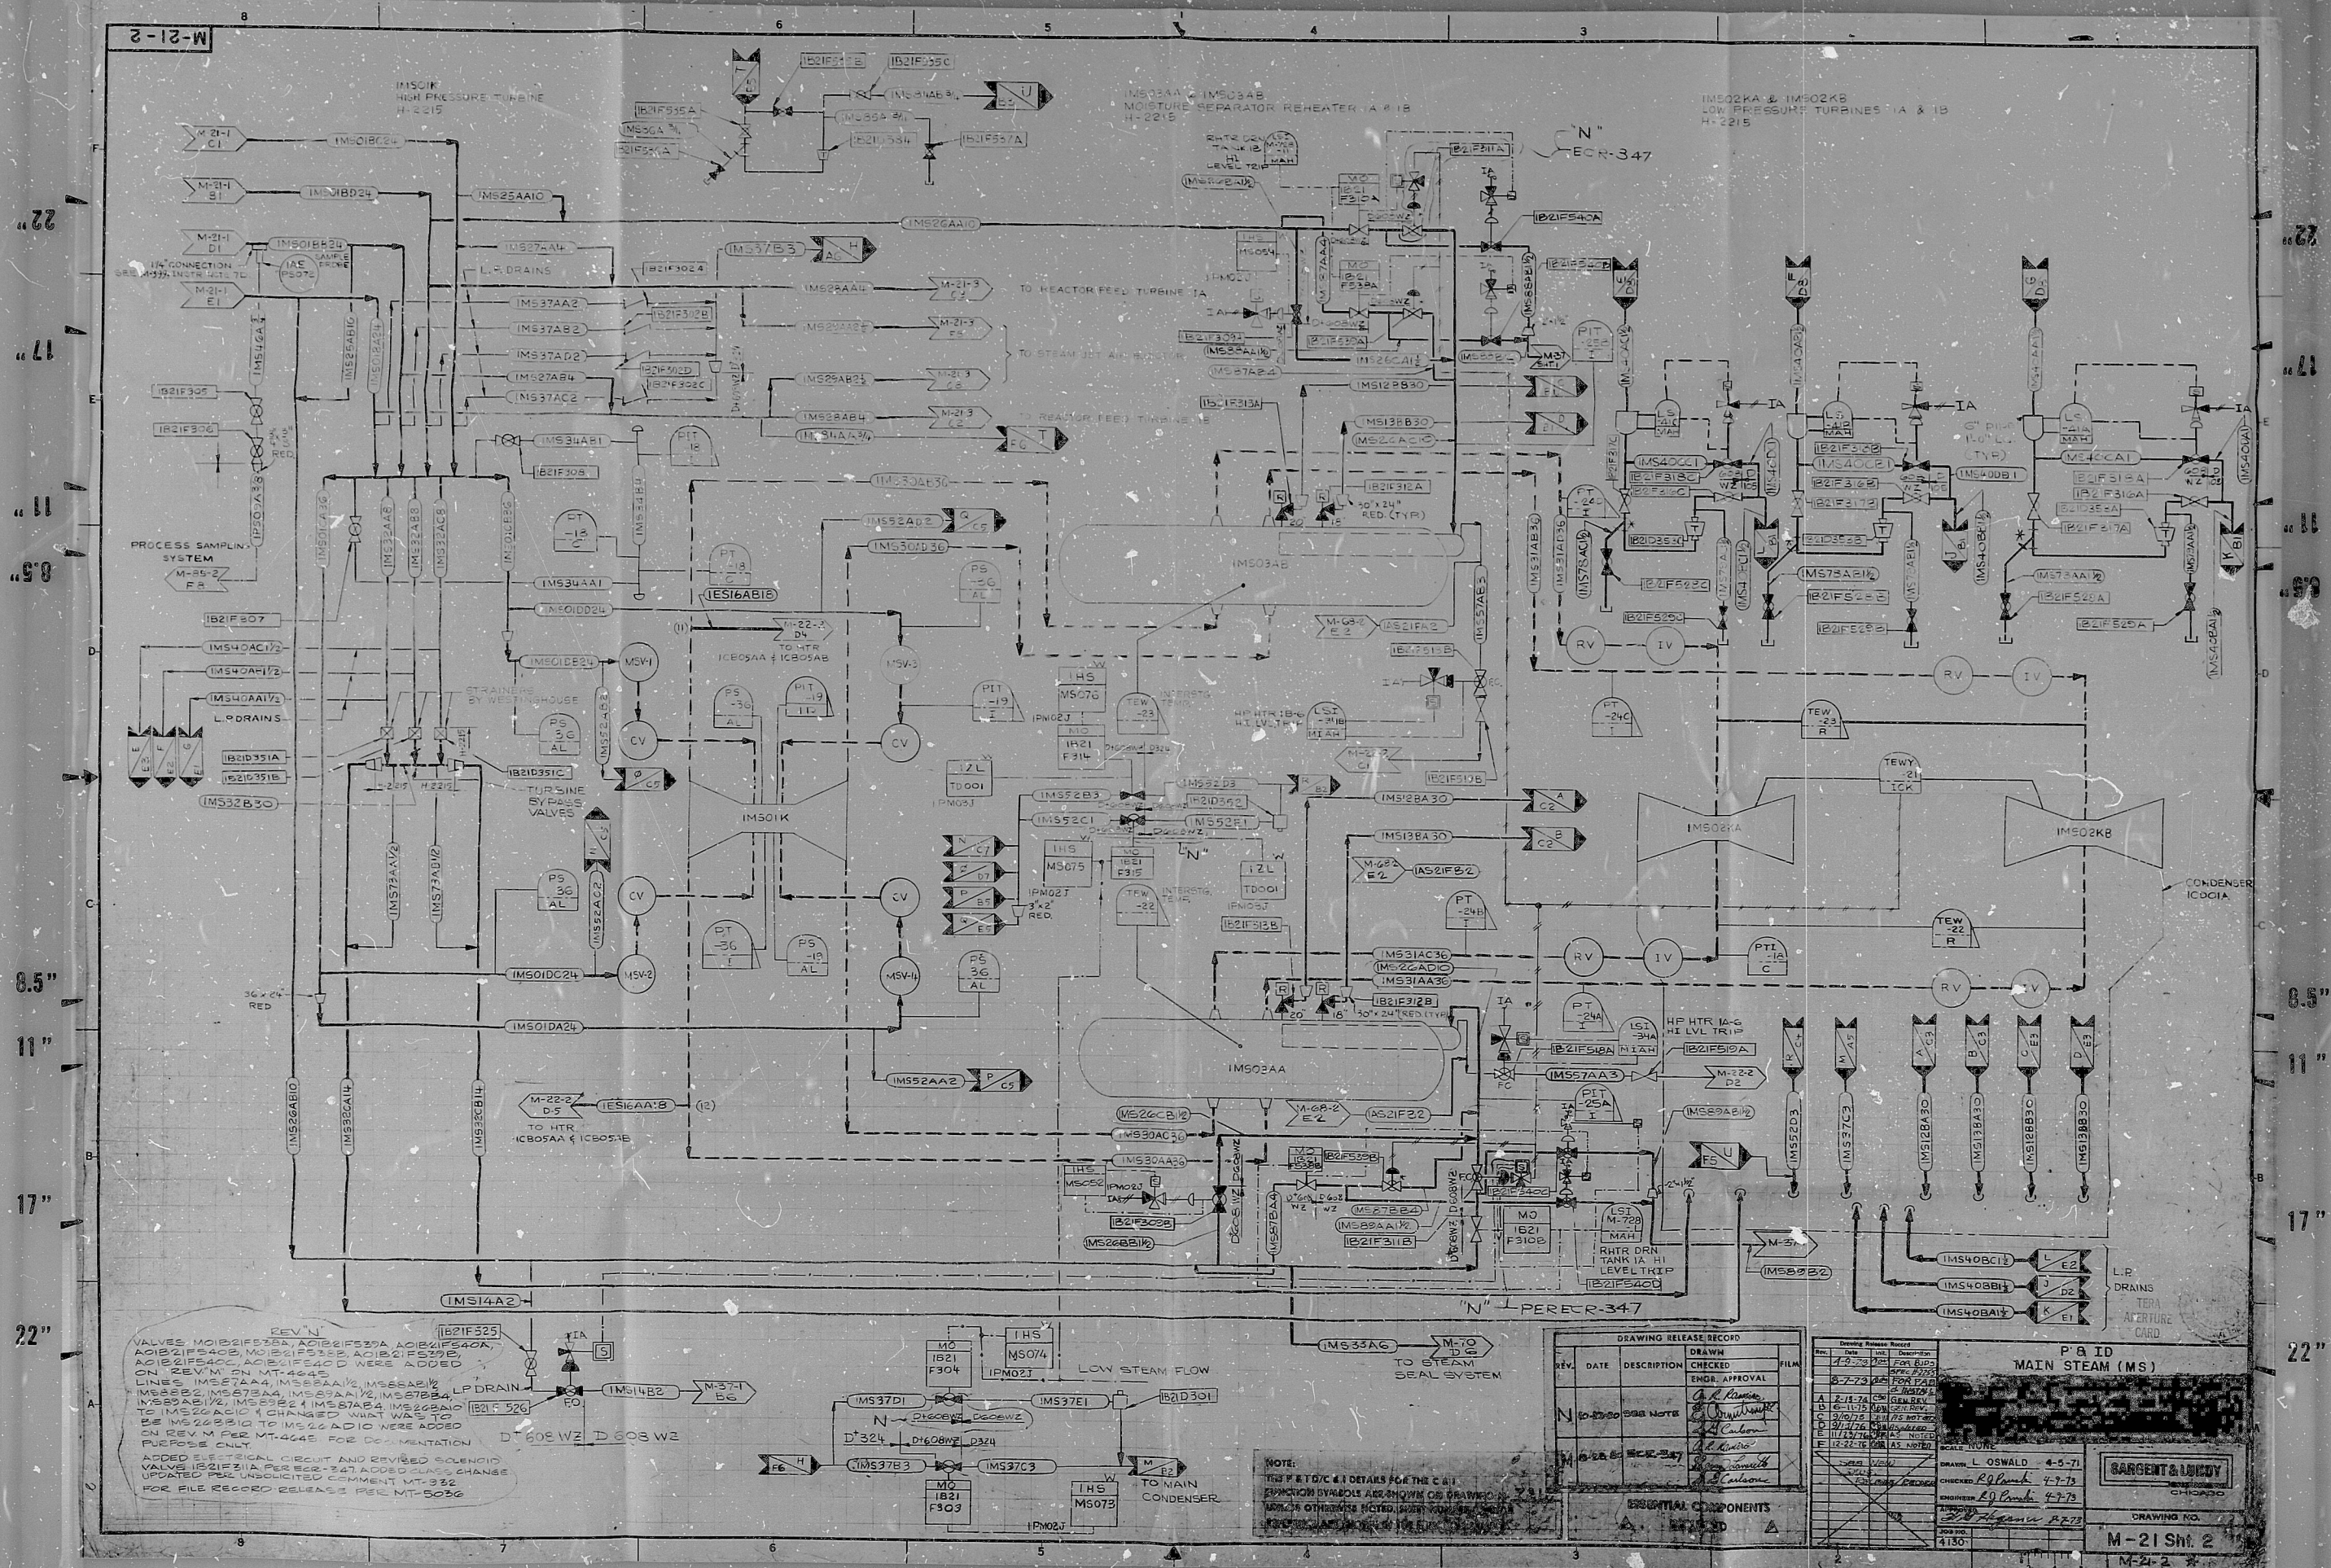

RIDS-PDR

8104010287

