




REDS-PDR

8104010297

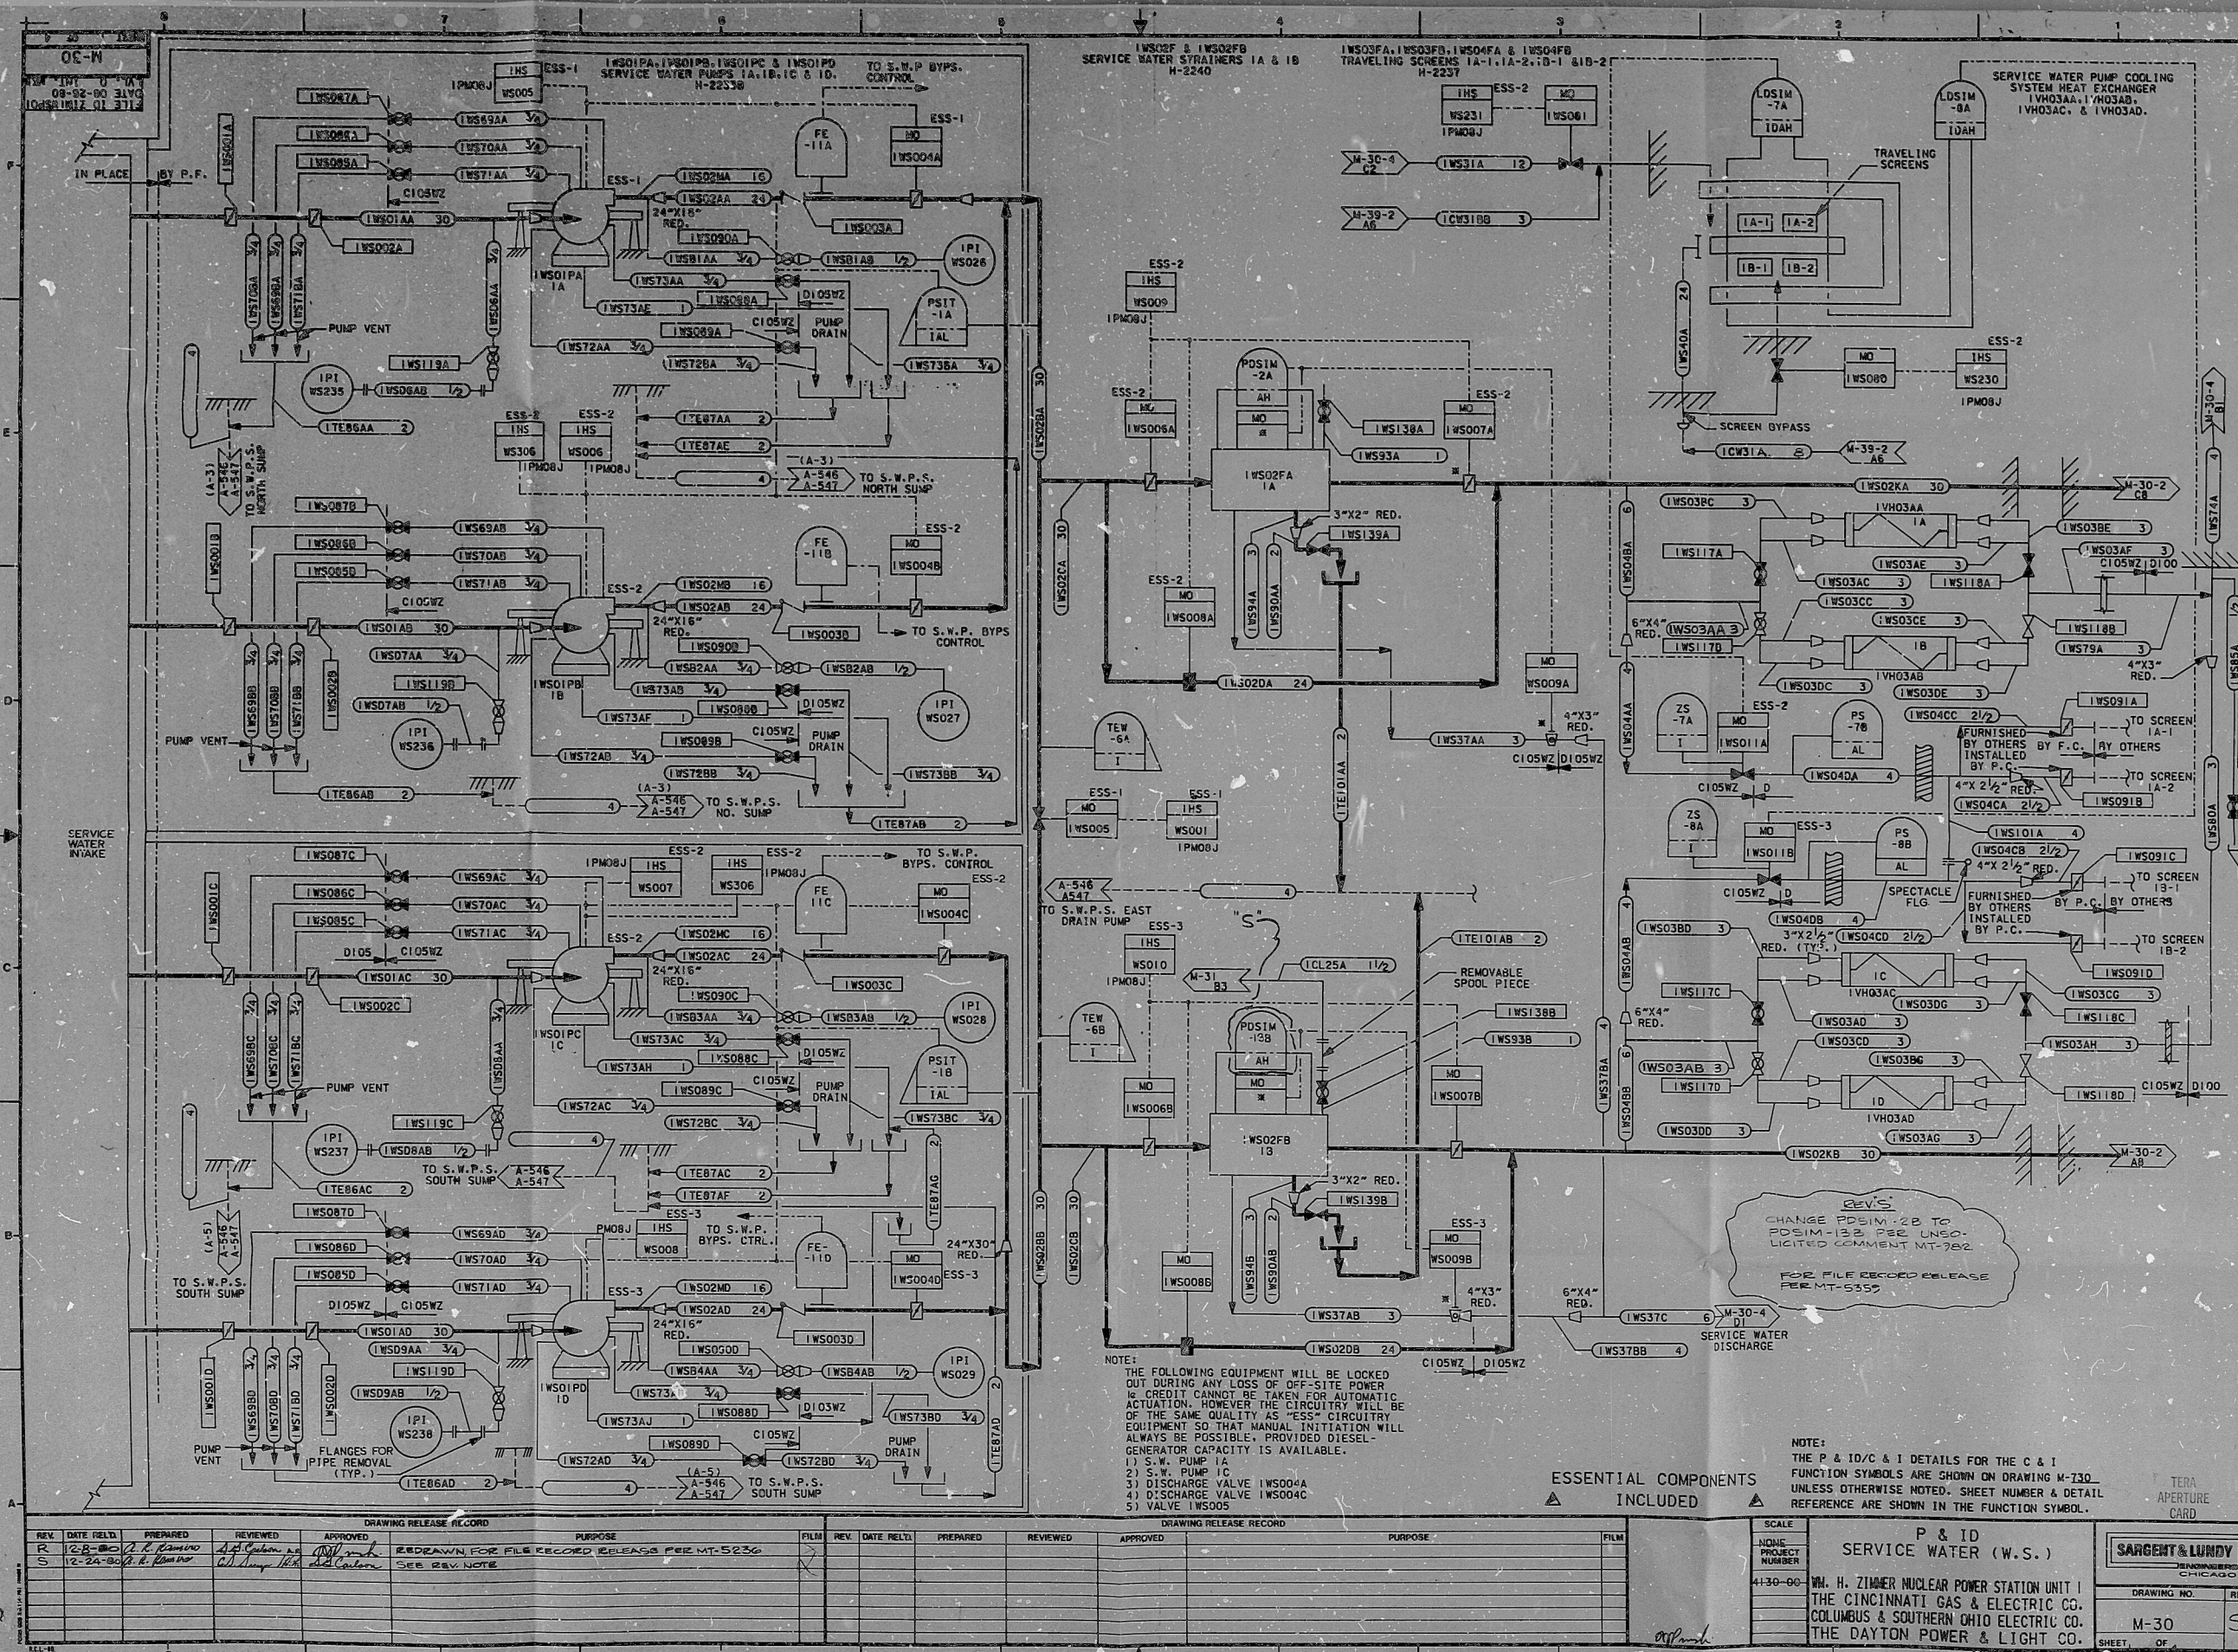