


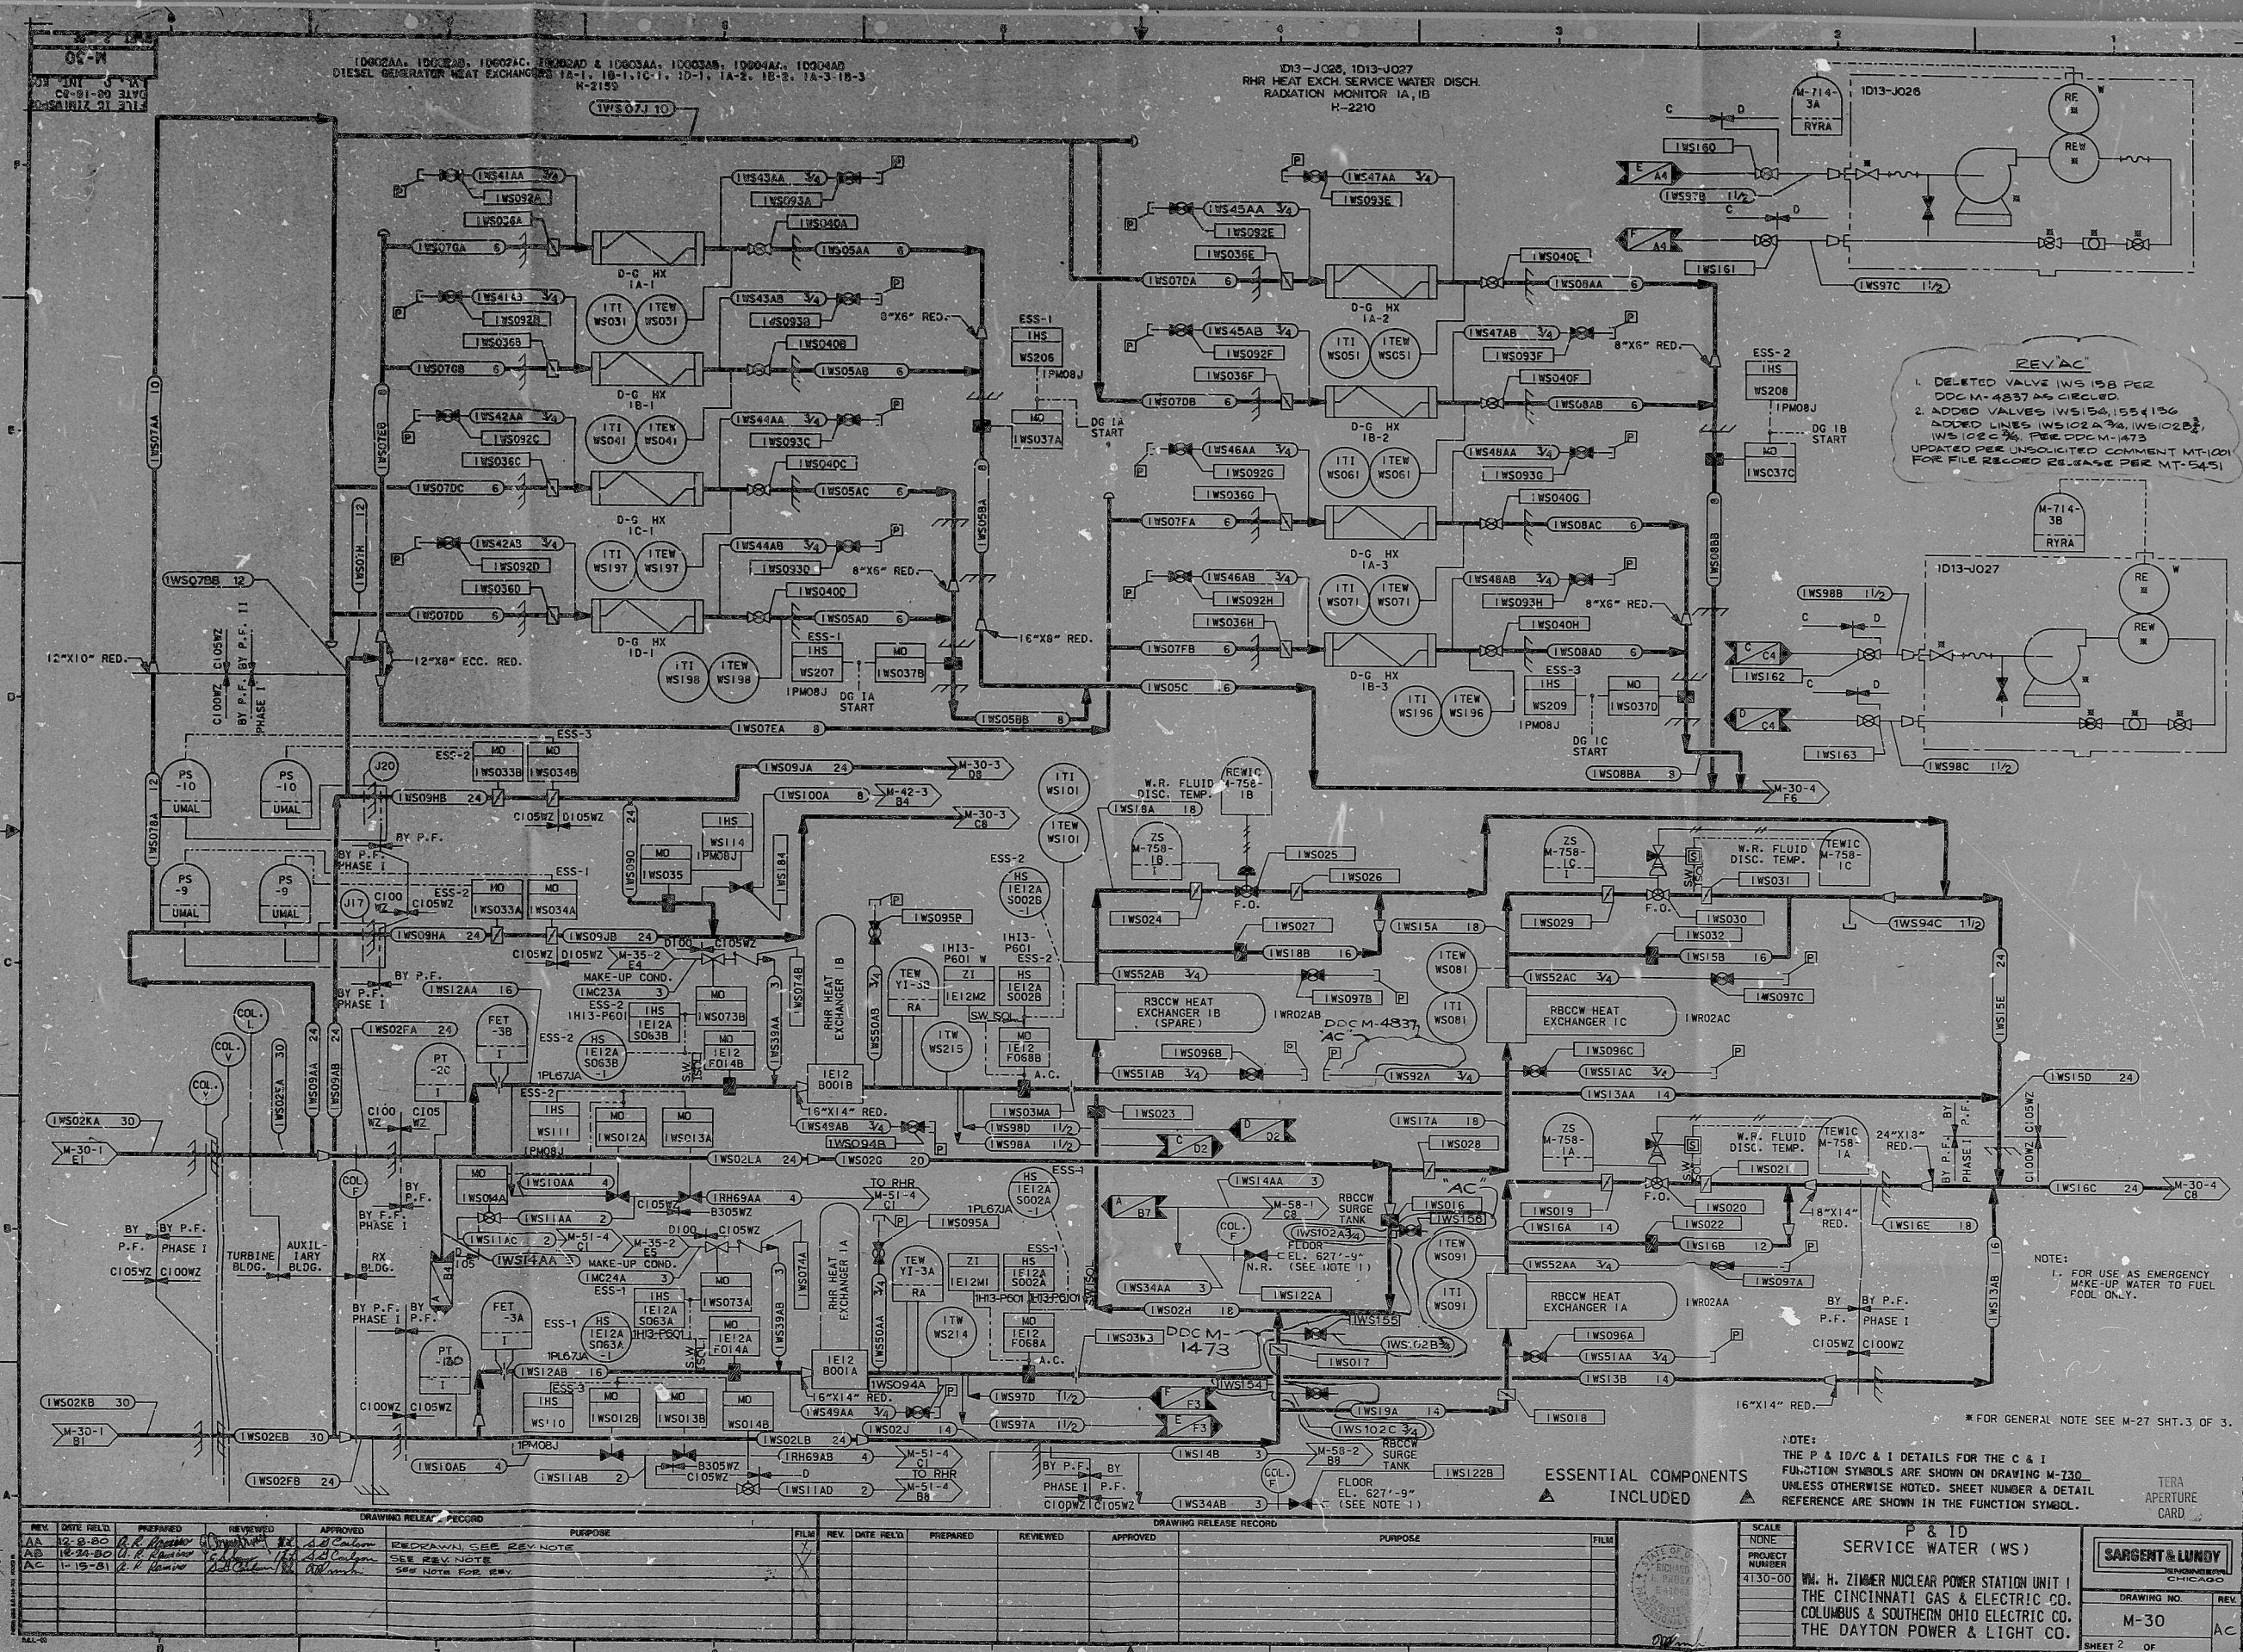

RIDS-RD12

8104010299

