

108

22

17

11

50


0.5"

11"

17"

22"

34"

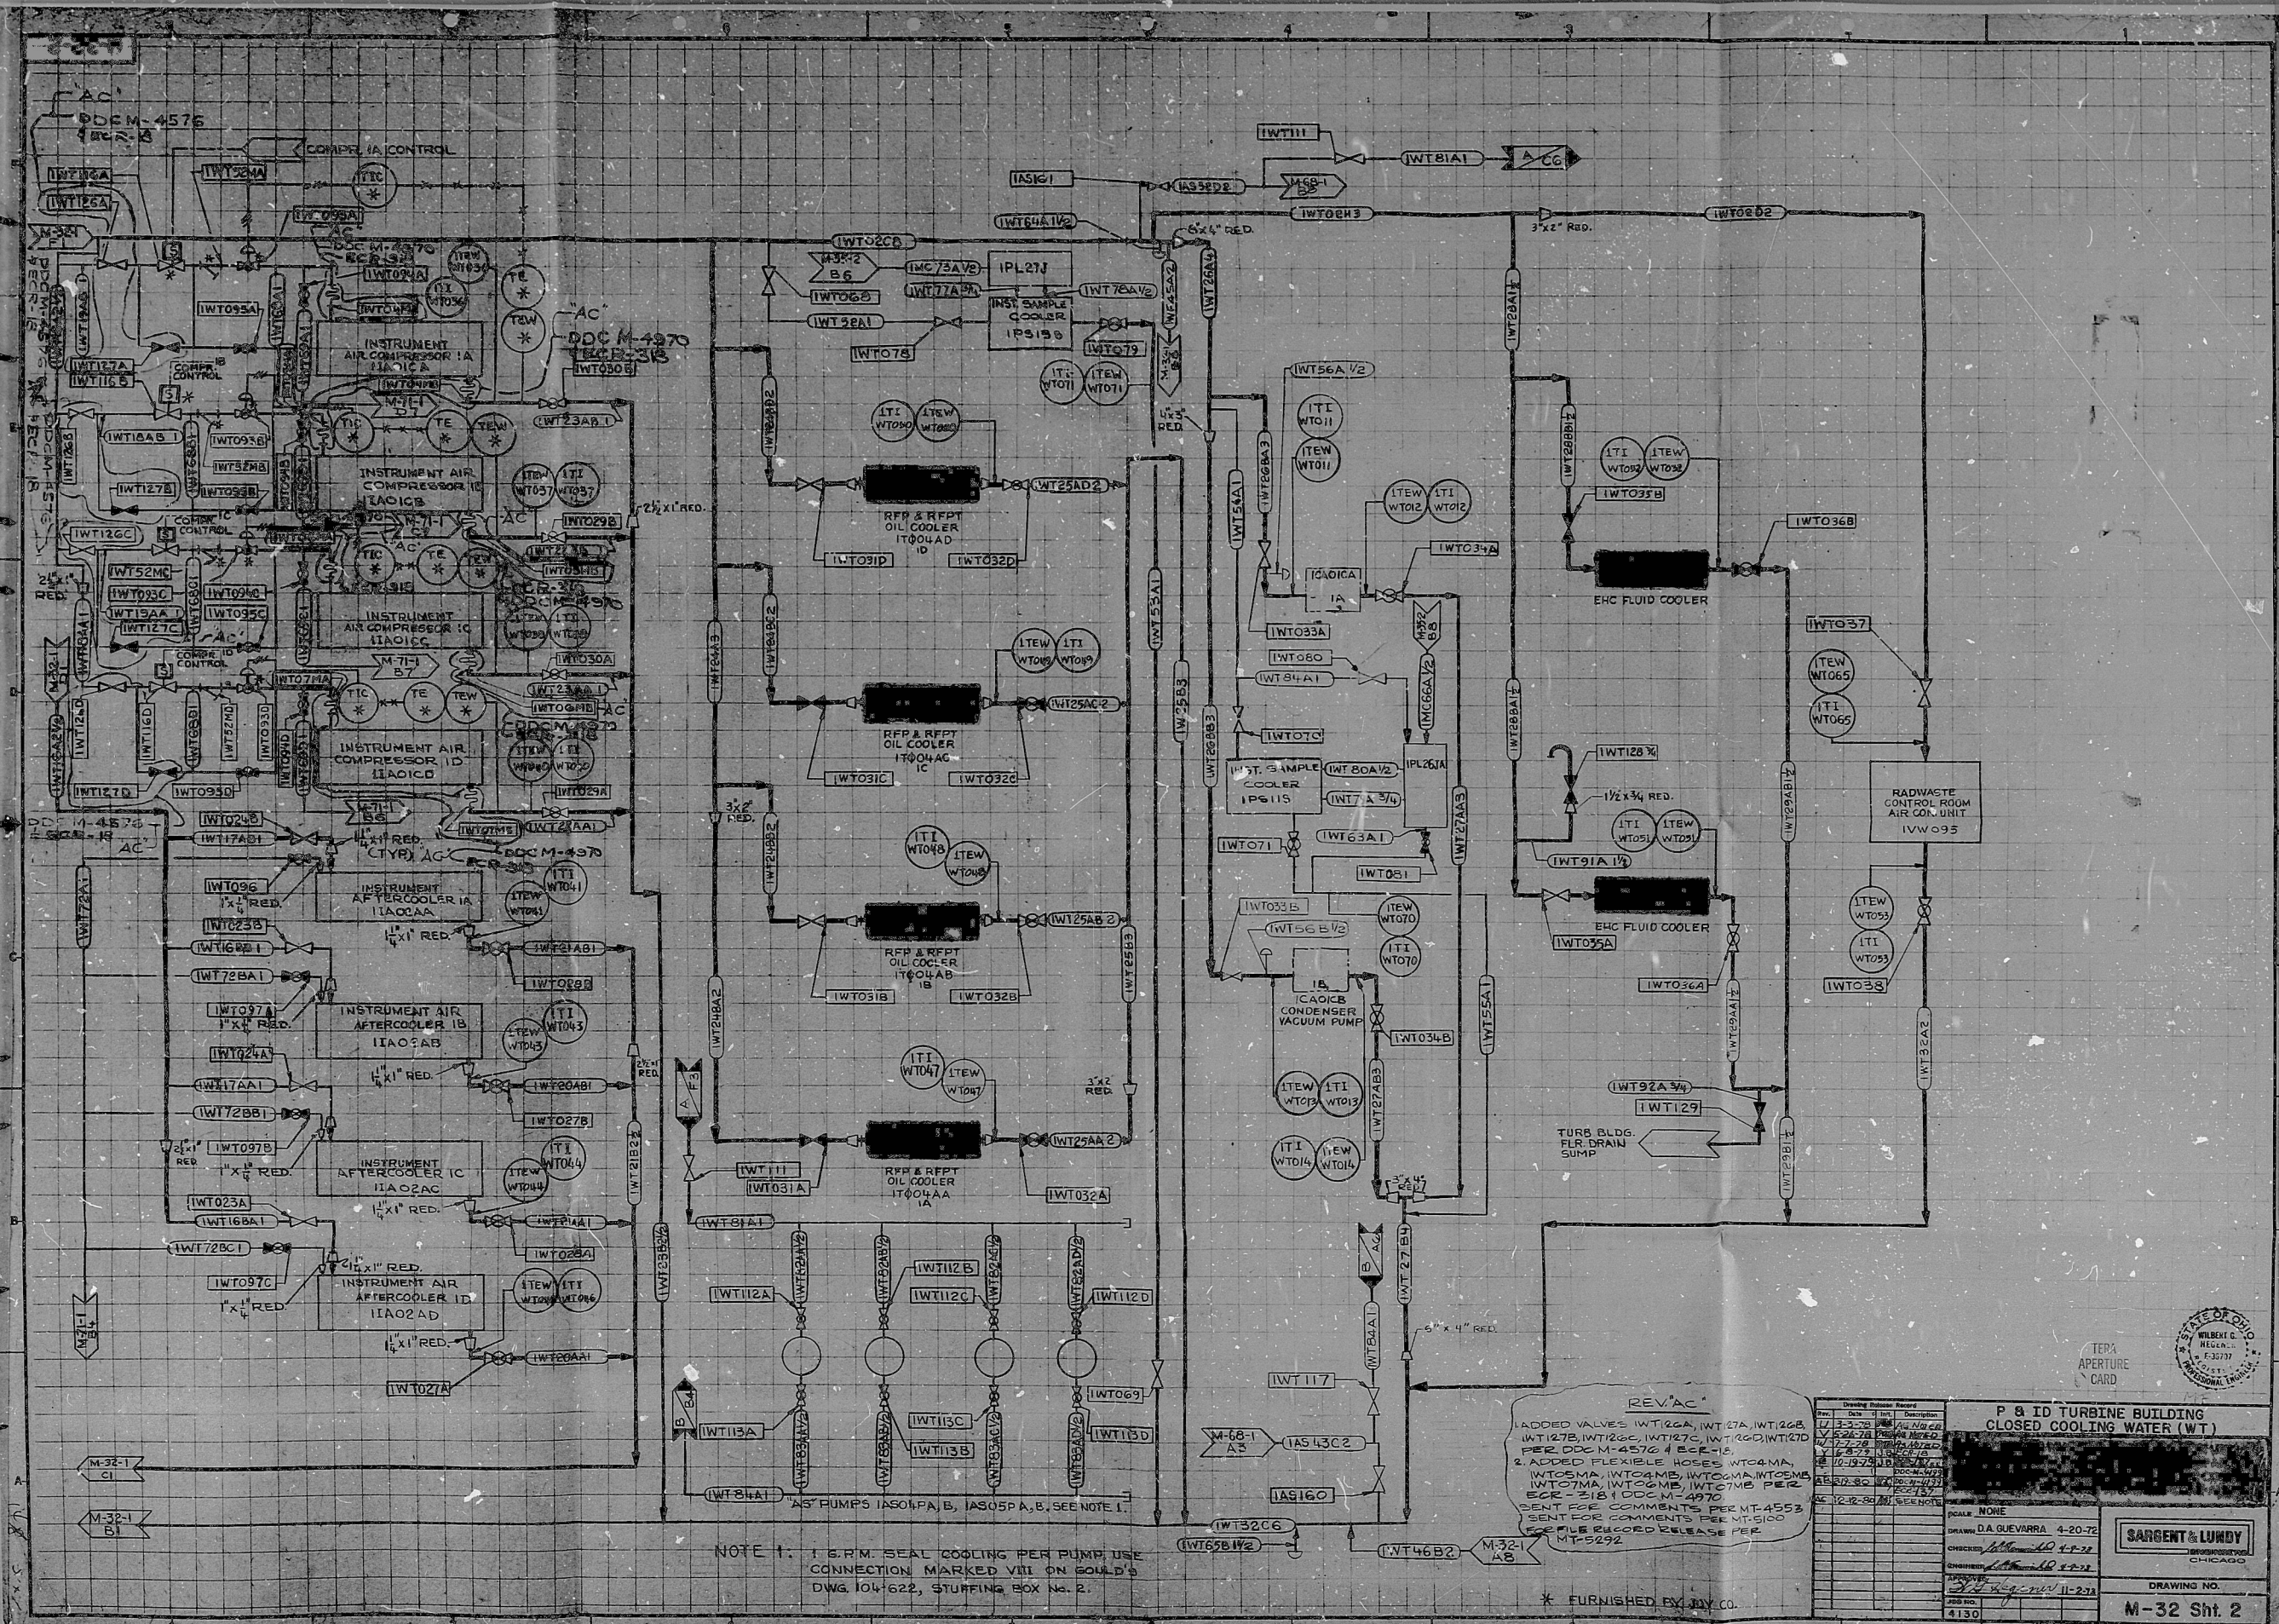

NOTE 1. 1 G.P.M. SEAL COOLING PER PUMP USE CONNECTION MARKED VIII ON SOUL'S DWG 104-622, STUFFING BOX No. 2.

REV. A  
ADDED VALVES WT126A, WT127A, WT126B, WT127B, WT126C, WT127C, WT126D, WT127D PER DDC M-4576 4-BF-15  
2 ADDED FLEXIBLE HOSES WT60A, WT60B, WT60C, WT60Z  
SENT FOR COMMENTS PER MT-4553  
SENT FOR COMMENTS PER MT-5100  
FOR FILE RECORD RELEASE PER MT-5292

Drawn: D.A. GUEVARA 4-20-76  
Checked: [Signature] 4-20-76  
Designed: [Signature] 4-20-76  
Job No. 4130

**SARGENT & LUNDY**  
ENGINEERS  
CHICAGO, ILL.

DRAWING NO.  
**M-32 Sht. 2**

RDS-PDR

8104010305

