


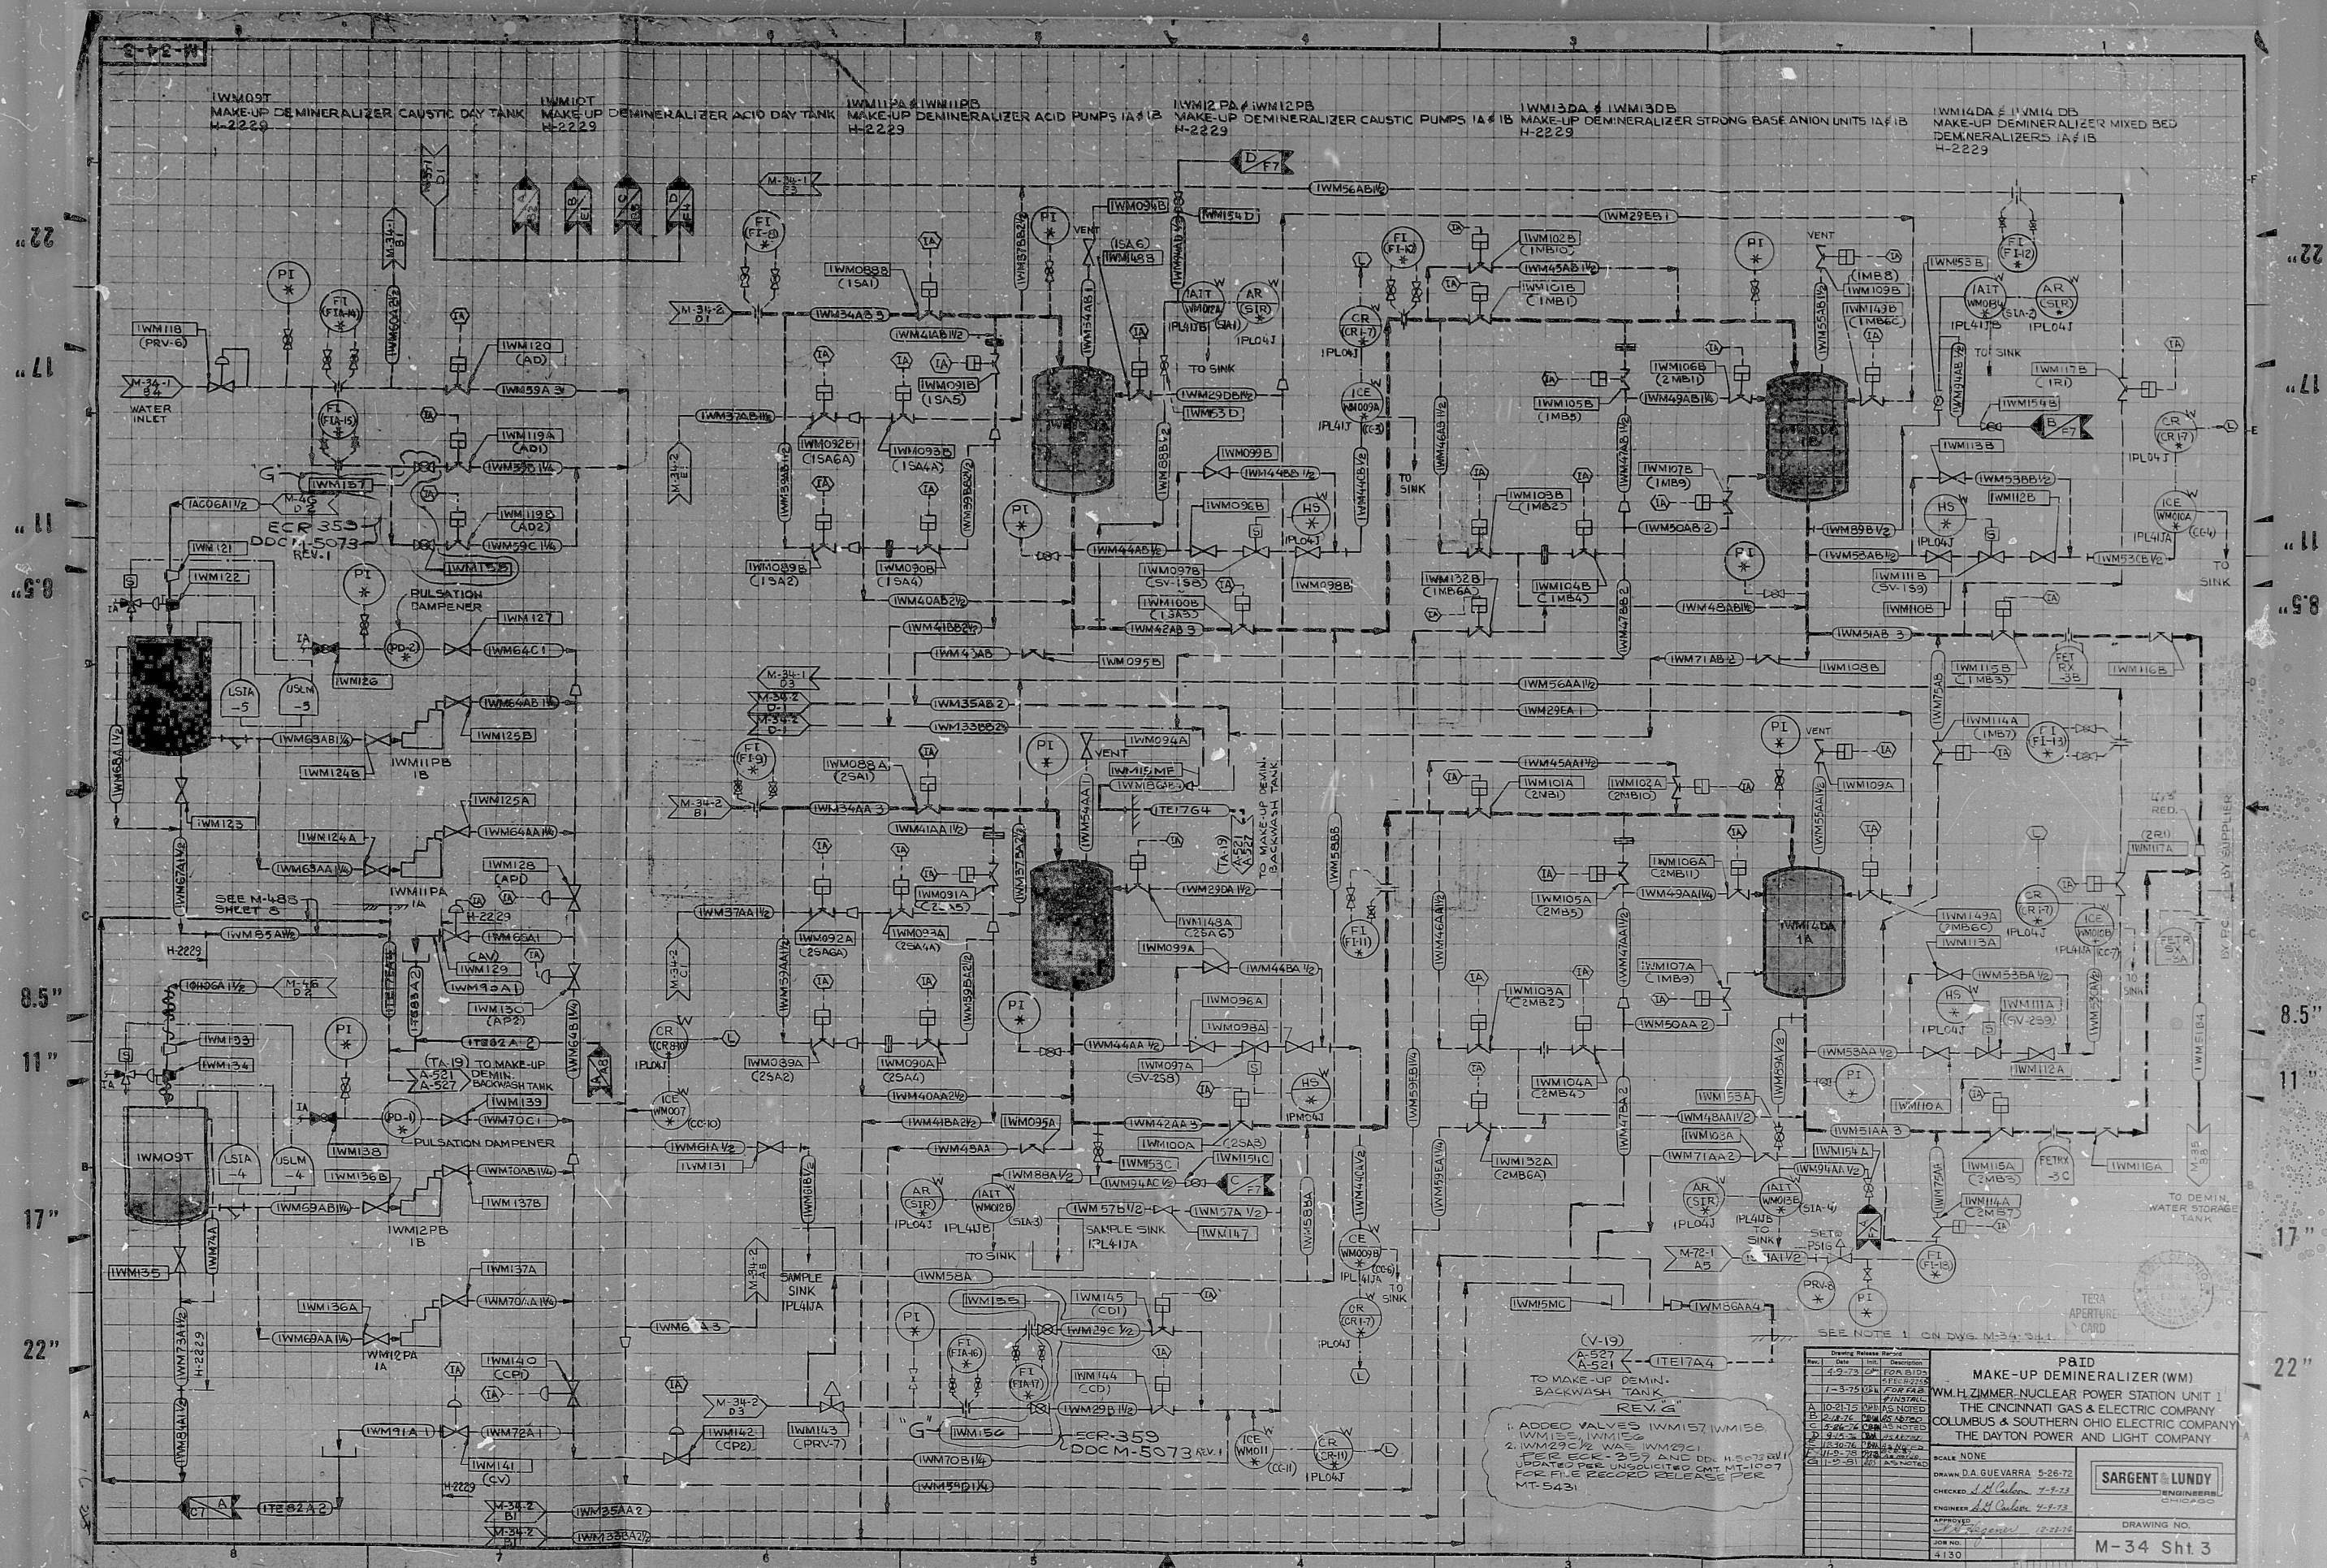

RDS-RDR

8104010314

