

17

11

8.5

8.5

11

17

17


11

8.5

8.5

11

17

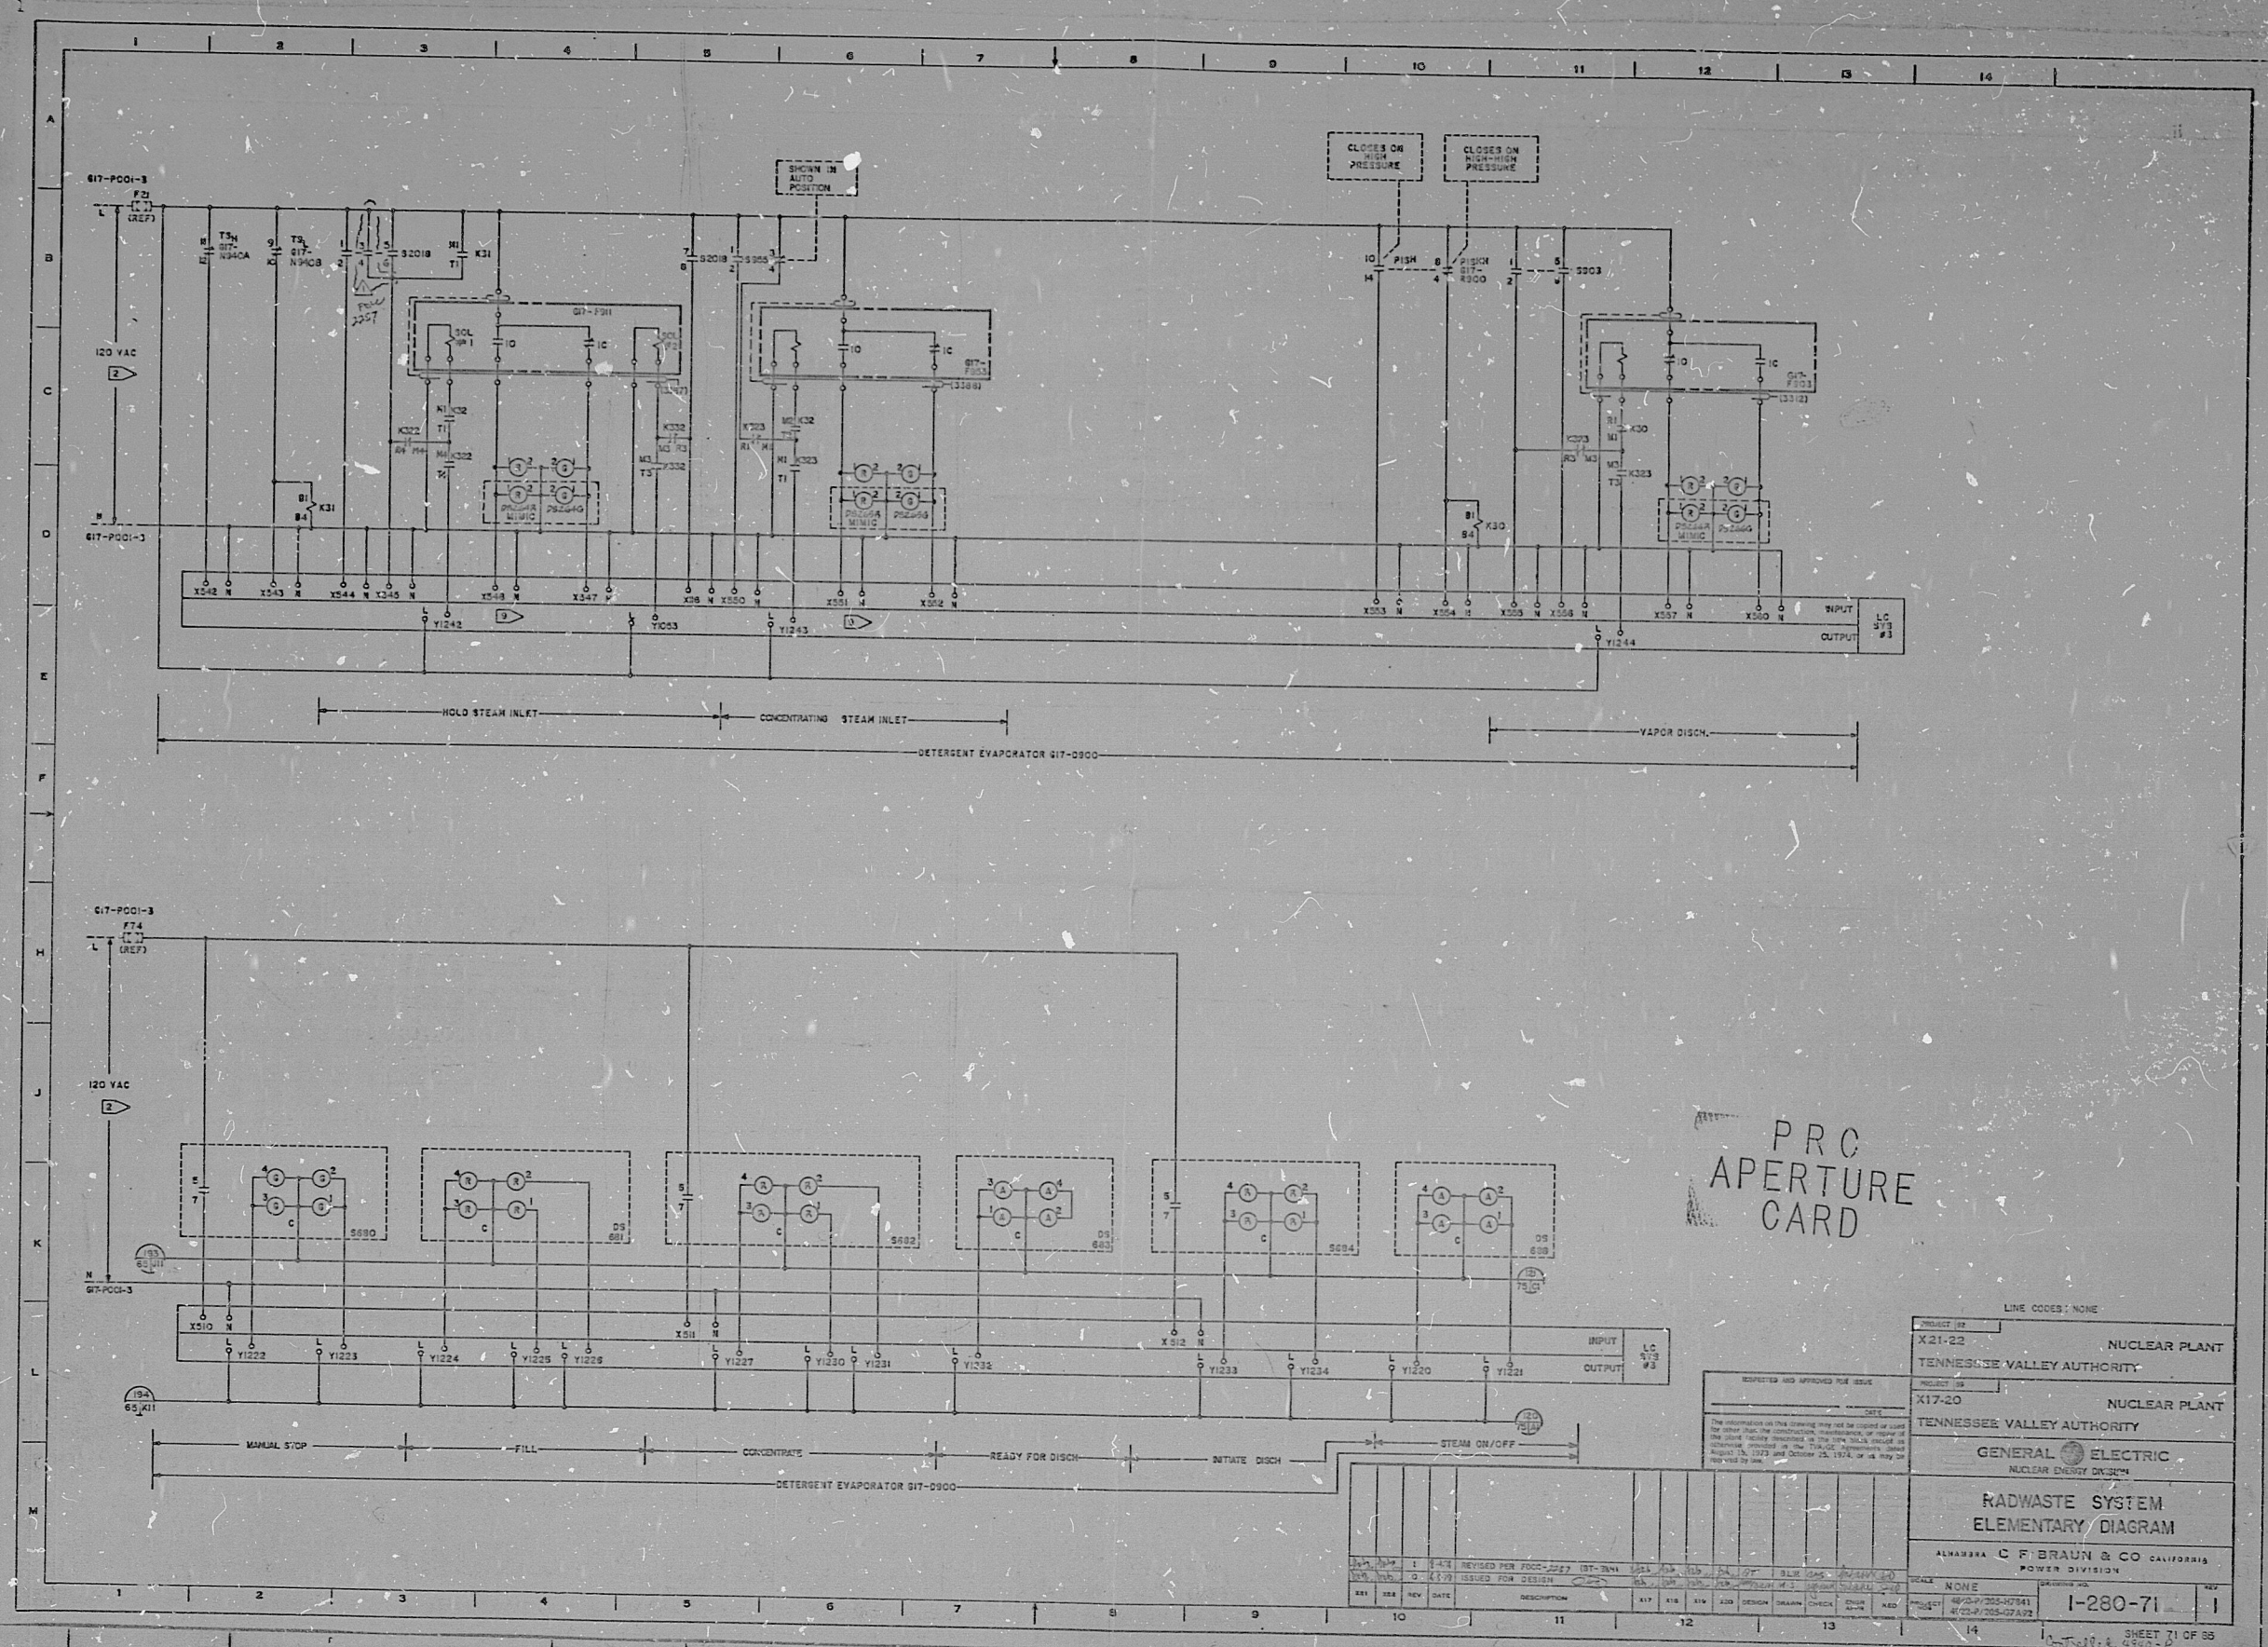

PRC
APERTURE
CARD

LINE CODES: NONE	
PROJECT #	X21-22
TENNESSEE VALLEY AUTHORITY	
PROJECT #	X17-20
TENNESSEE VALLEY AUTHORITY	
GENERAL ELECTRIC	
NUCLEAR ENERGY DIVISION	
RADWASTE SYSTEM	
ELEMENTARY DIAGRAM	
ALABAMA C. F. BRAUN & CO. CALIFORNIA	
POWER DIVISION	
REV	1
REV	2
RIDS

8206290097

