


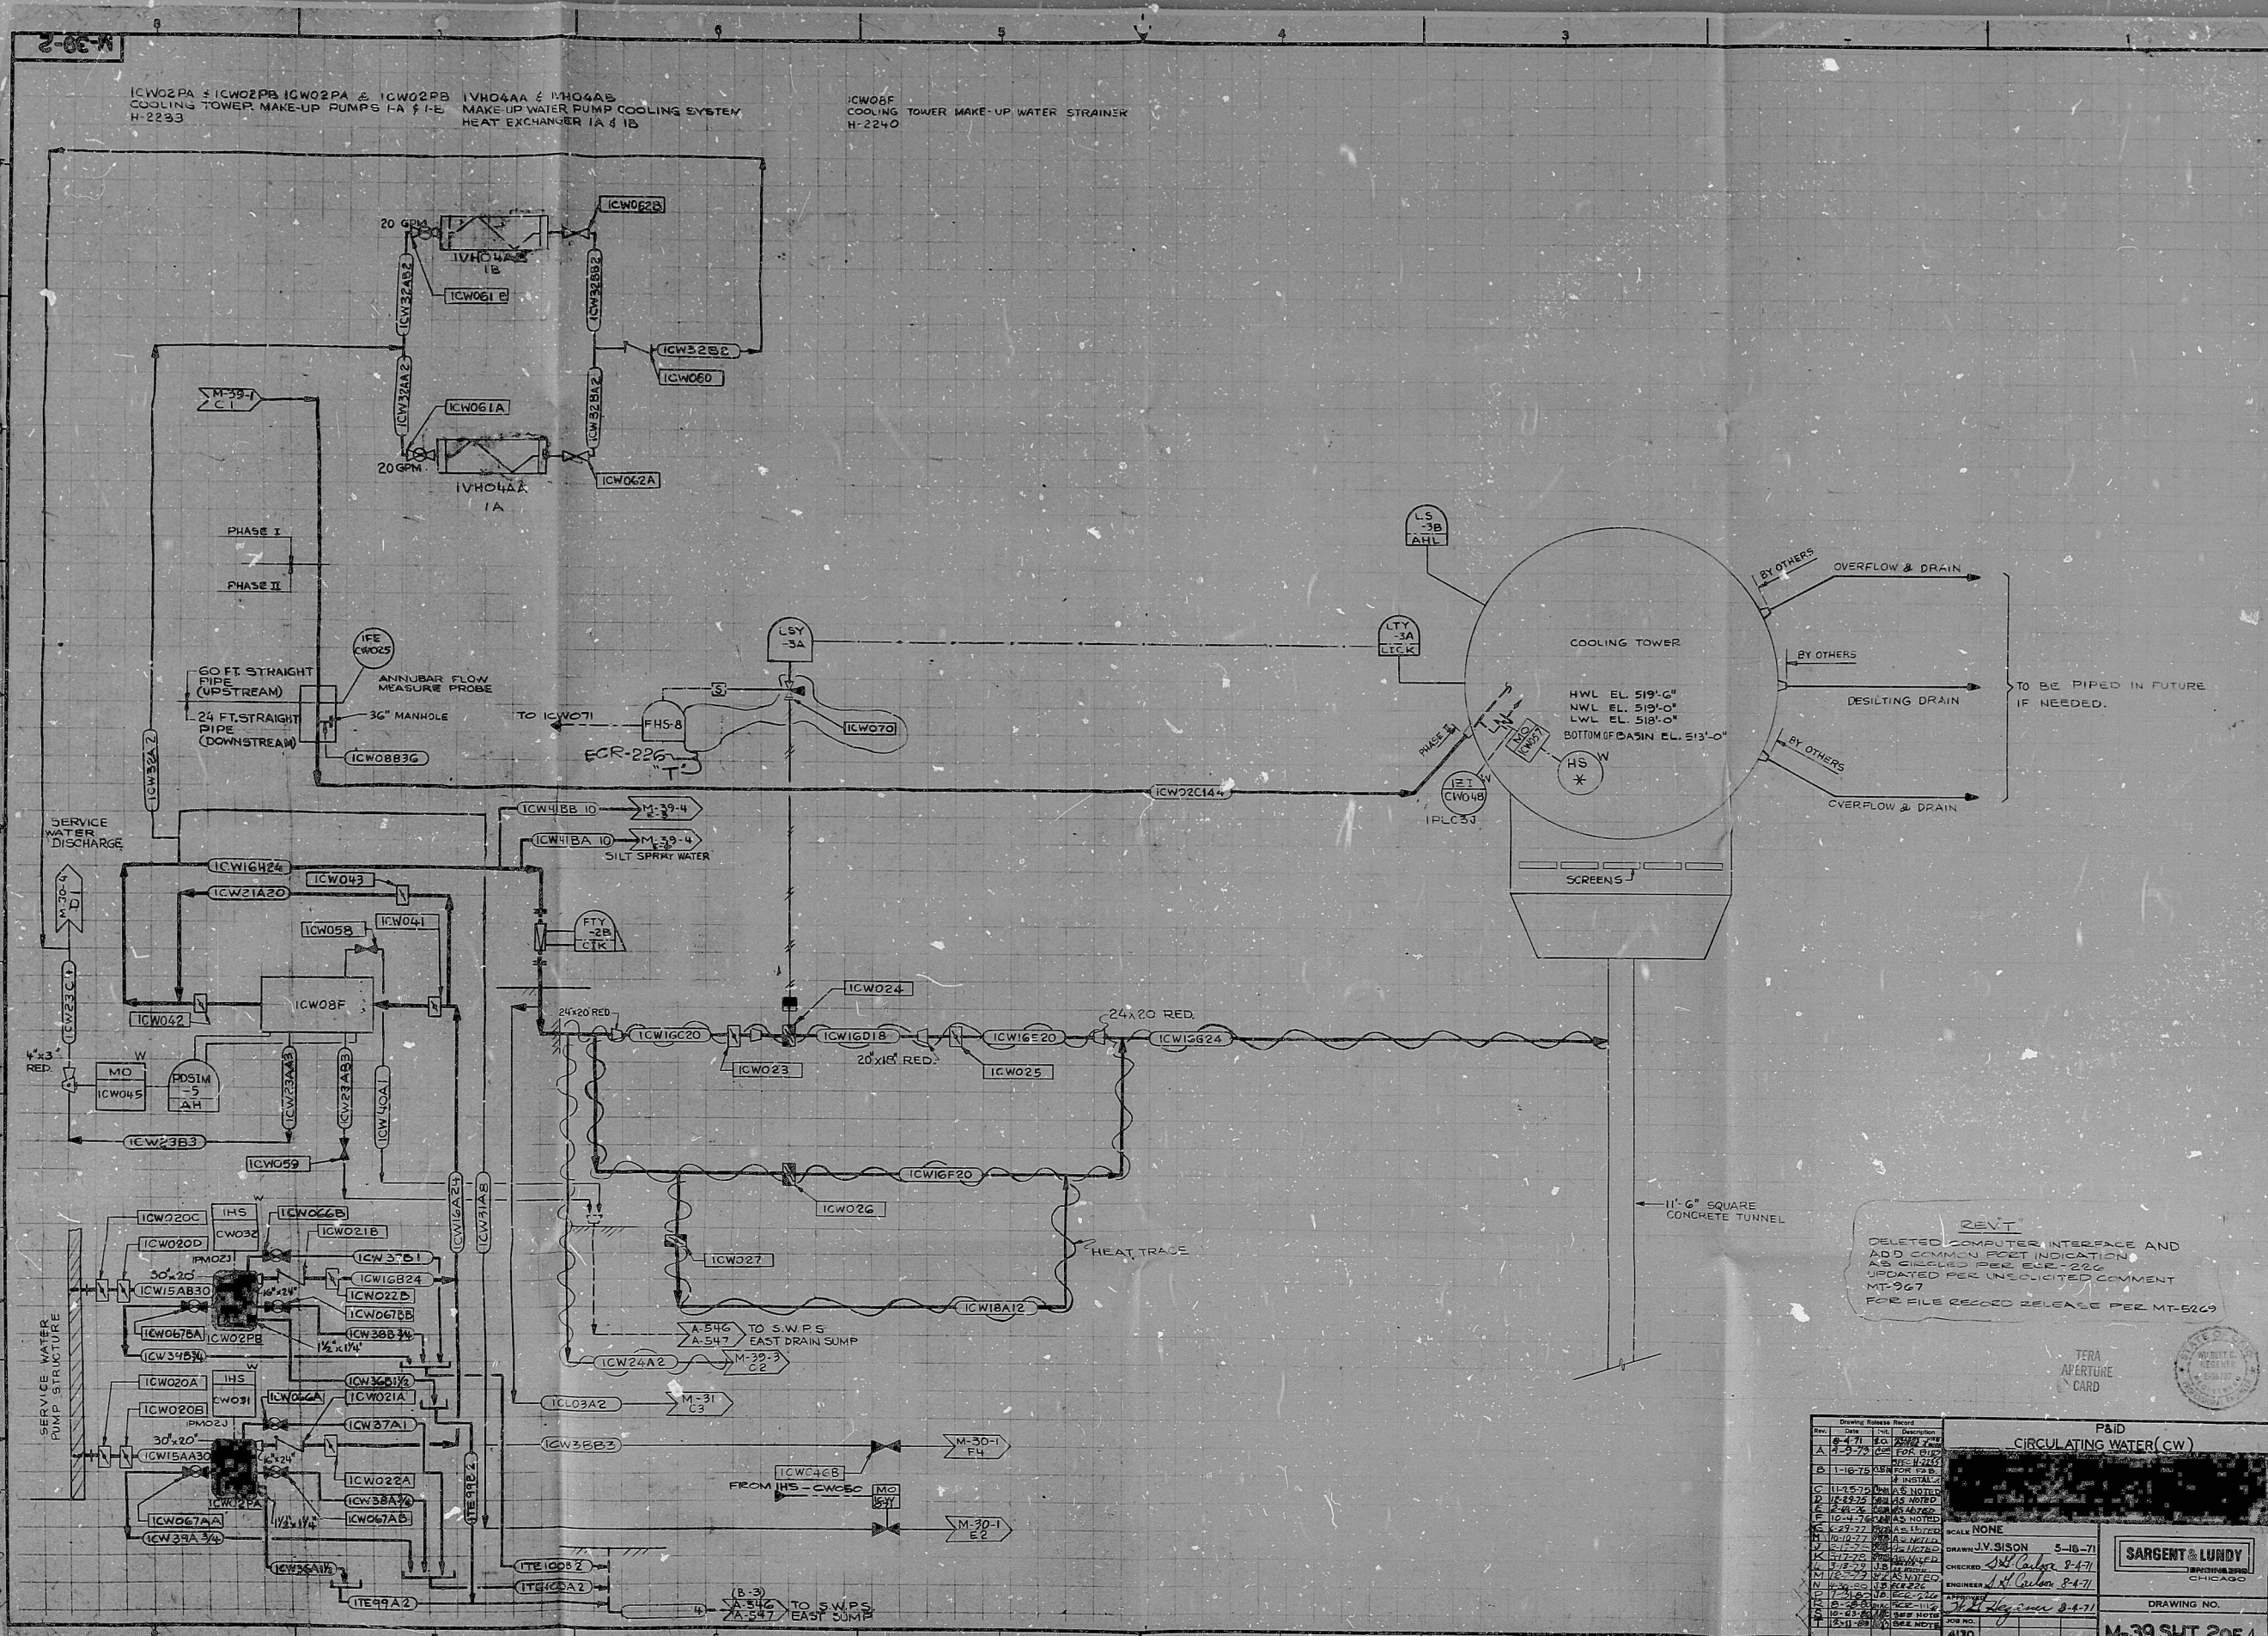

12SDS-PDR

8104010320

