

22

17

11


8.5

11

17

22

34

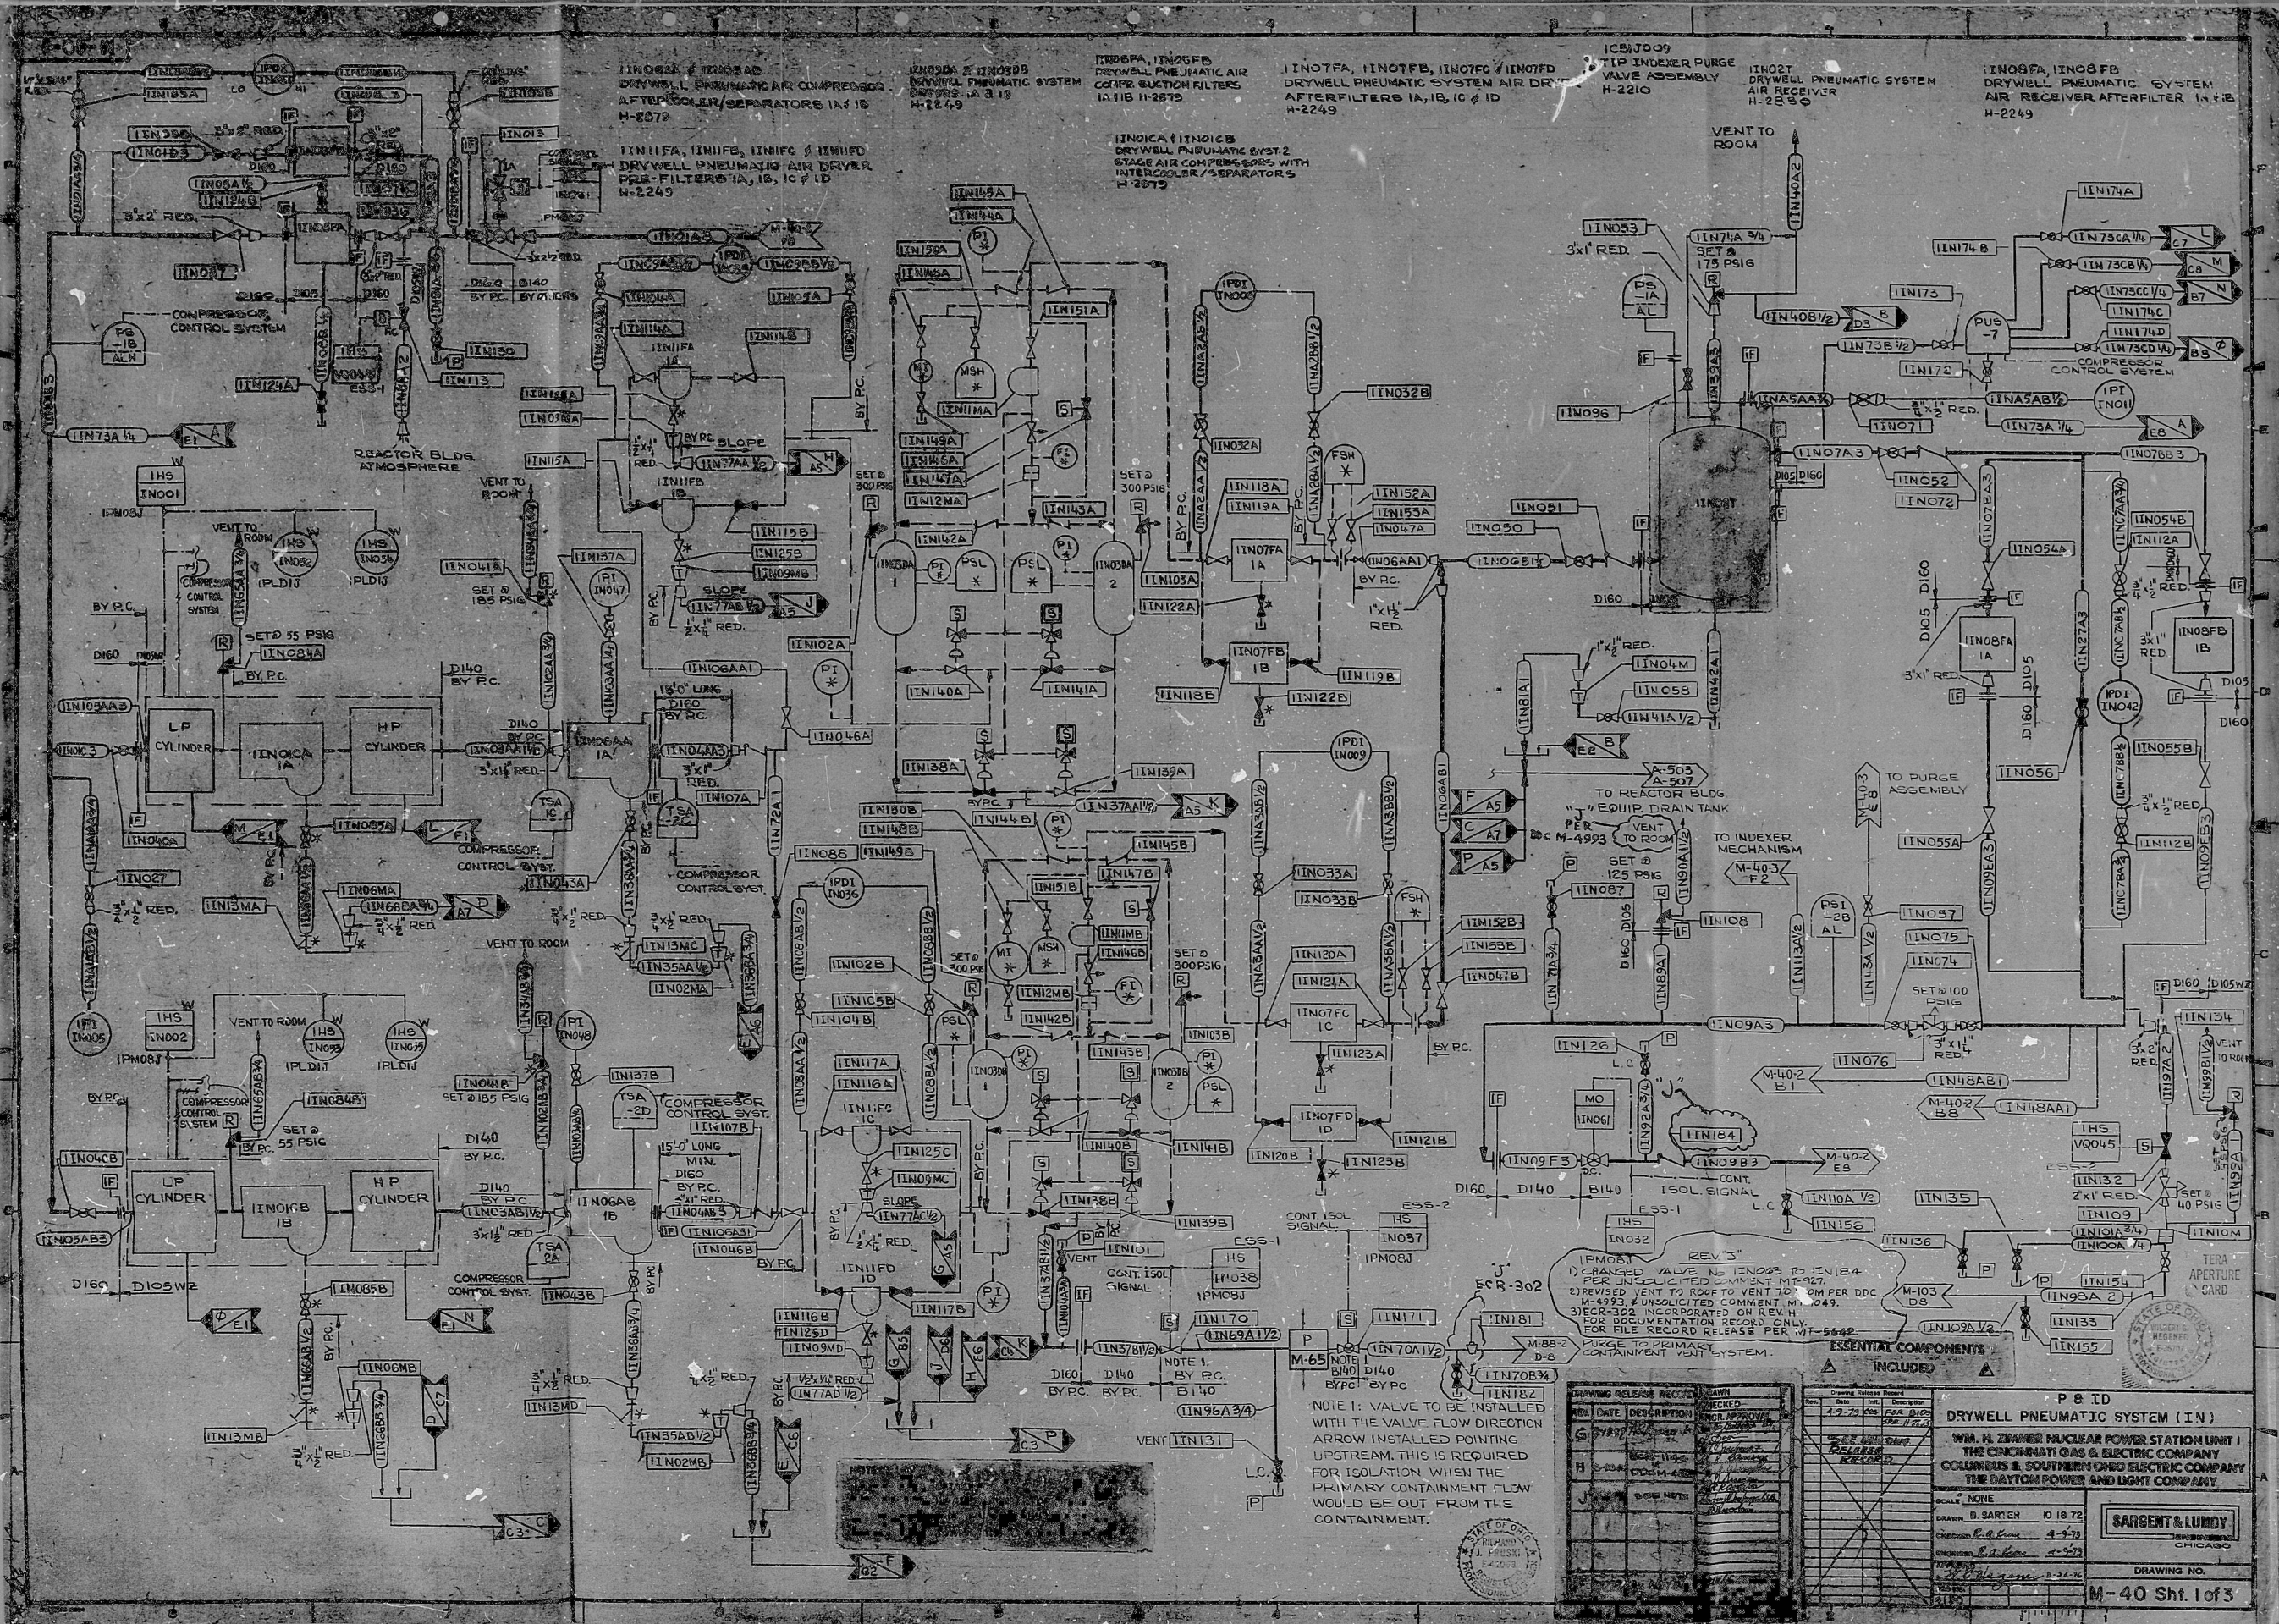

NOTE 1: VALVE TO BE INSTALLED WITH THE VALVE FLOW DIRECTION ARROW INSTALLED POINTING UPSTREAM. THIS IS REQUIRED FOR ISOLATION WHEN THE PRIMARY CONTAINMENT FLOW WOULD BE OUT FROM THE CONTAINMENT.

REV	DATE	DESCRIPTION	BY	CHKD

DRYWELL PNEUMATIC SYSTEM (IN)

W. H. ZIMMER NUCLEAR POWER STATION UNIT 1
THE CINCINNATI GAS & ELECTRIC COMPANY
THE DAYTON POWER AND LIGHT COMPANY

SCALE: NONE

SARGENT & LUNDY
ENGINEERS
CHICAGO, ILL.

DRAWING NO. **M-40 Sht. 1 of 3**

RID-1012

8104010329

