




RDS-FDR

8104010342

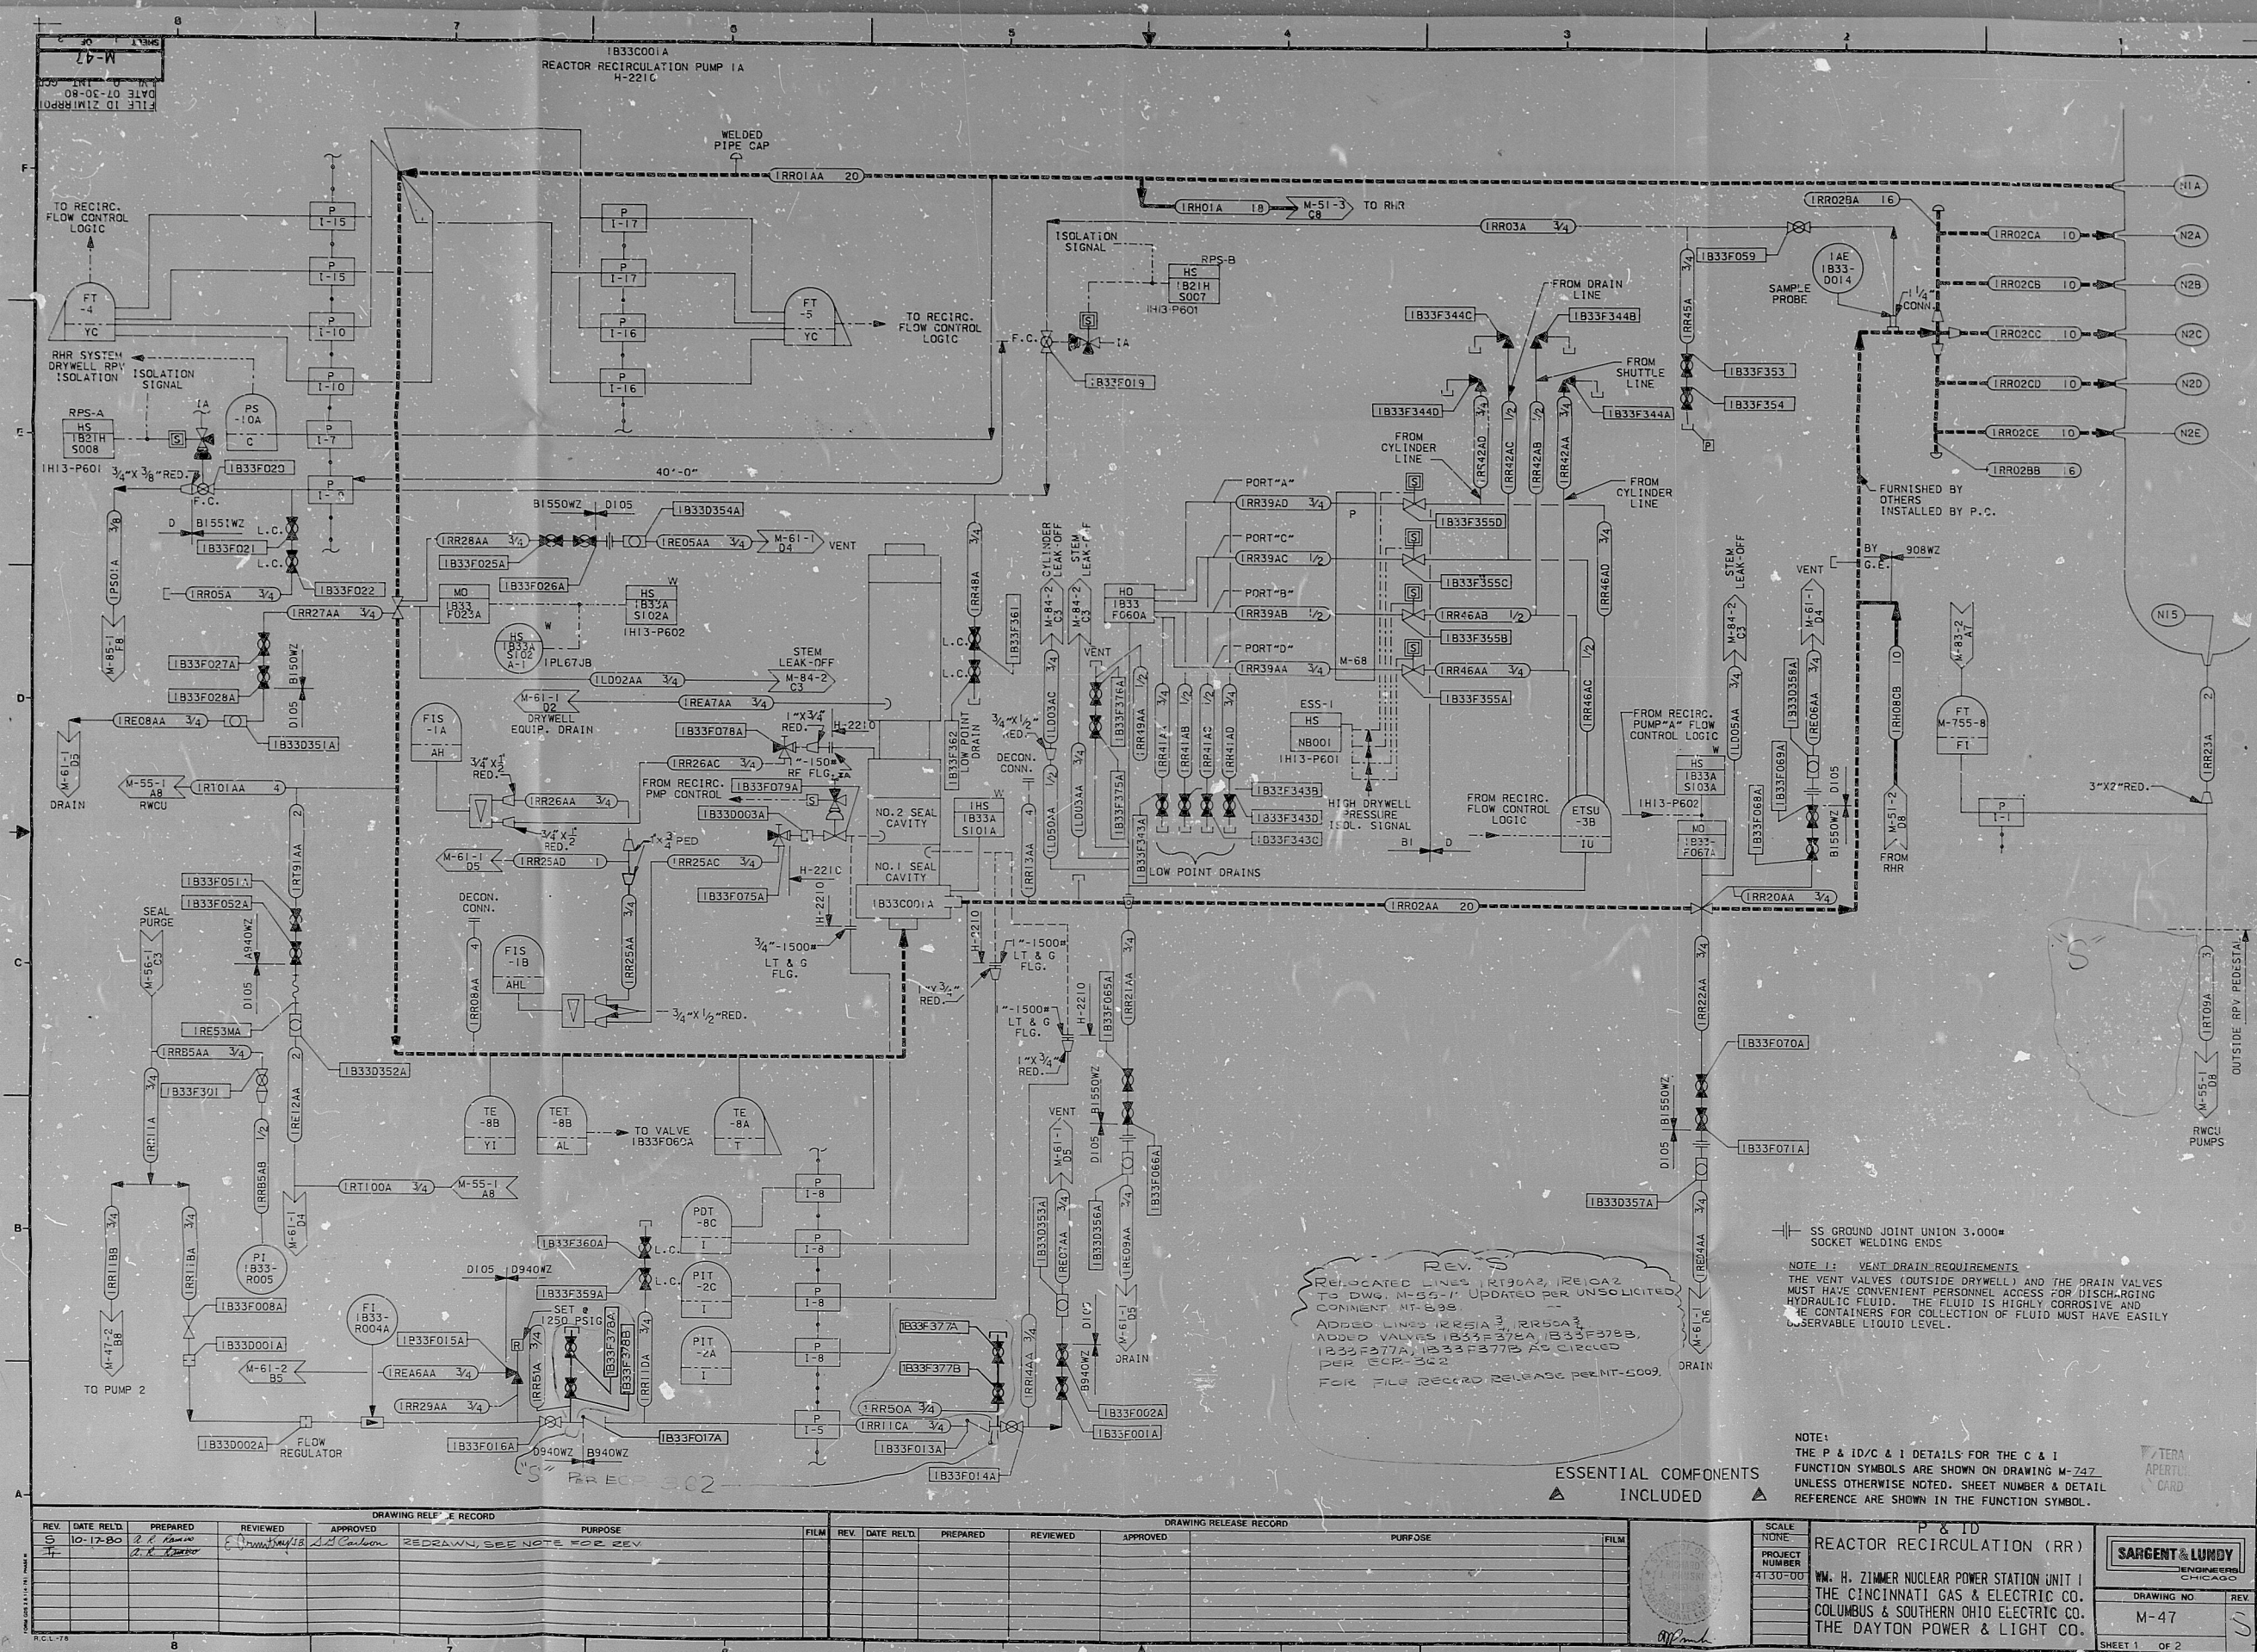