


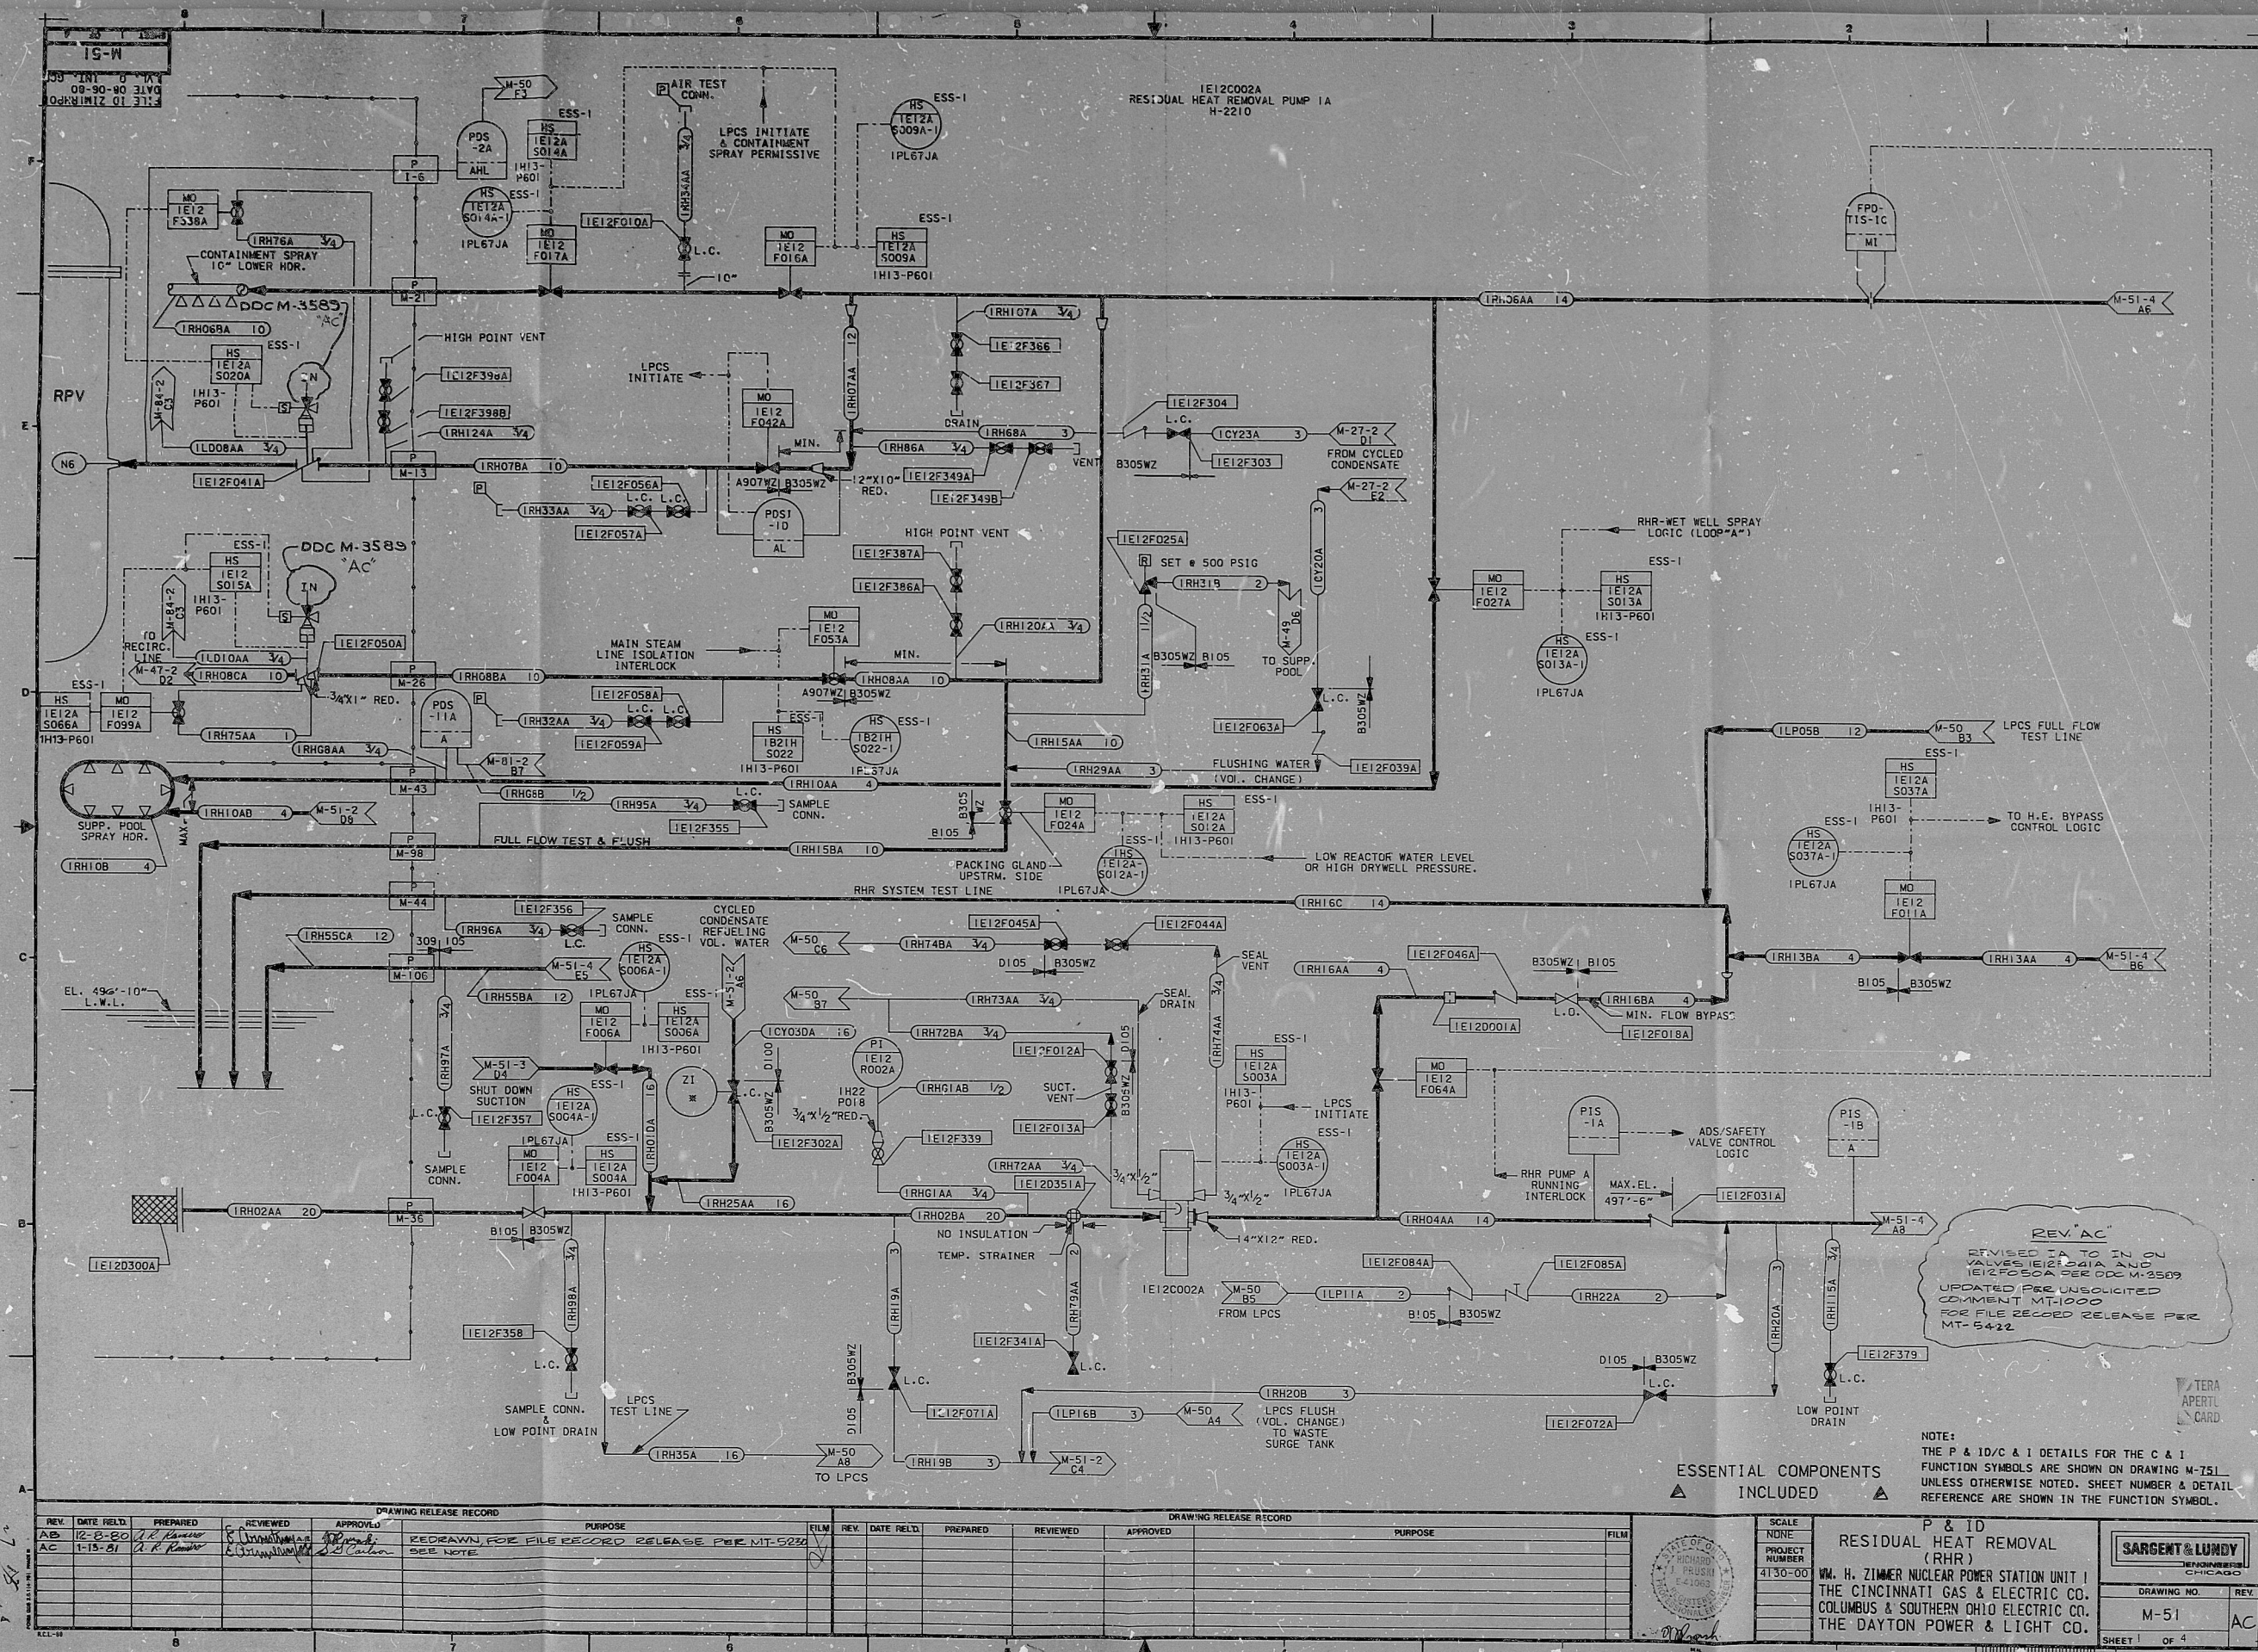

RDS-PDR

810499361

