


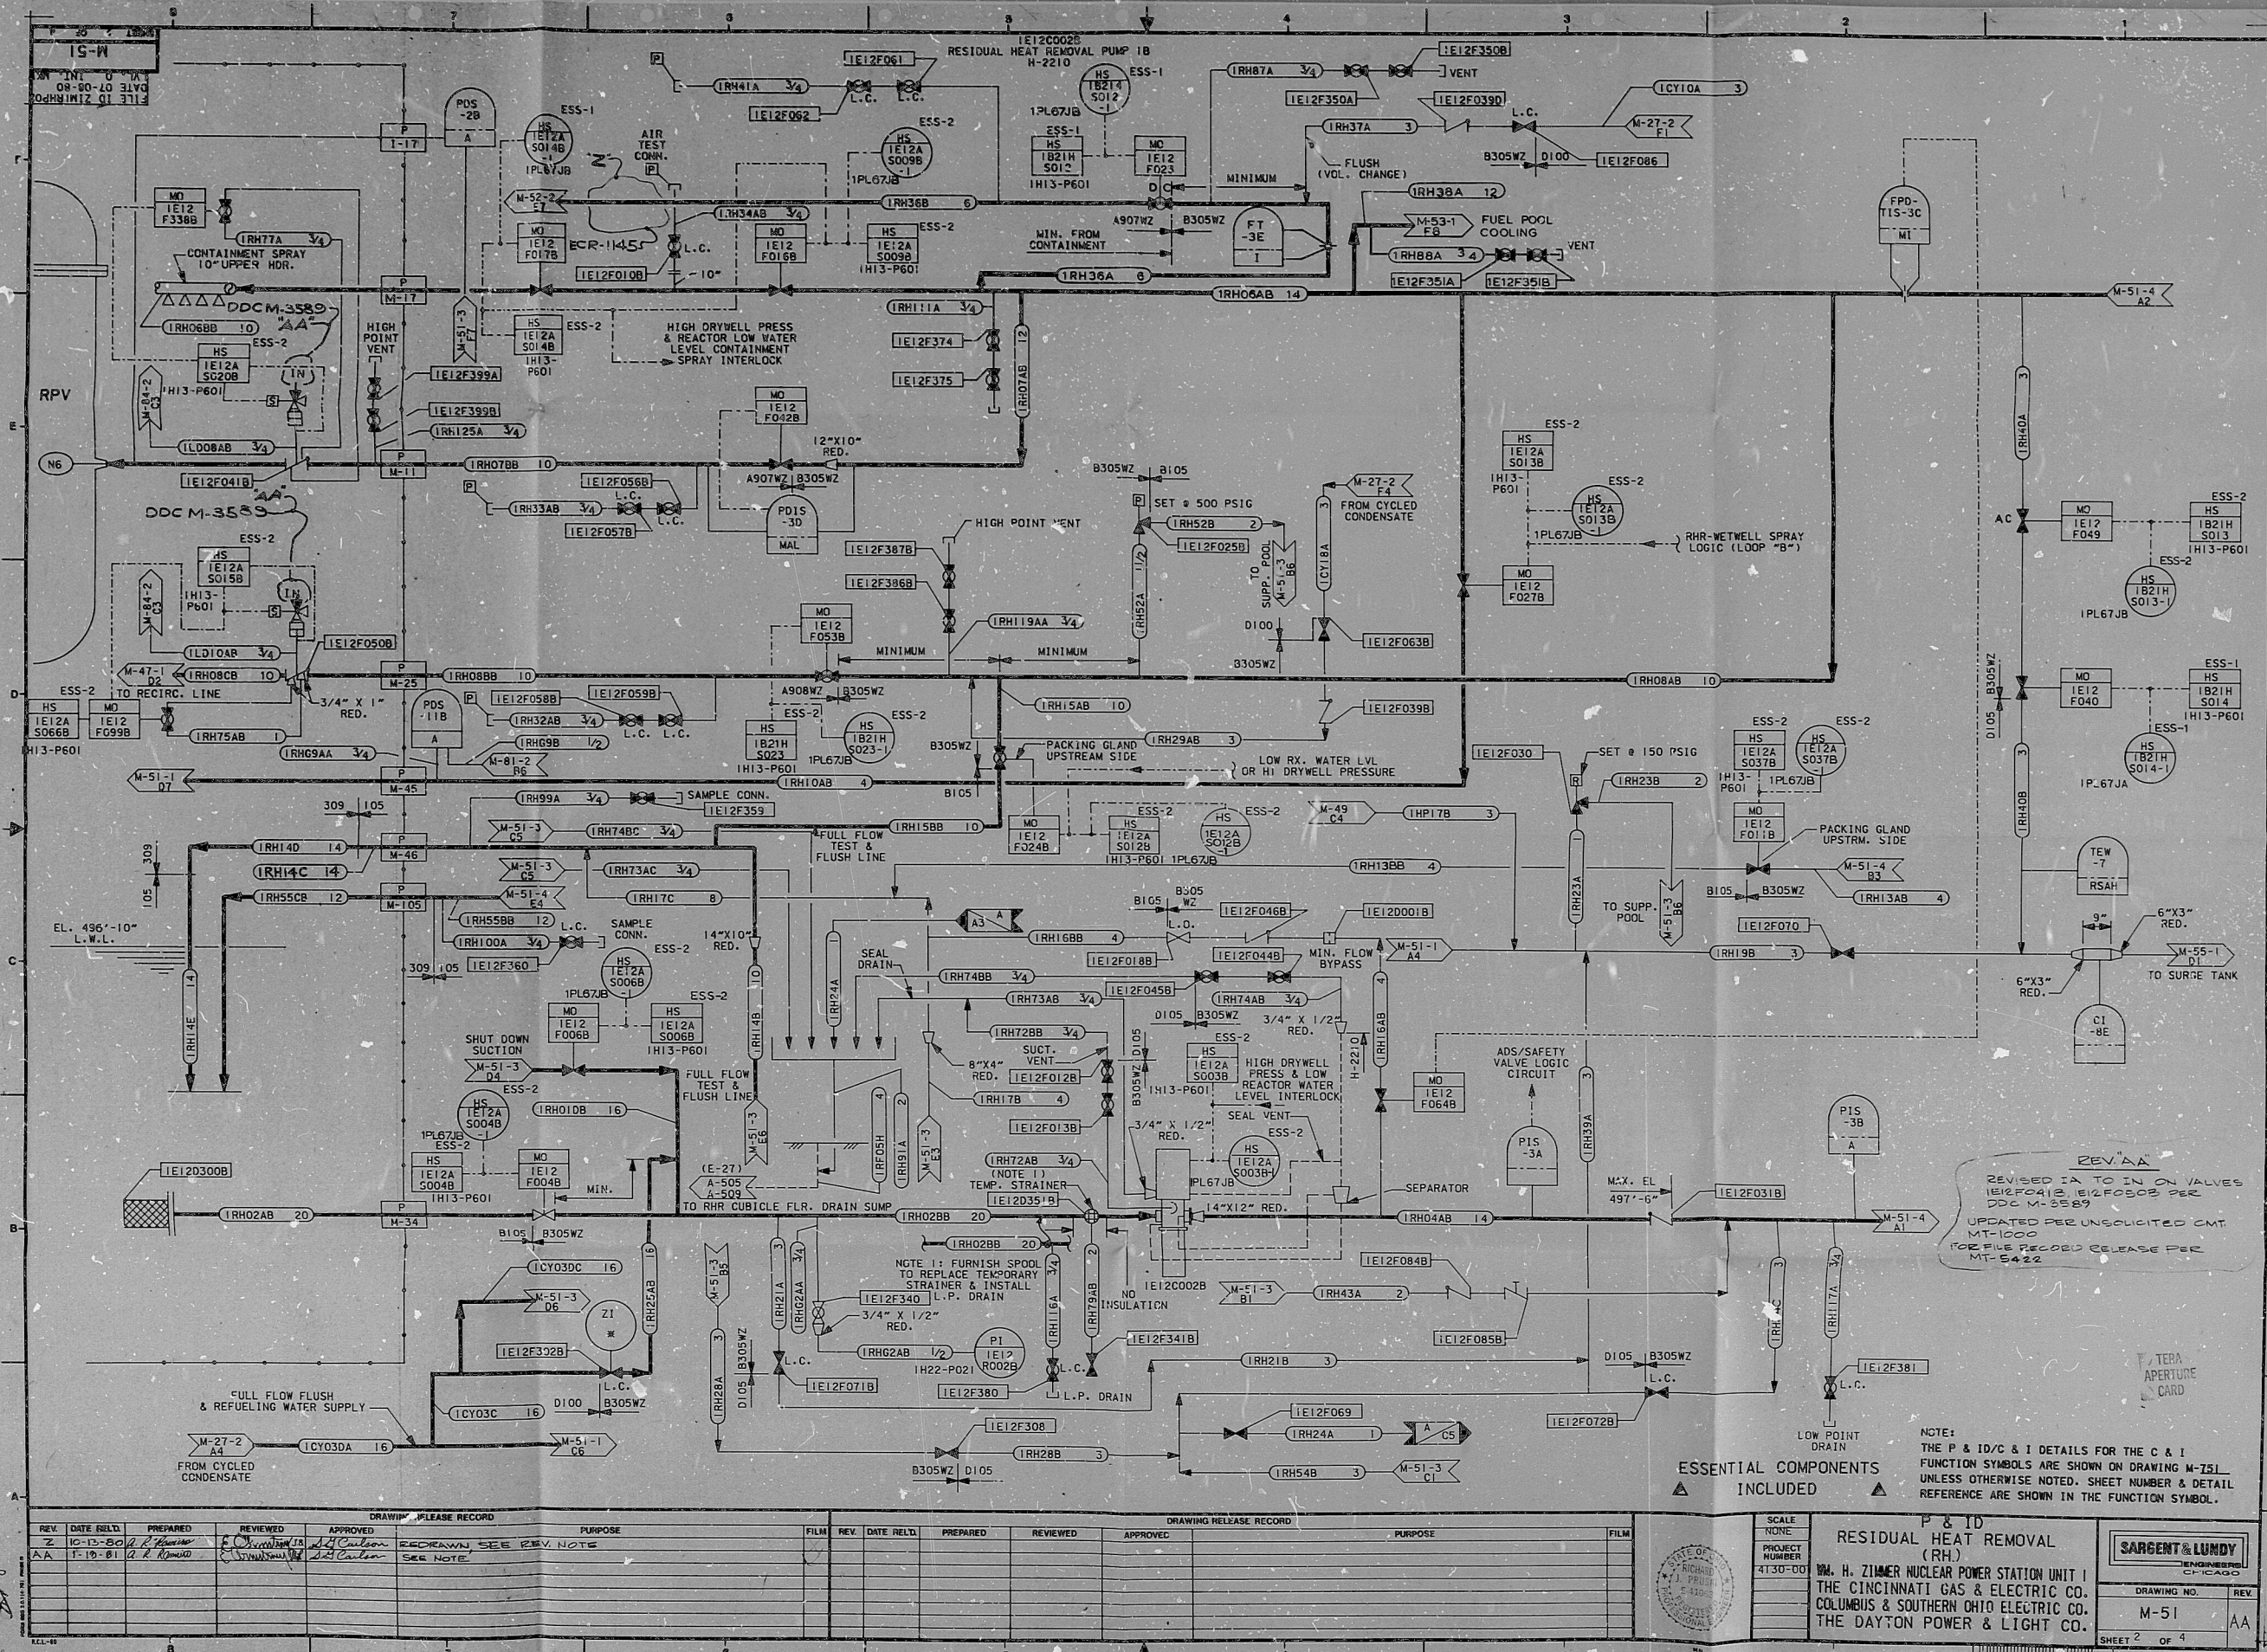

RDS-PDR

8104010363

