


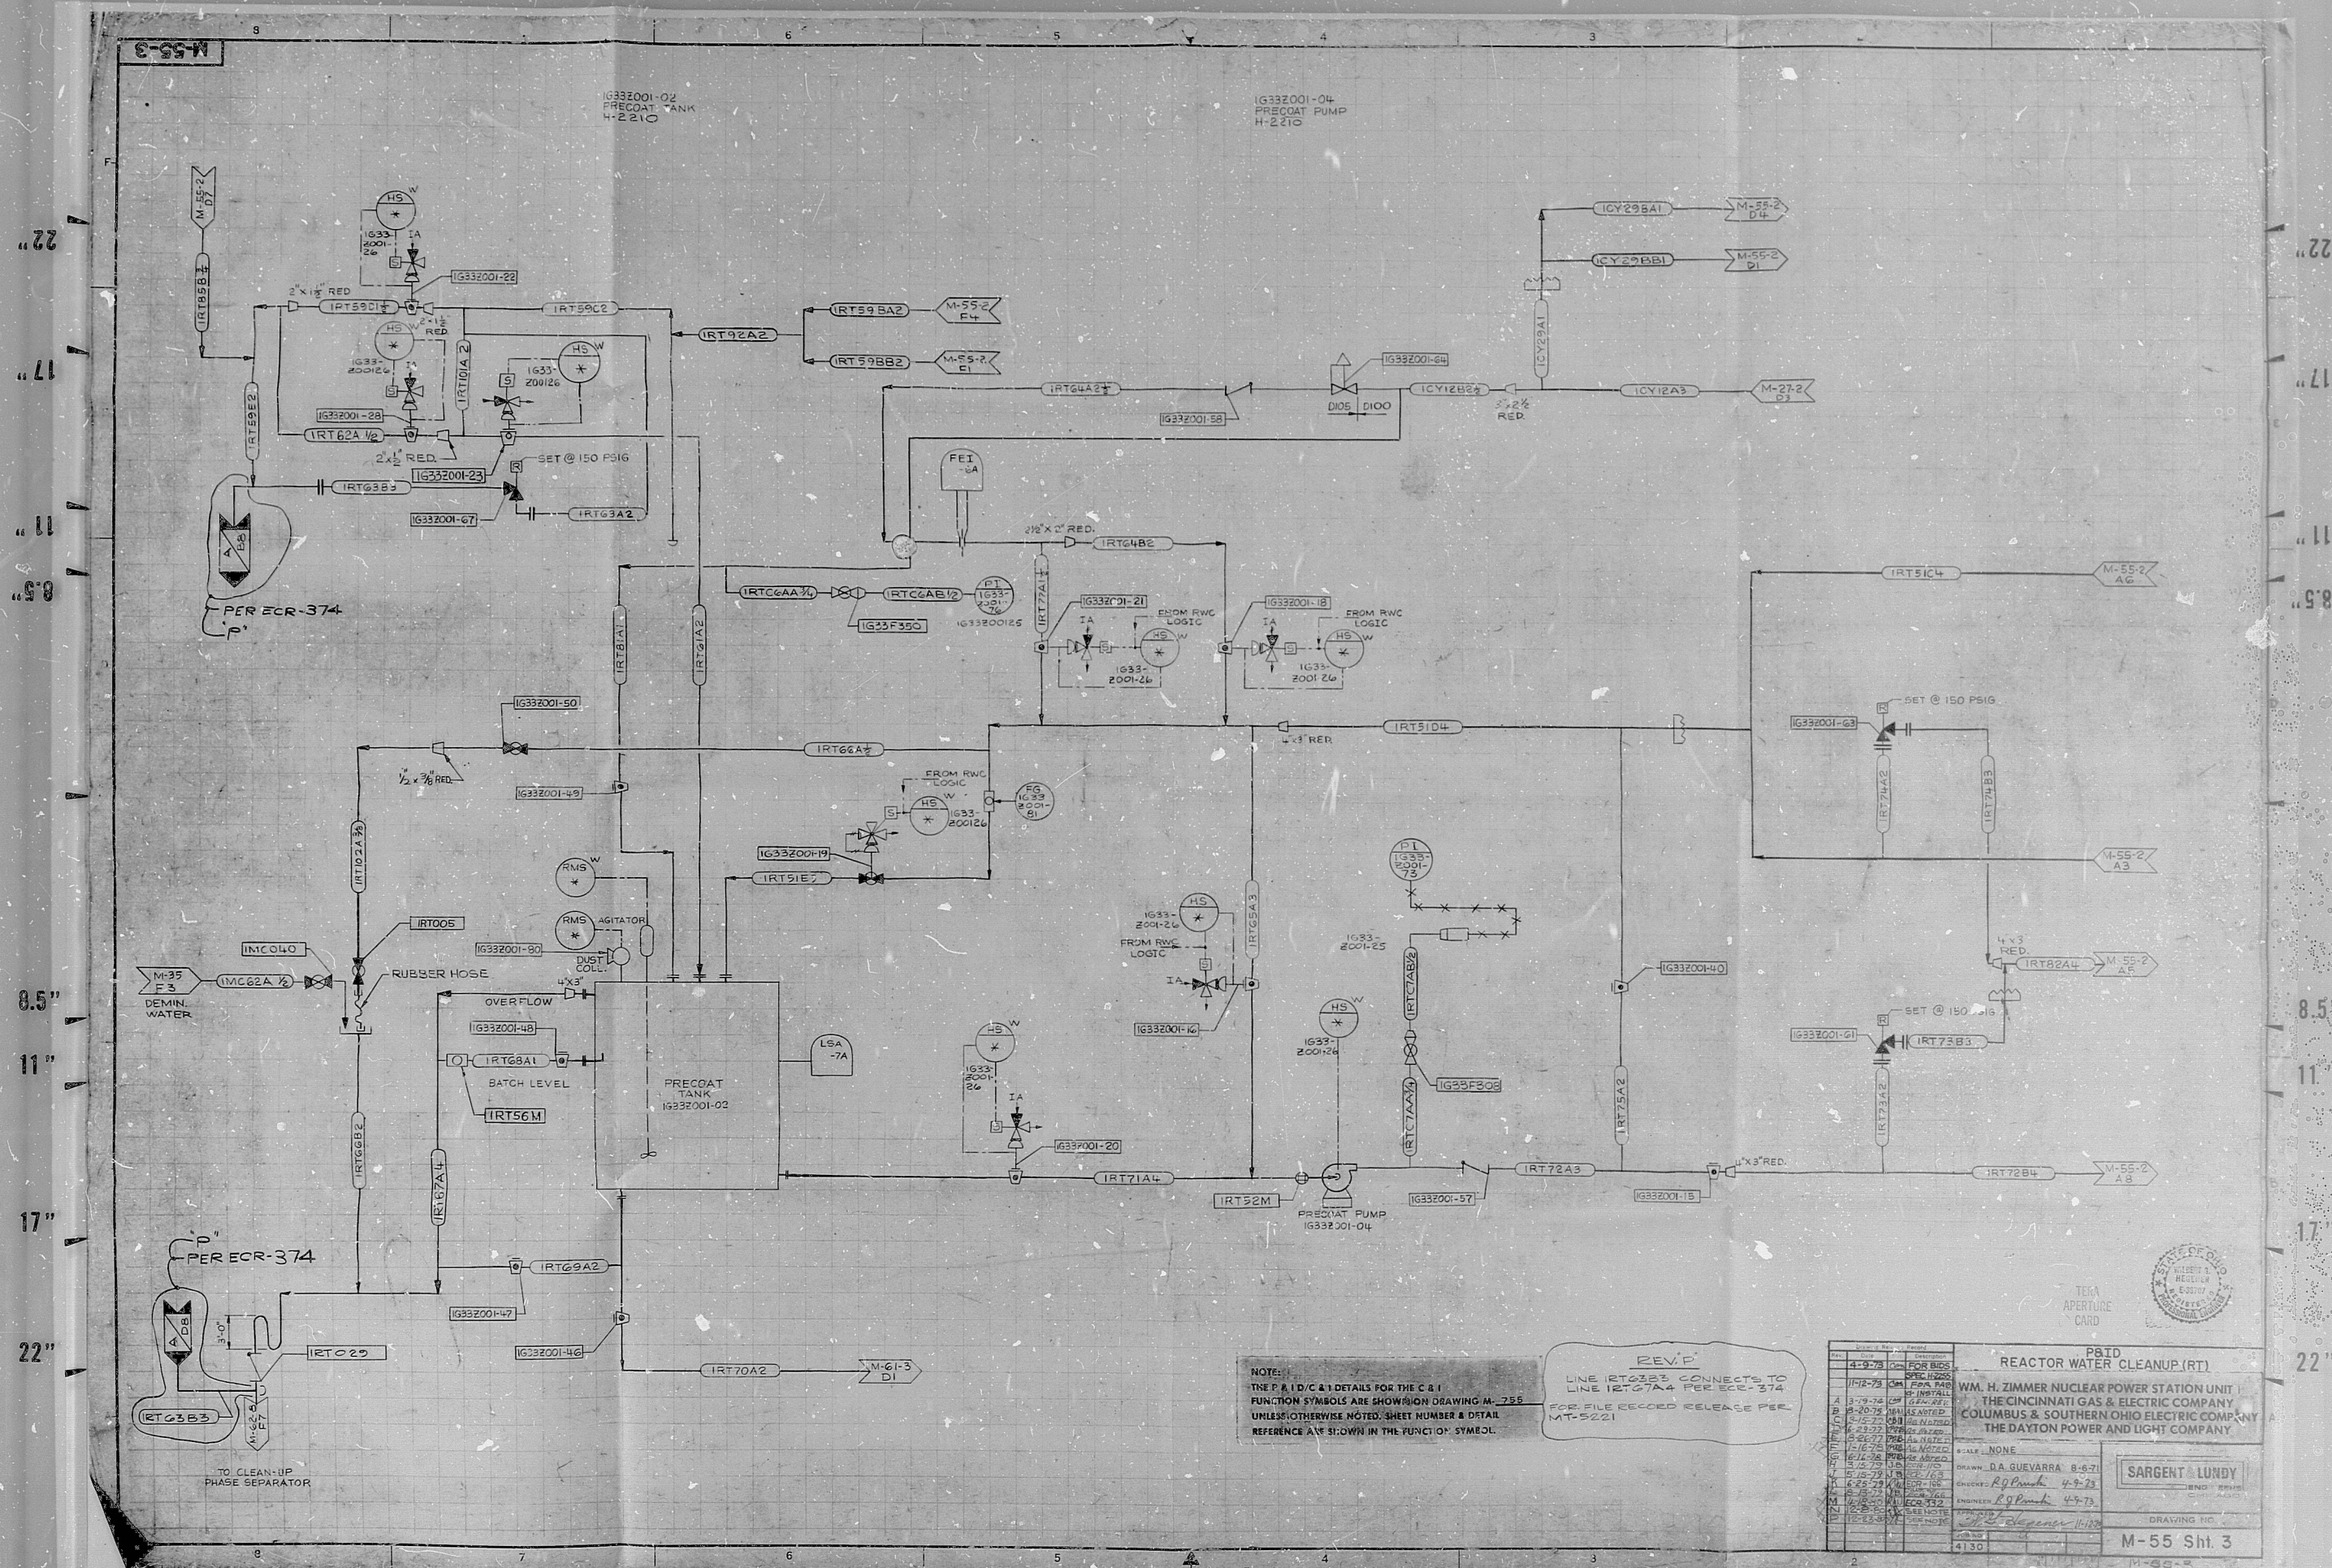

RDS-PDR

8104010383

