




PDR RIDS

9304290256

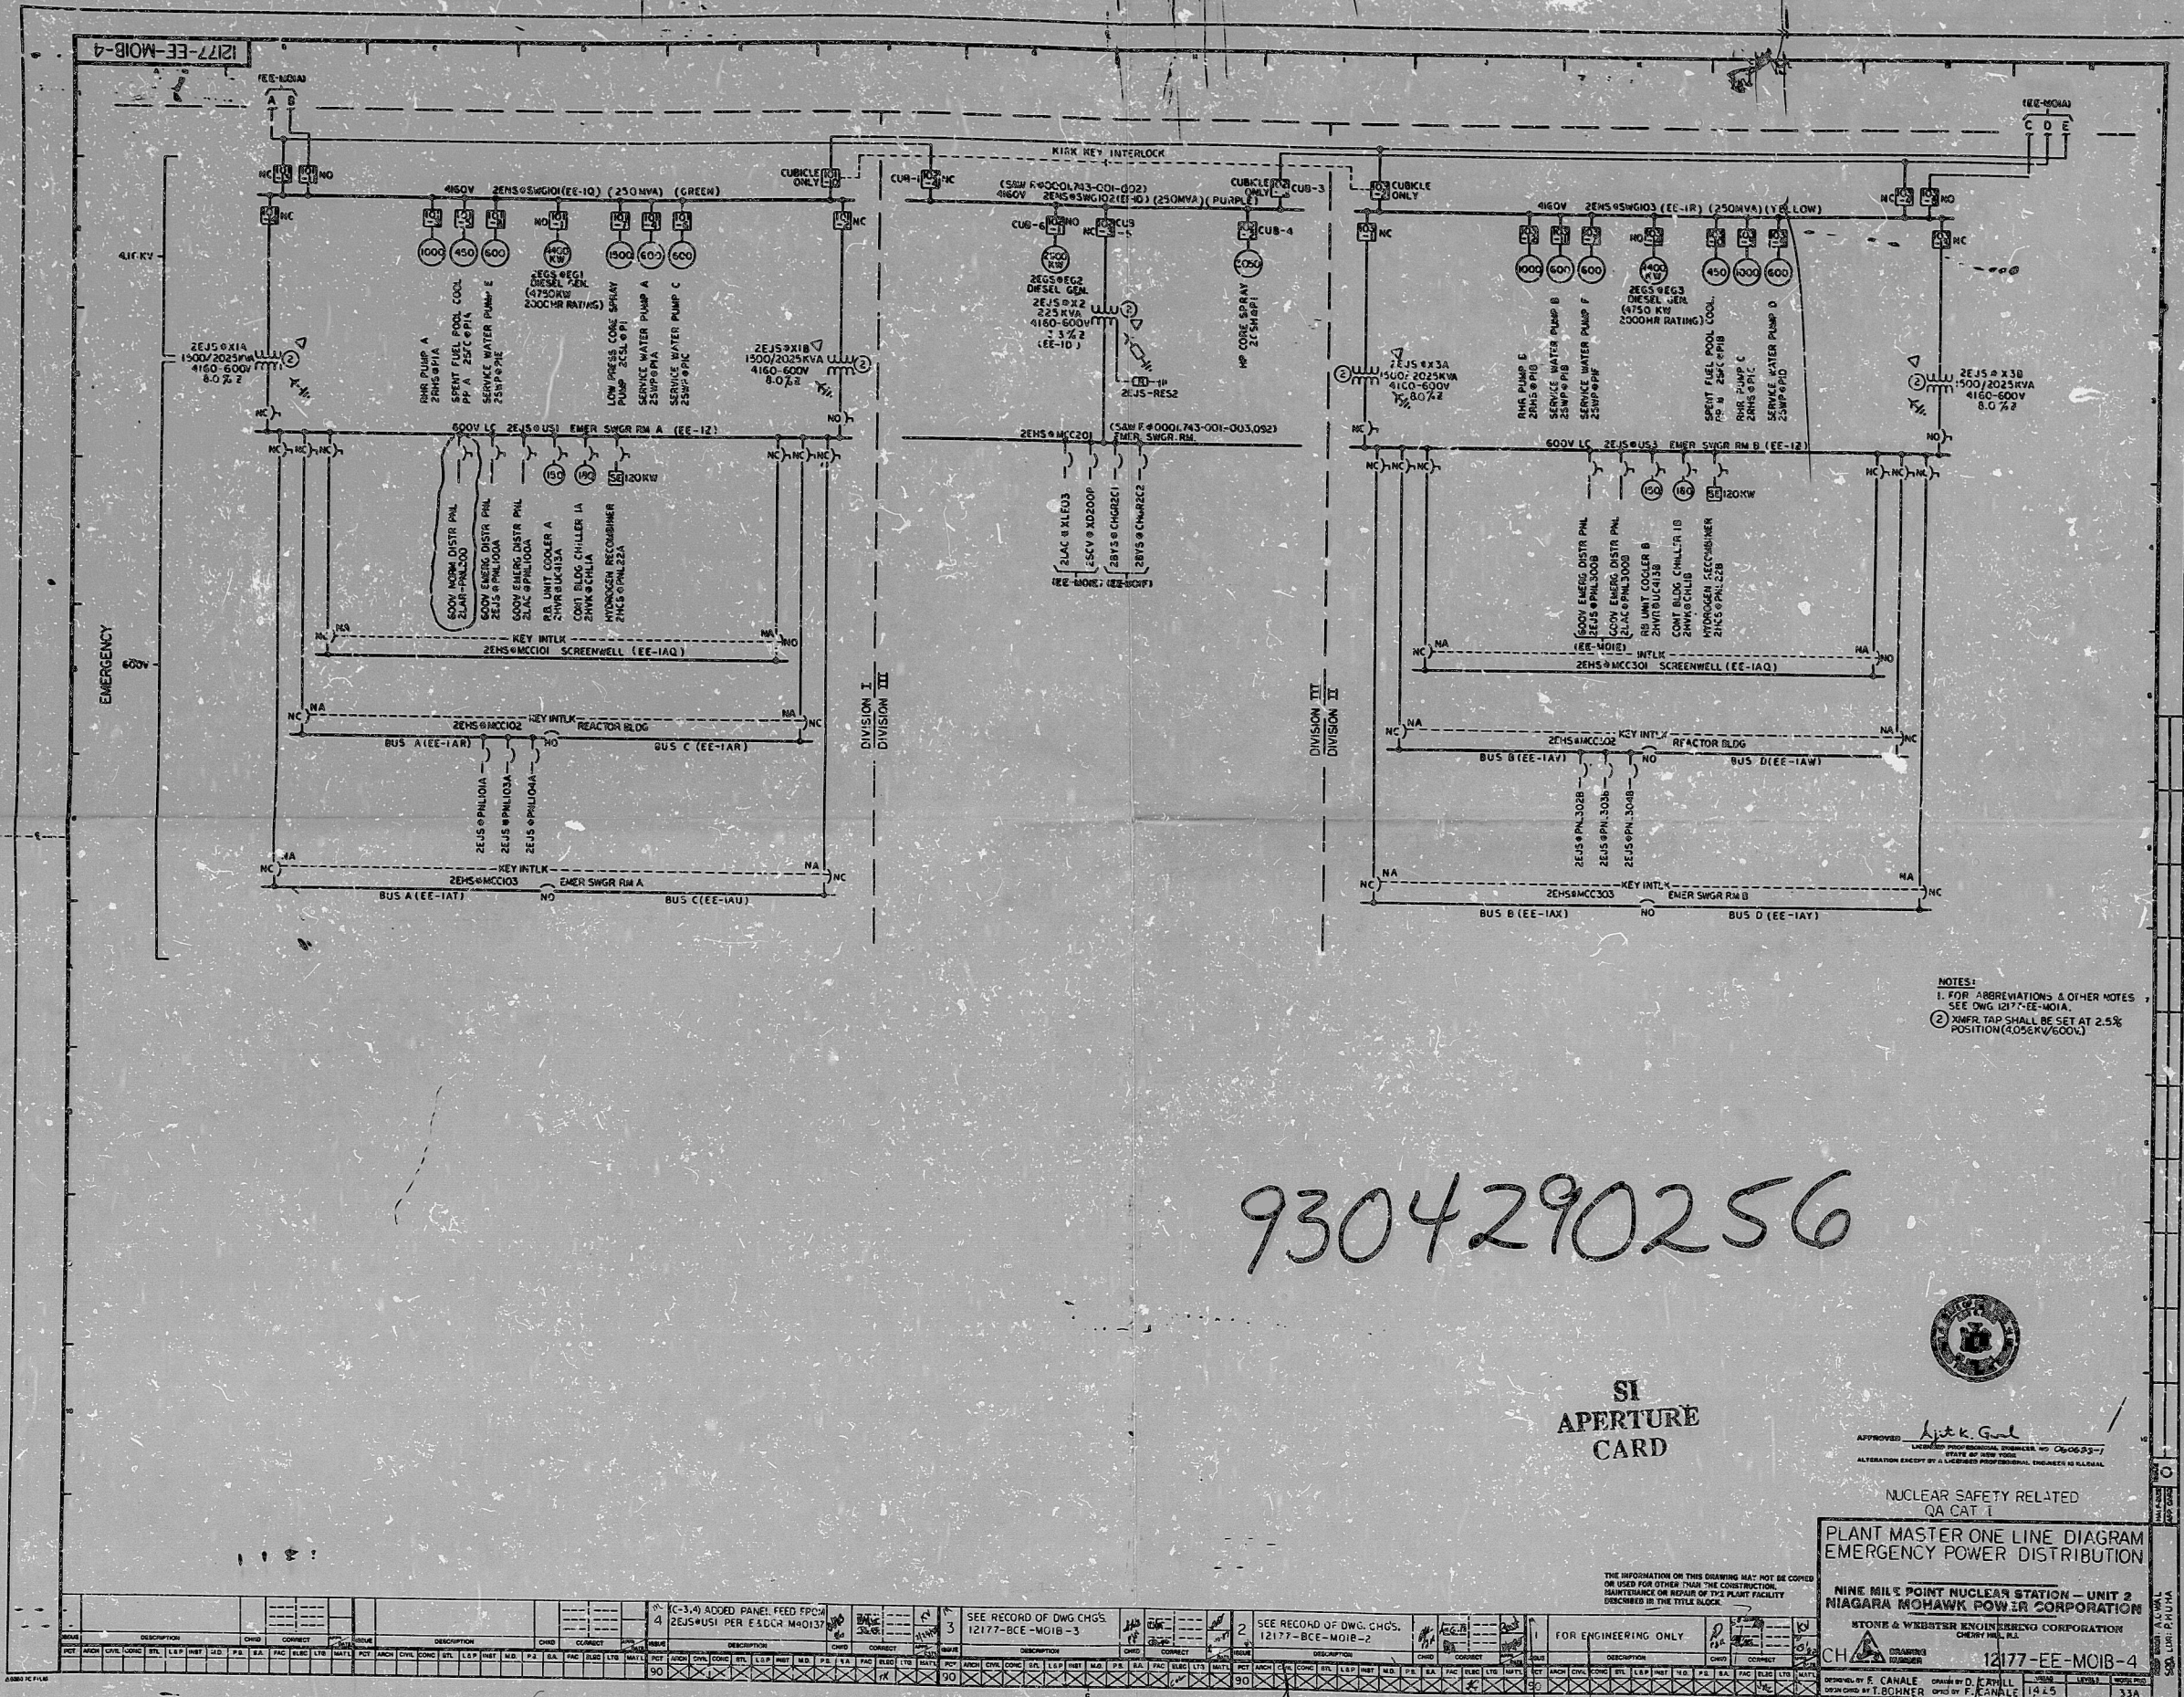