


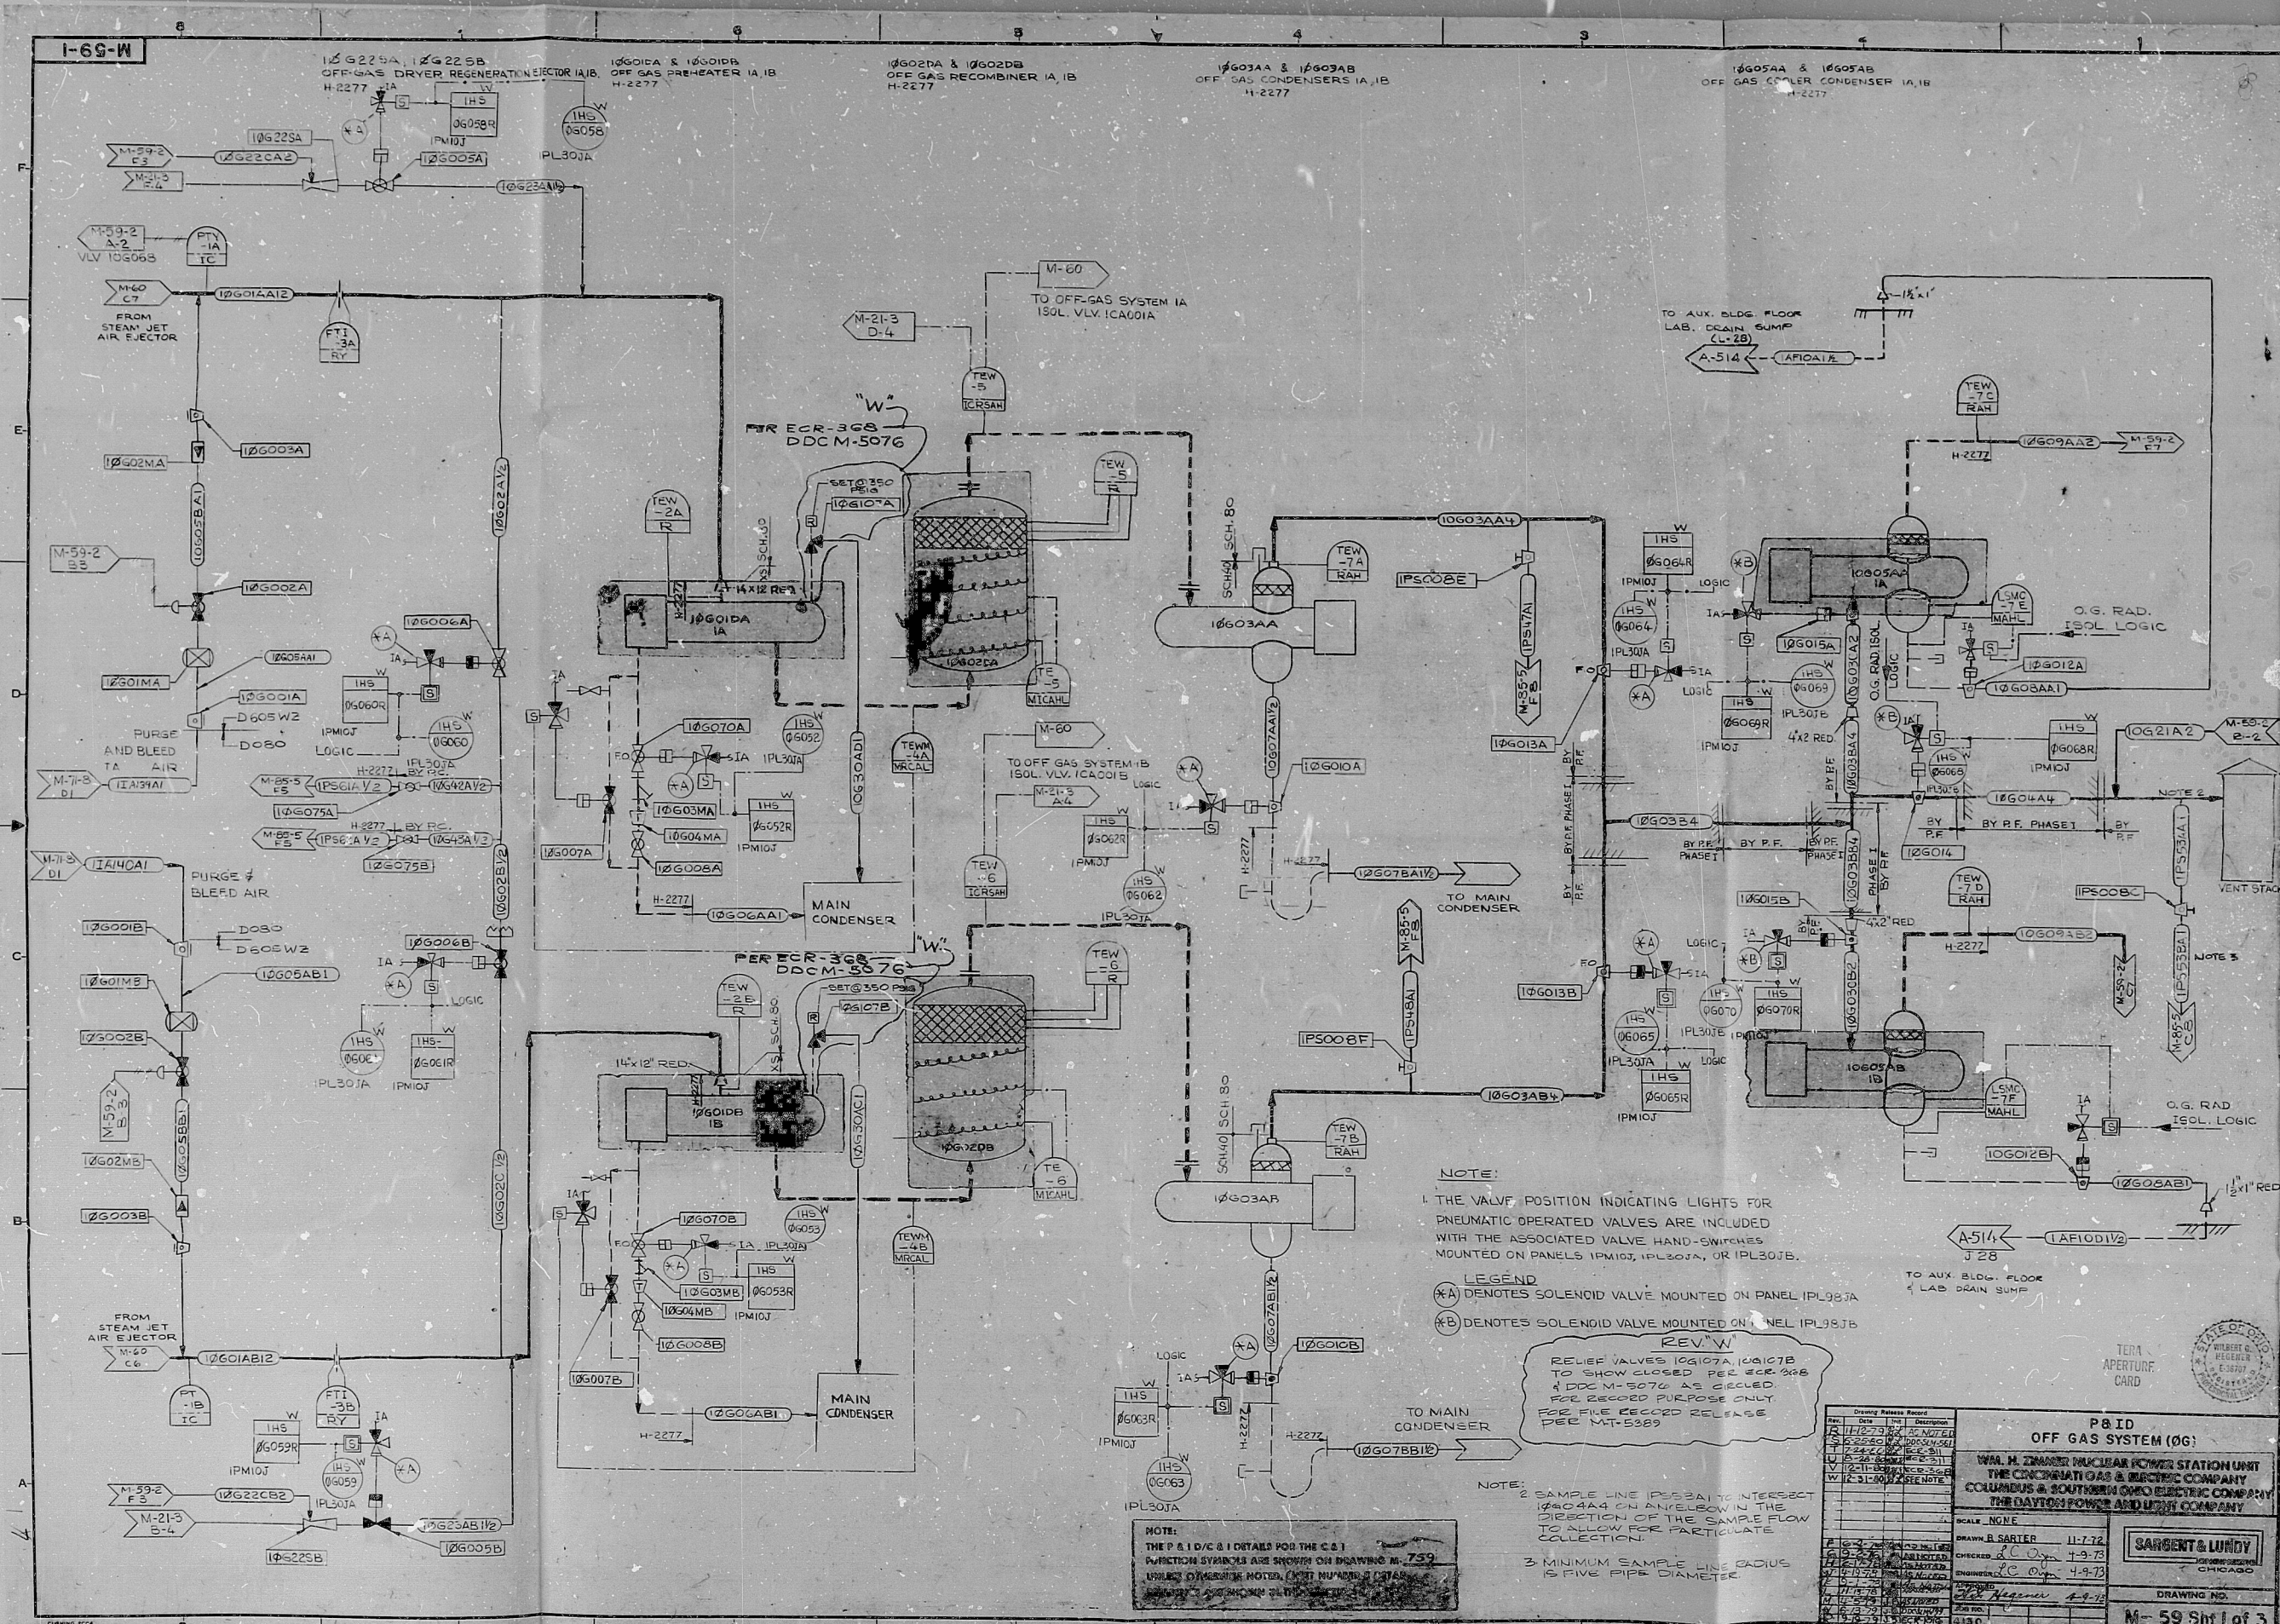

NOTE:
THE P & I D/C & I DETAILS FOR THE C & I
FUNCTION SYMBOLS ARE SHOWN ON DRAWING M-759
UNLESS OTHERWISE NOTED. (UNIT NUMBER & DETAILS
ARE SHOWN IN THE SCHEMATIC.)

NOTE:

1. THE VALVE POSITION INDICATING LIGHTS FOR PNEUMATIC OPERATED VALVES ARE INCLUDED WITH THE ASSOCIATED VALVE HAND-SWITCHES MOUNTED ON PANELS 1PM10J, 1PL30JA, OR 1PL30JB.

LEGEND
(*A) DENOTES SOLENOID VALVE MOUNTED ON PANEL IPL98JA
(*B) DENOTES SOLENOID VALVE MOUNTED ON PANEL IPL98JB

REV. "W"
RELIEF VALVES 10G107A, 10G107B
TO SHOW CLOSED PER ECR 300
& DDC M-5076 AS CIRCLED.
FOR RECORD PURPOSE ONLY.

NOTE:
2. SAMPLE LINE IP553A1 TO INTERSECT
IP404A4 ON AN ELBOW IN THE
DIRECTION OF THE SAMPLE FLOW
TO ALLOW FOR PARTICULATE

3 MINIMUM SAMPLE LINE RADIUS
IS FIVE PIPE DIAMETER.

Drawing Release Record		
Rev.	Date	Description

RDS-RDR

8104010394

