




RDS-RDR

804010397

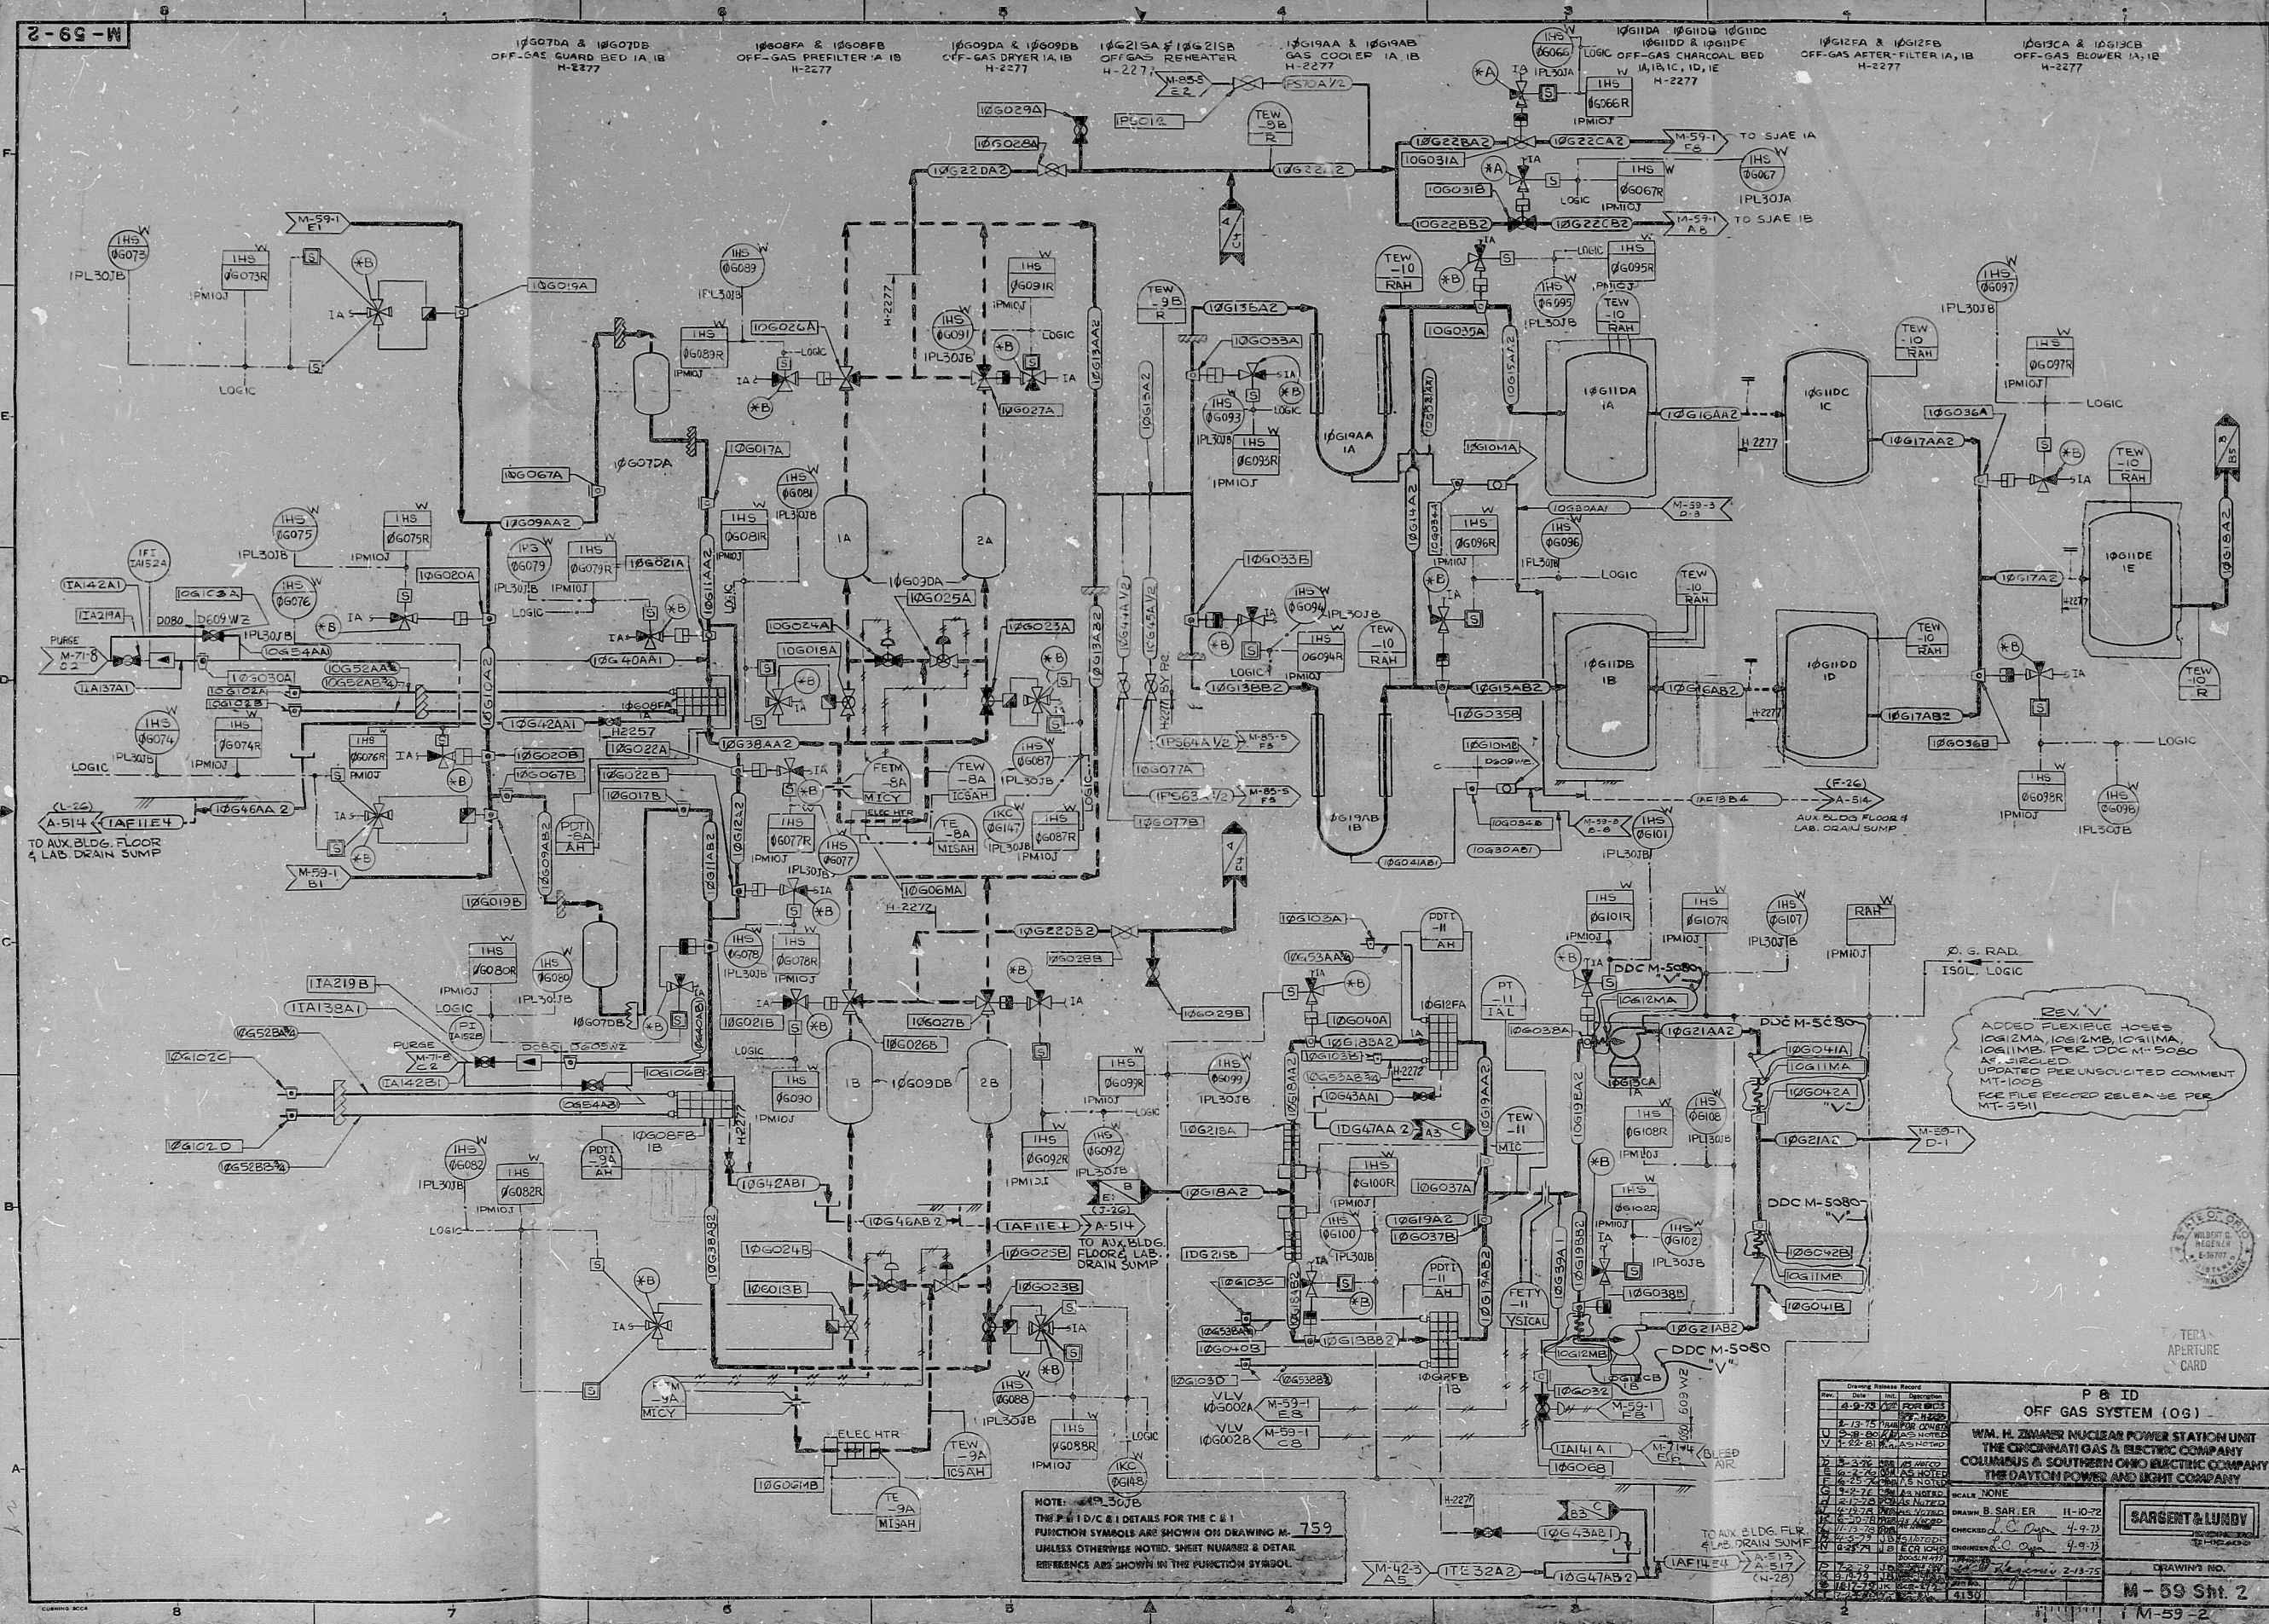