


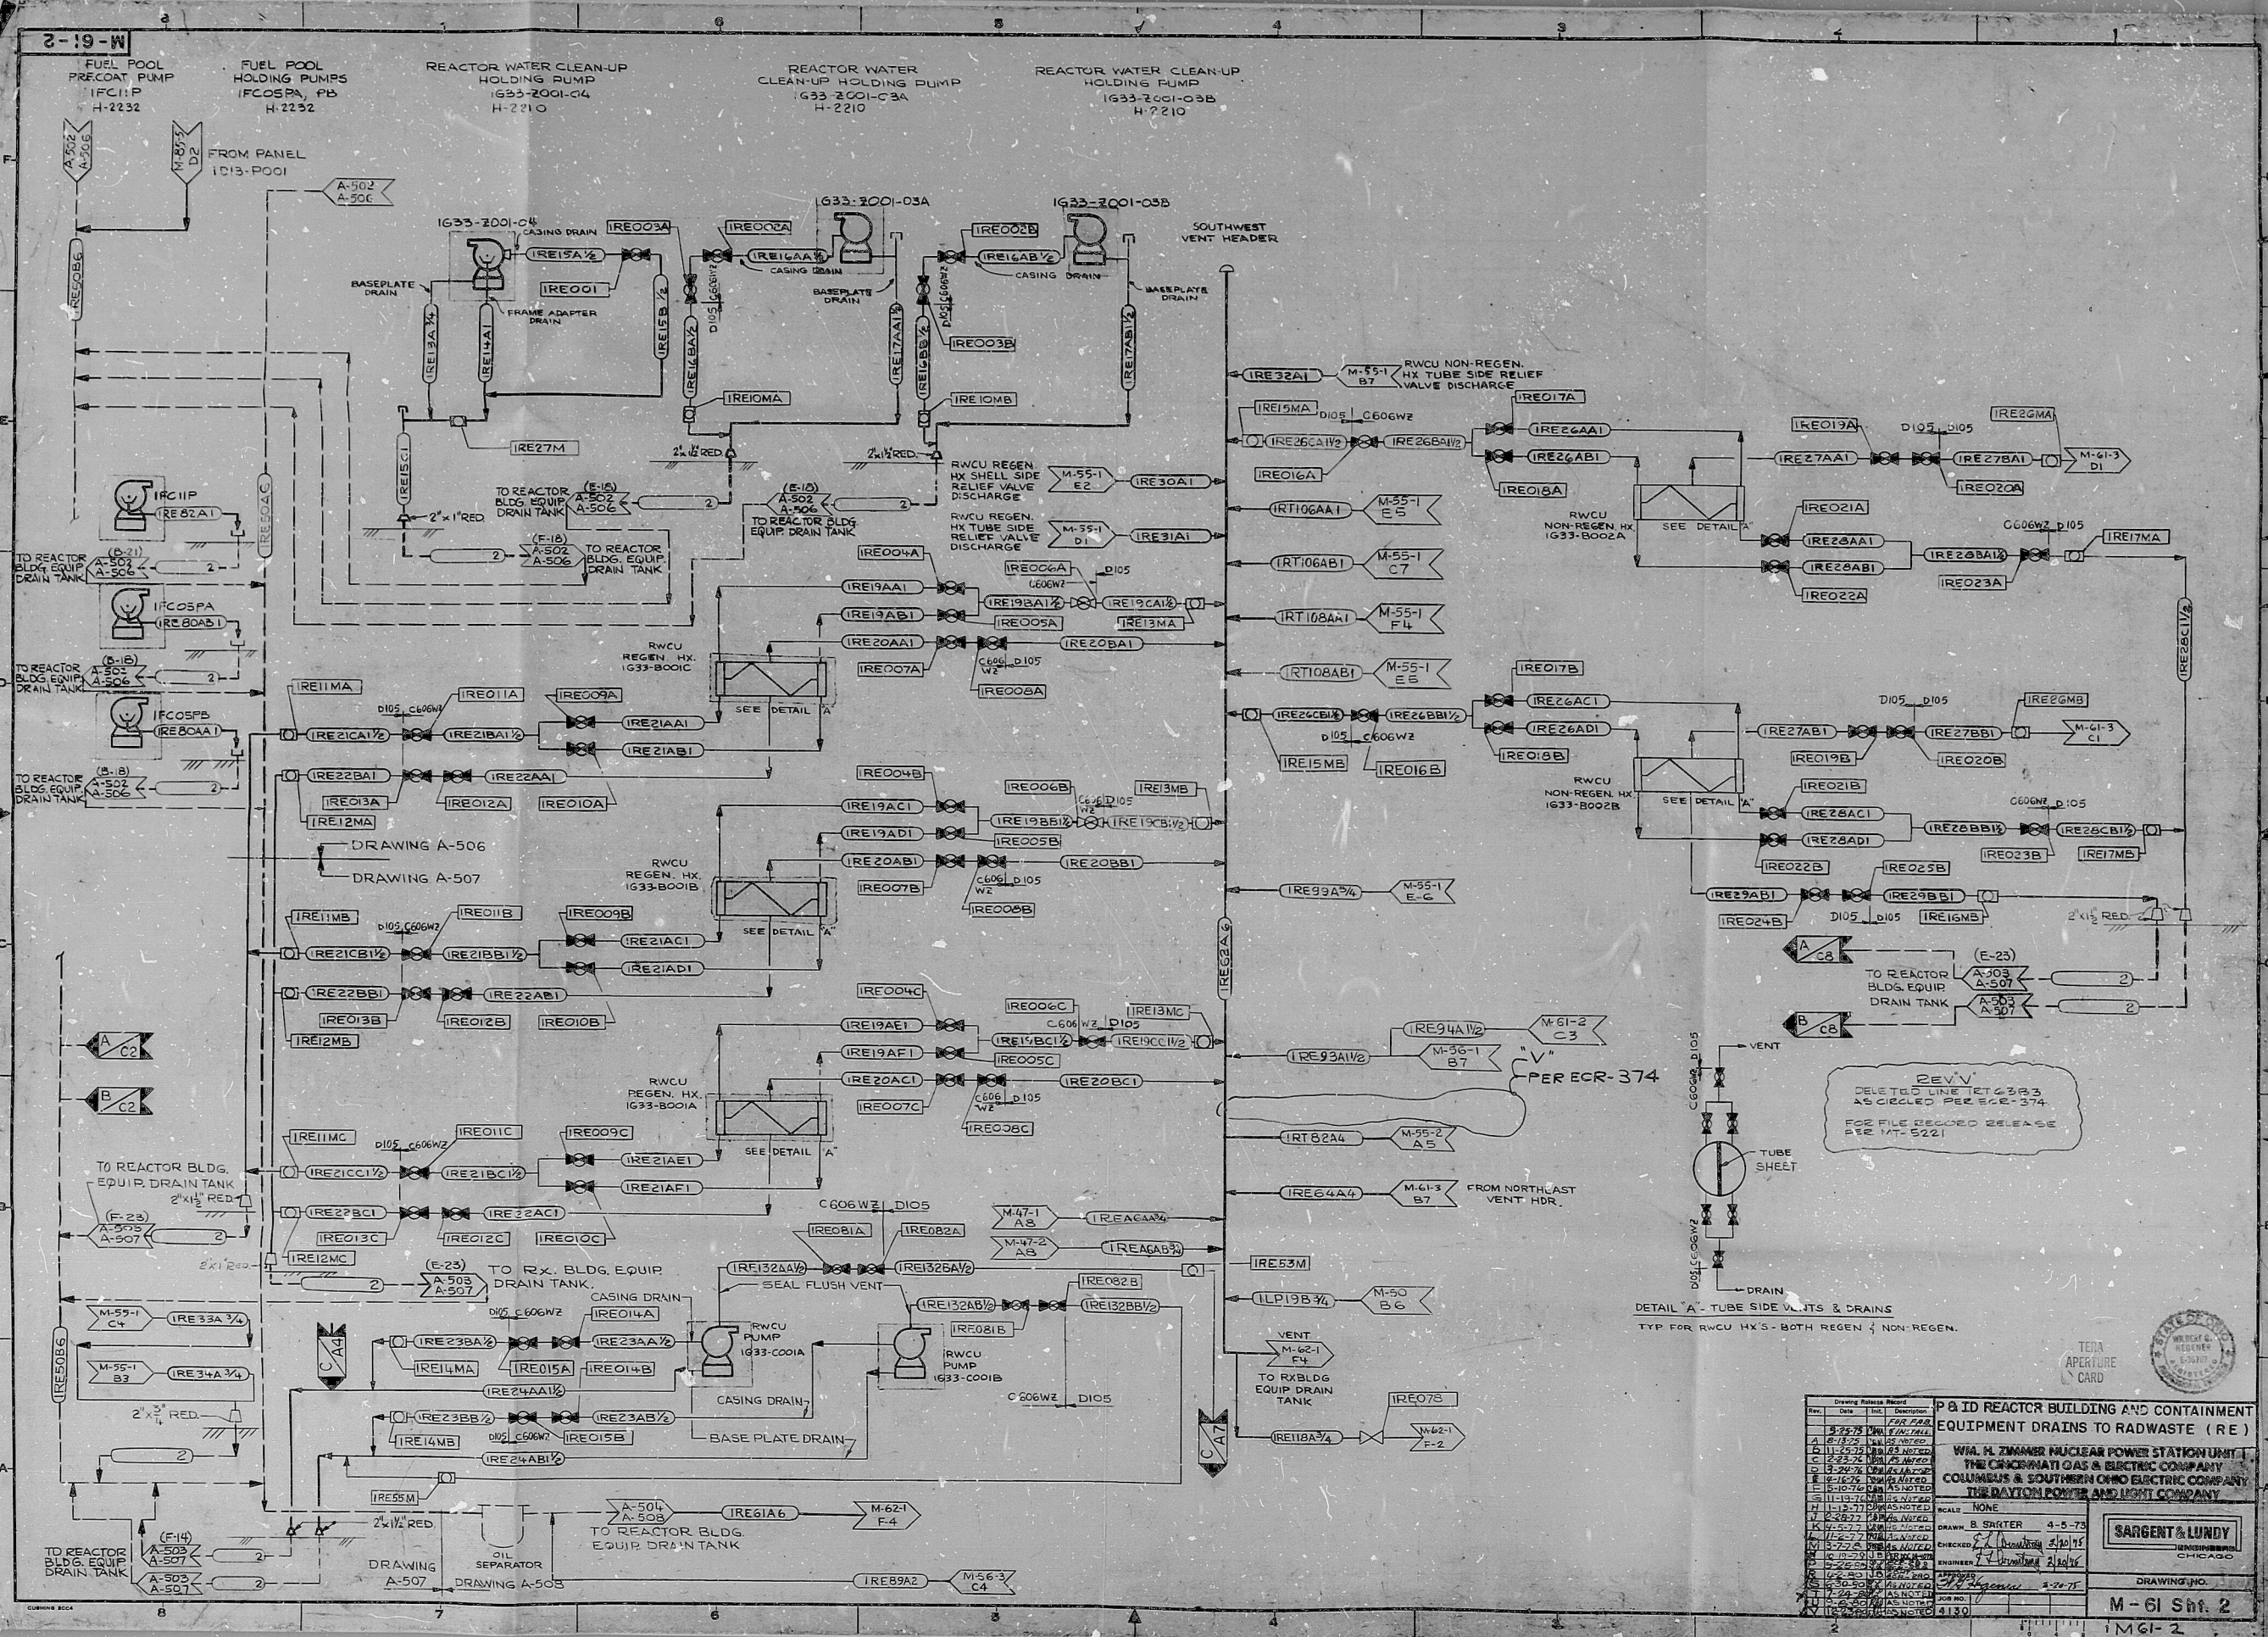

Drawing Release Record			
Rev.	Date	By	Description
SCALE: NONE

DRAWN: B. SARTER 4-5-75





W.M. ZIMMER NUCLEAR POWER STATION UNIT


COLUMBUS & SOUTHERN OHIO ELECTRIC COMPANY

THE DAYTON POWER AND LIGHT COMPANY

SARGENT & LUNDY

ENGINEERS

CHICAGO

ILLINOIS

DRAWING NO.

M-61 SH. 2

IM-61-2

RDS-RDR

8194019400

