12177-EE-M010-9

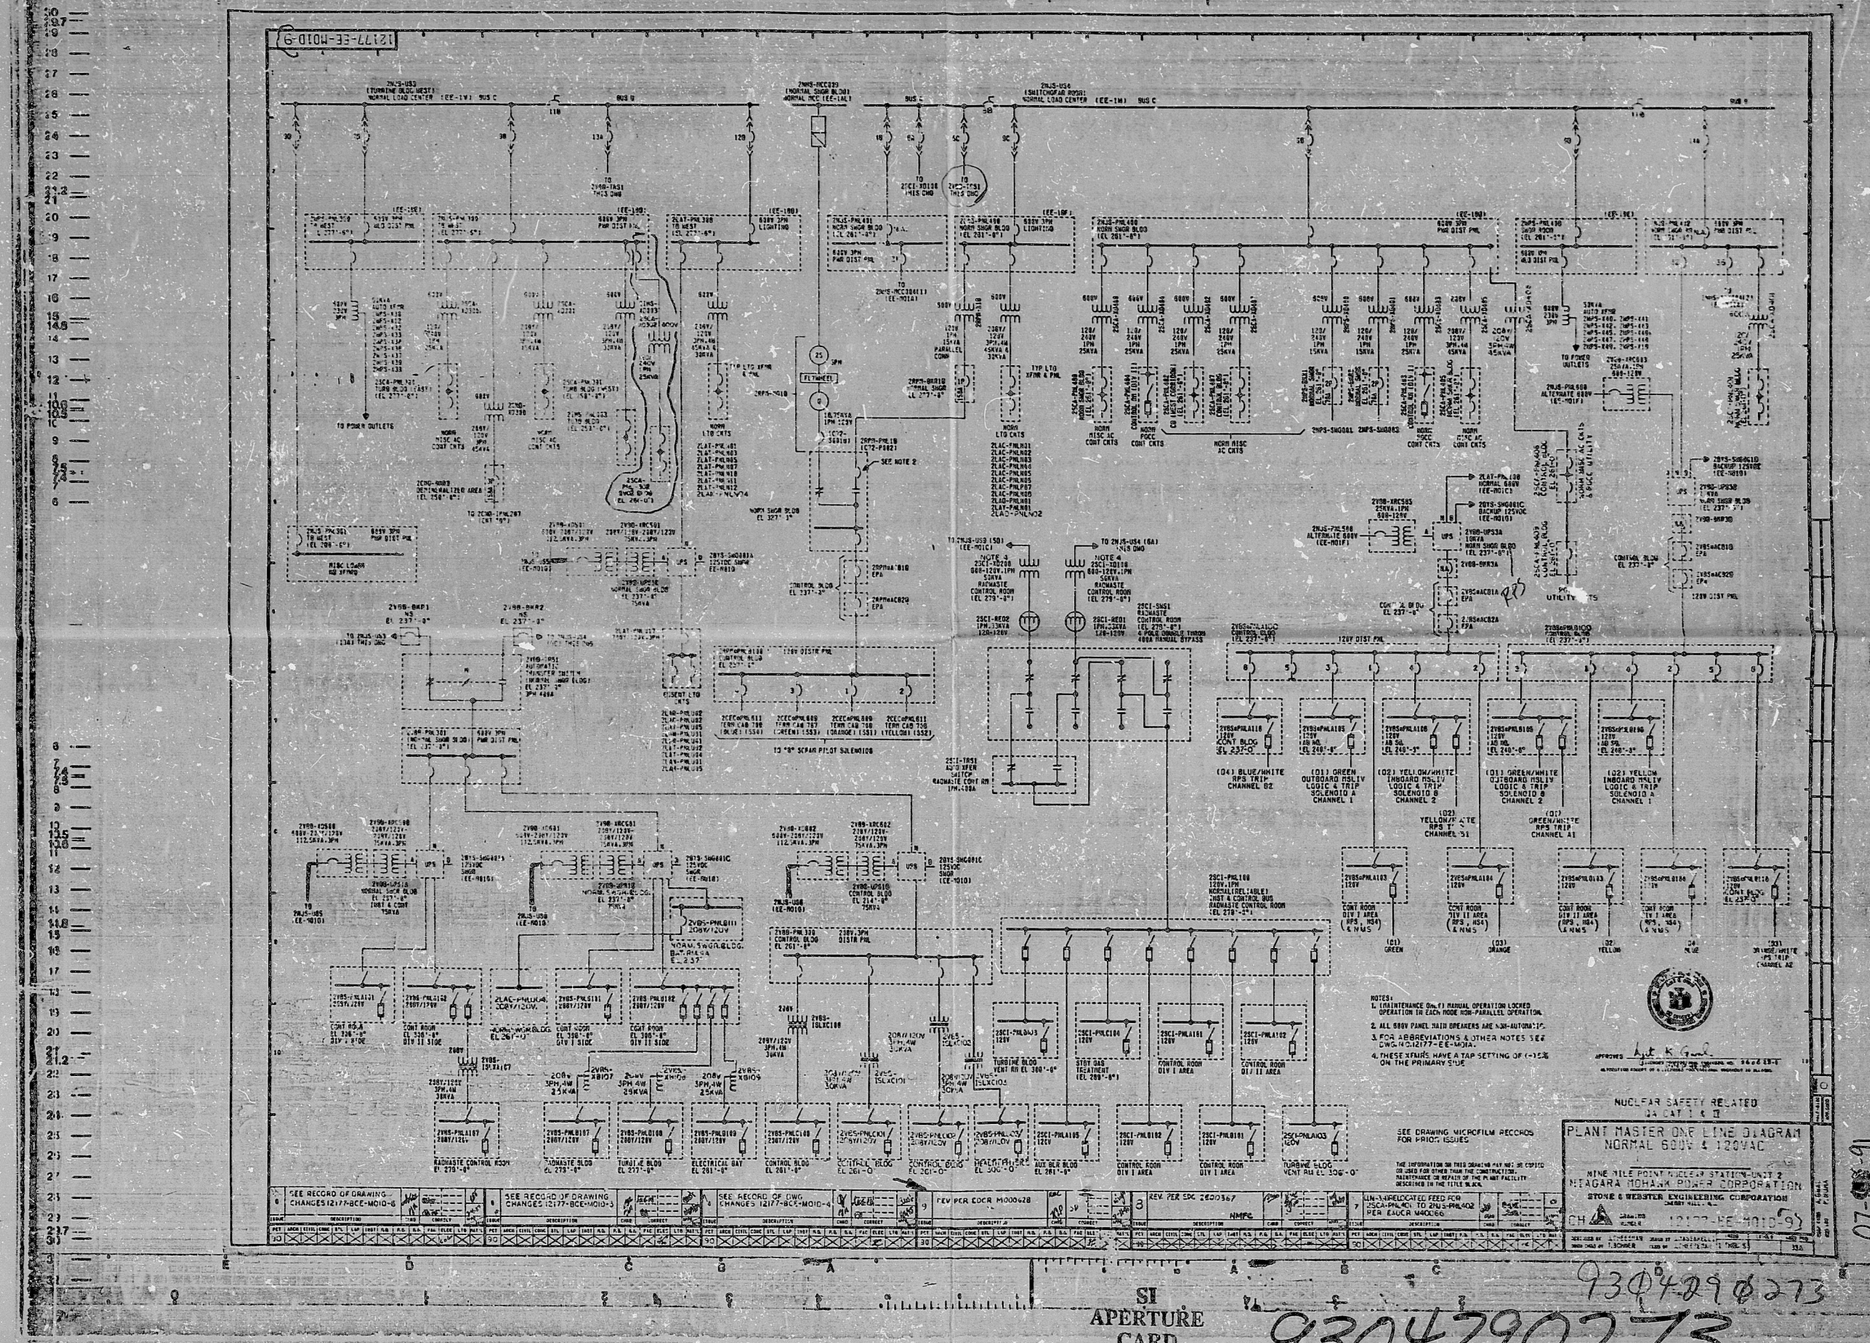

SI APERTURE CARD

930429027 3

930429027 3

PDR RIDS

9304290273

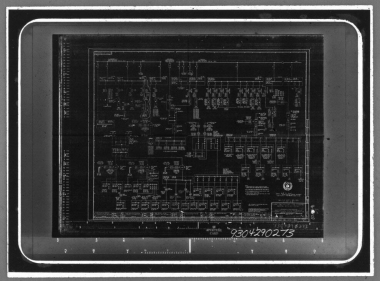

MMM 5824 · FILMSORT® & DUPLICARD® Cards

3M, St. Paul, MN.