


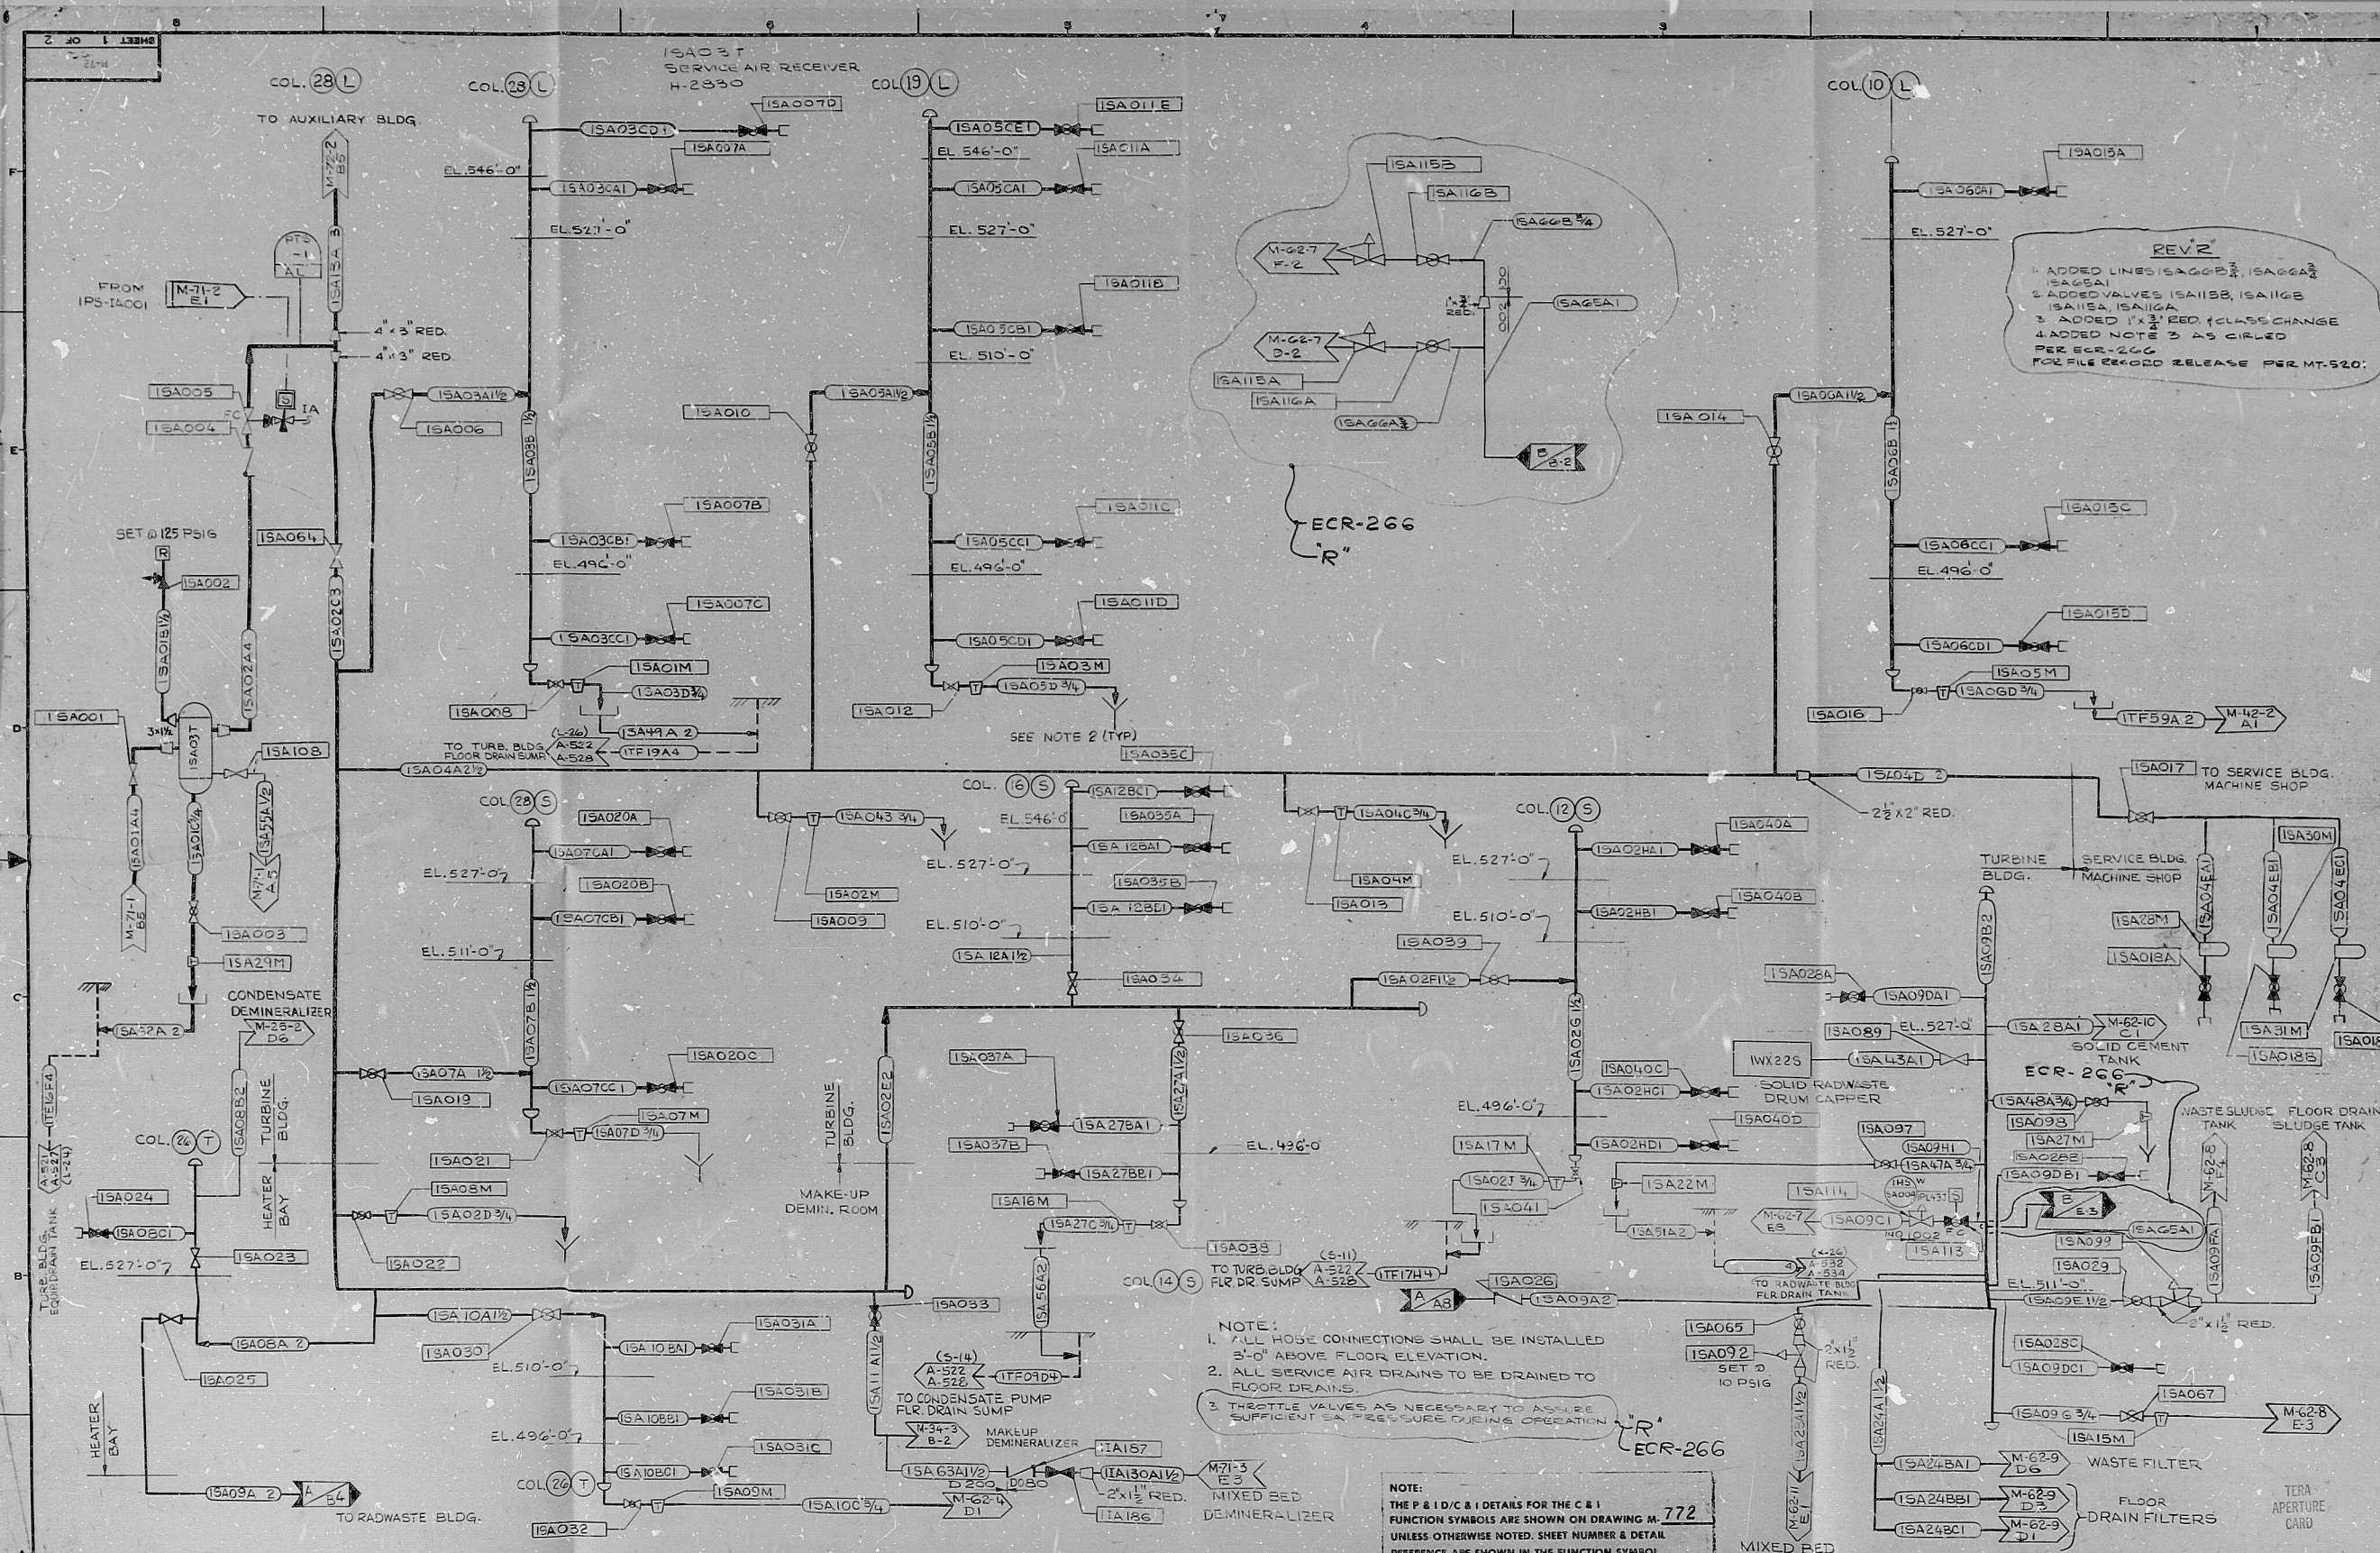

DRAWING RELEASE RECORD					DRAWING RELEASE RECORD				
REV.	SPEC. NO.	DATE	DRAWN	CHECKED	ENGR. APPROVAL	DESCRIPTION	REV.	SPEC. NO.	DATE






THE P & I D/C & I DETAILS FOR THE C & I FUNCTION SYMBOLS ARE SHOWN ON DRAWING M-772 UNLESS OTHERWISE NOTED. SHEET NUMBER & DETAIL REFERENCE ARE SHOWN IN THE FUNCTION SYMBOL.

NOTE:
1. ALL HOSE CONNECTIONS SHALL BE INSTALLED 3'-0" ABOVE FLOOR ELEVATION.
2. ALL SERVICE AIR DRAINS TO BE DRAINED TO FLOOR DRAINS.
3. THROTTLE VALVES ARE NECESSARY TO ASSURE SUFFICIENT AIR PRESSURE DURING OPERATION.

REVISION
M-72

REVISION
R









RDS-2012

8104010412

