


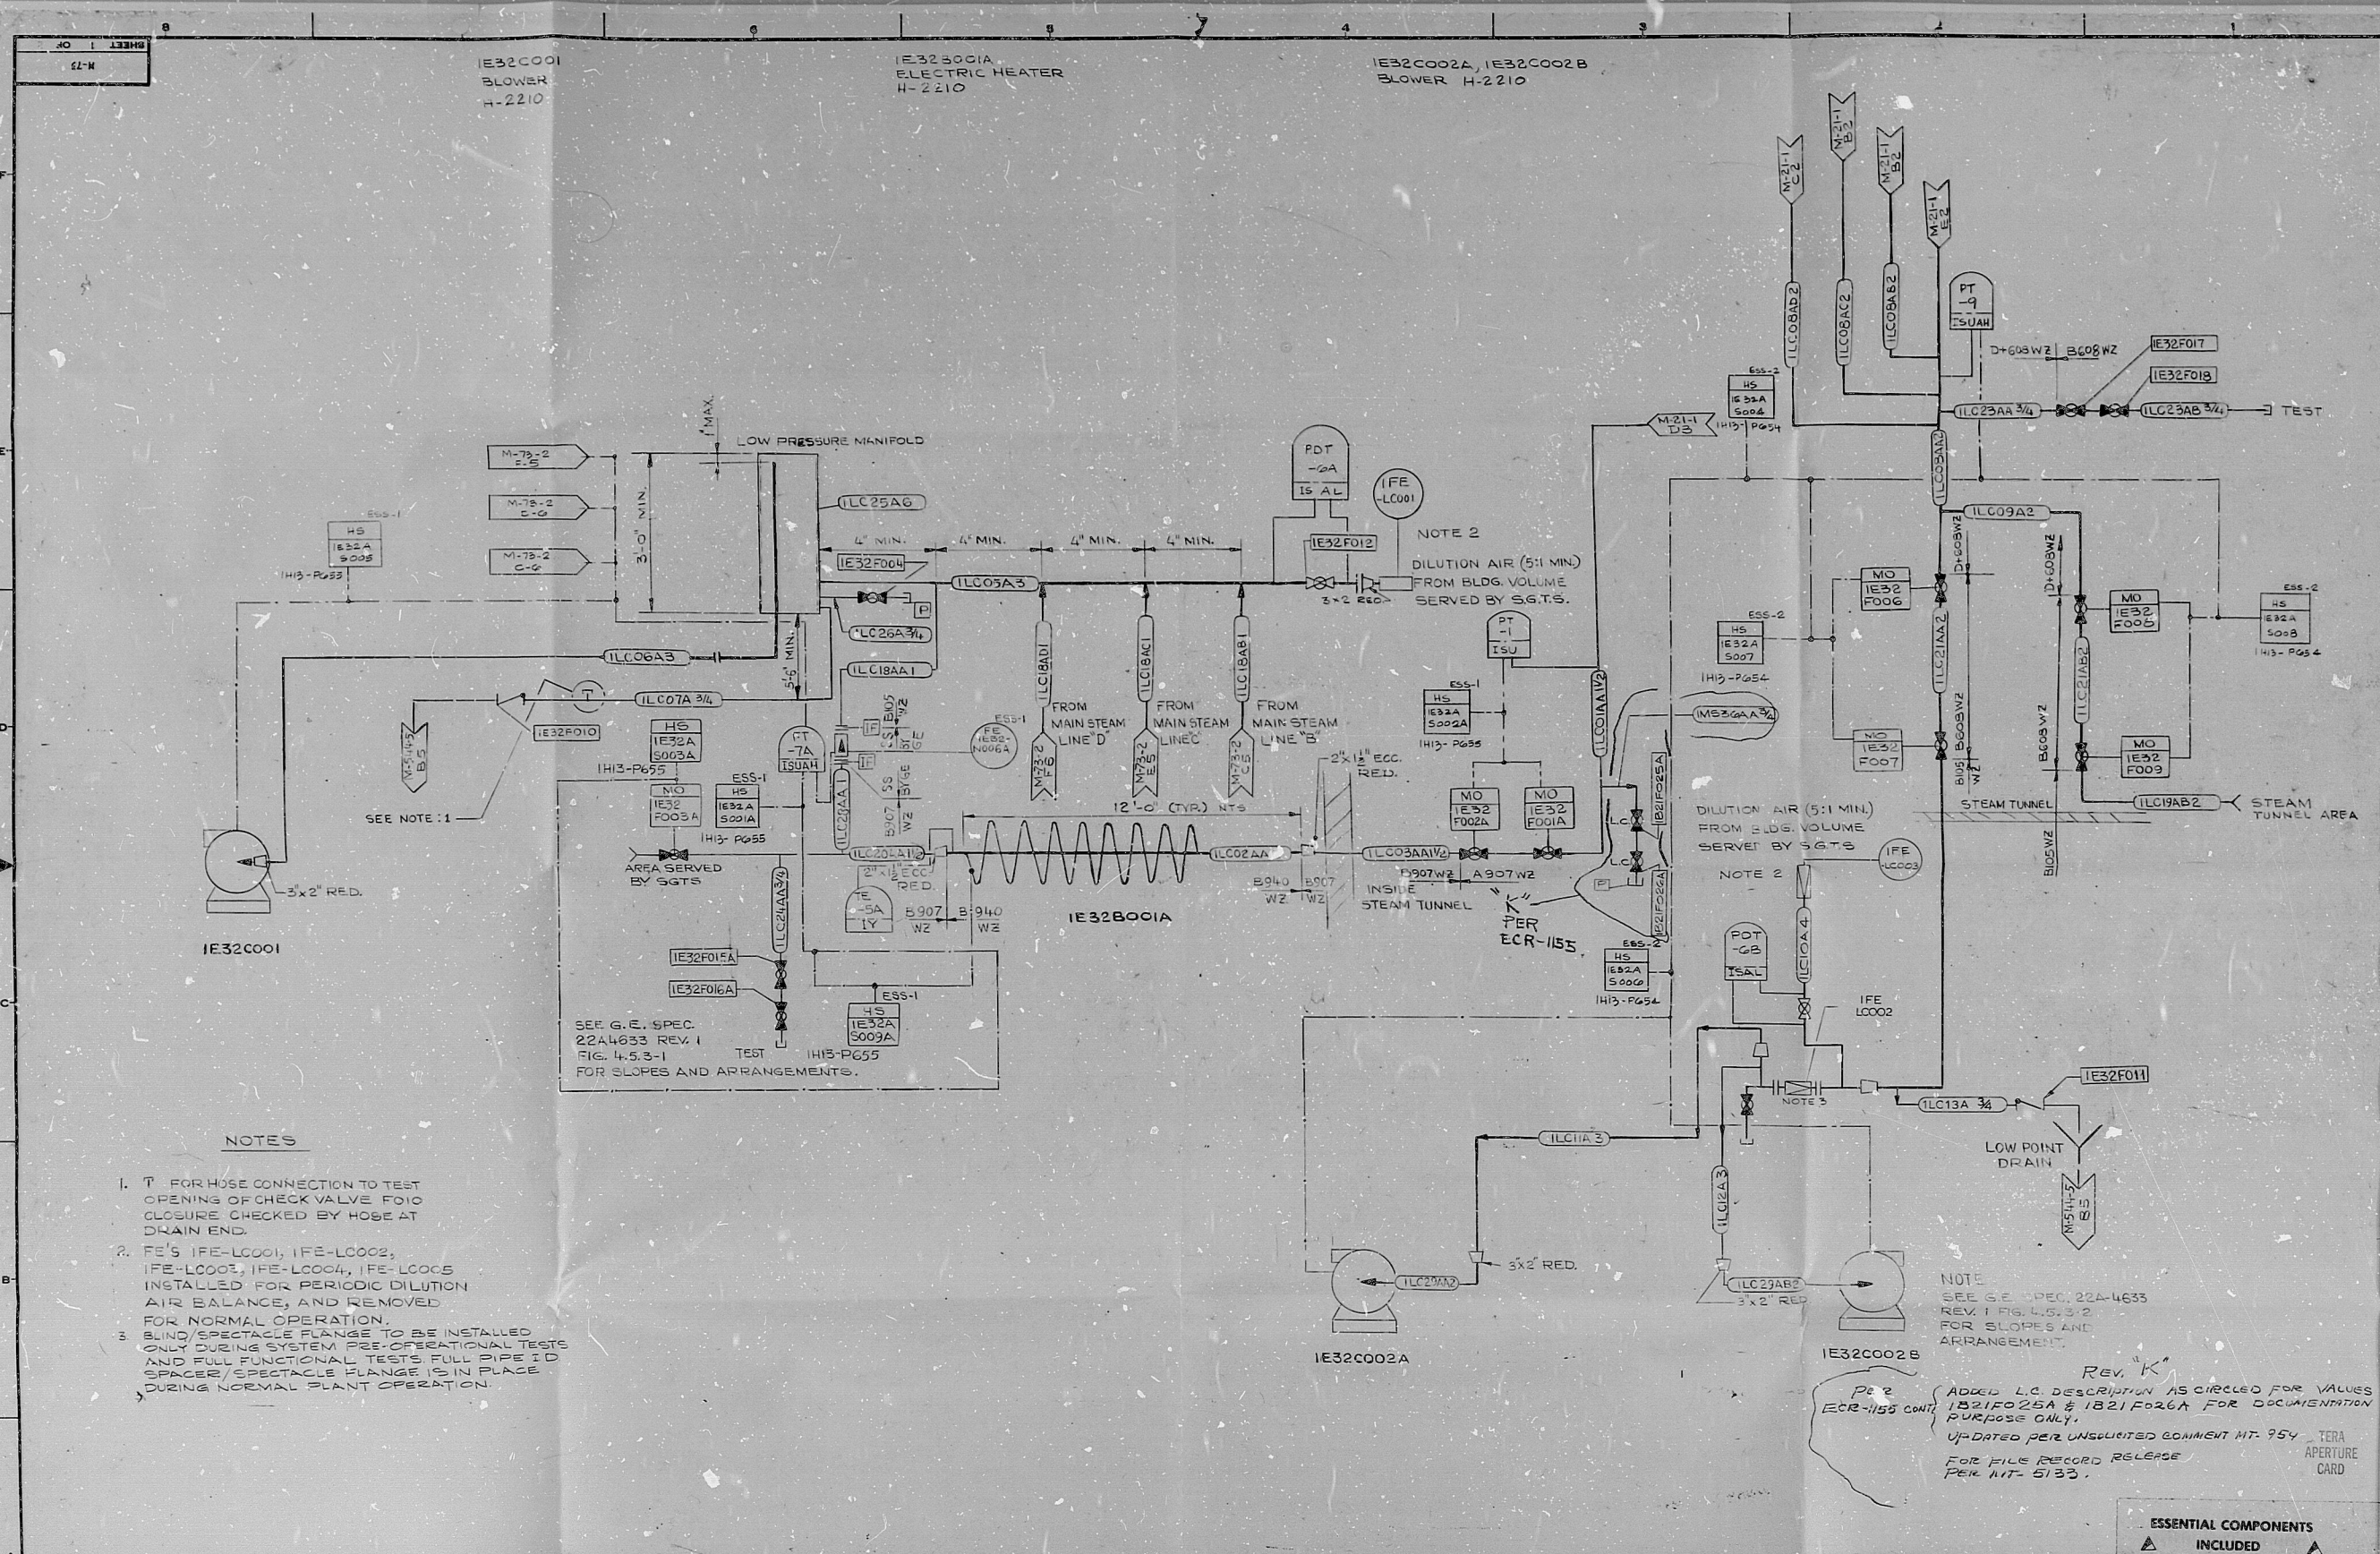

- NOTES**
1. T - FOR HOSE CONNECTION TO TEST OPENING OF CHECK VALVE FOIC CLOSURE CHECKED BY HOSE AT DRAIN END.
 2. FE'S IFE-LC001, IFE-LC002, IFE-LC003, IFE-LC004, IFE-LC005 INSTALLED FOR PERIODIC DILUTION AIR BALANCE, AND REMOVED FOR NORMAL OPERATION.
 3. BLIND/SPECTACLE FLANGE TO BE INSTALLED ONLY DURING SYSTEM PRE-OPERATIONAL TESTS AND FULL FUNCTIONAL TESTS. FULL PIPE ID SPACER/SPECTACLE FLANGE IS IN PLACE DURING NORMAL PLANT OPERATION.

DRAWING RELEASE RECORD										DRAWING RELEASE RECORD									
REV.	SPEC. NO.	DATE	DRAWN	CHECKED	ENGR. APPROVAL	DESCRIPTION	FILM	REV.	SPEC. NO.	DATE	DRAWN	CHECKED	ENGR. APPROVAL	DESCRIPTION	FILM				
A	H-2255	12-17-75	W. J. [illegible]	[illegible]	[illegible]	FOR FABRICATION AND INSTALLATION		J	H-2255	10-20-80	A. C. [illegible]	[illegible]	[illegible]	SEE NOTE REVISION "J"					
B	H-2255	11-19-76	[illegible]	[illegible]	[illegible]	SEE REVISION NOTE "B"		K	H-2255	11-12-80	A. C. [illegible]	[illegible]	[illegible]	SEE NOTE REVISION "K"					
C	H-2255	6-6-77	[illegible]	[illegible]	[illegible]	SEE REVISION NOTE "C"													
D	H-2255	11-17-77	[illegible]	[illegible]	[illegible]	SEE NOTE REVISION "D"													
DO NOT USE 1, 0, 0, 1 OR 2 FOR REVISION!																			

PROJECT NUMBER				DRAWING NUMBER	
1157				4190	
MSV LEAKAGE CONTROL SYSTEM (LC)				ENGINEERS CHICAGO	
W. H. ZIMMER NUCLEAR POWER STATION UNIT-1				DRAWING NO. REV.	
COLUMBUS & SOUTHERN OHIO ELECTRIC COMPANY				N-73	
THE DAYTON POWER AND LIGHT COMPANY				SHEET 1 OF 2	

SARGENT & LUNDY	
ENGINEERS CHICAGO	

PROJECT NUMBER	1150
DATE	11-17-77
BY	[illegible]
CHECKED	[illegible]
APPROVED	[illegible]

MSIV LEAKAGE CONTROL SYSTEM (LCS)
M.H. ZIMMER NUCLEAR POWER STATION UNIT-1
THE CHINTWATI GAS & ELECTRIC COMPANY
COLUMBUS & SOUTHERN OHIO ELECTRIC COMPANY
THE DAYTON POWER AND LIGHT COMPANY

DRAWING NO.	M-73
REV.	1
SHEET	1 OF 2

RDS-PD12

8104010416

