


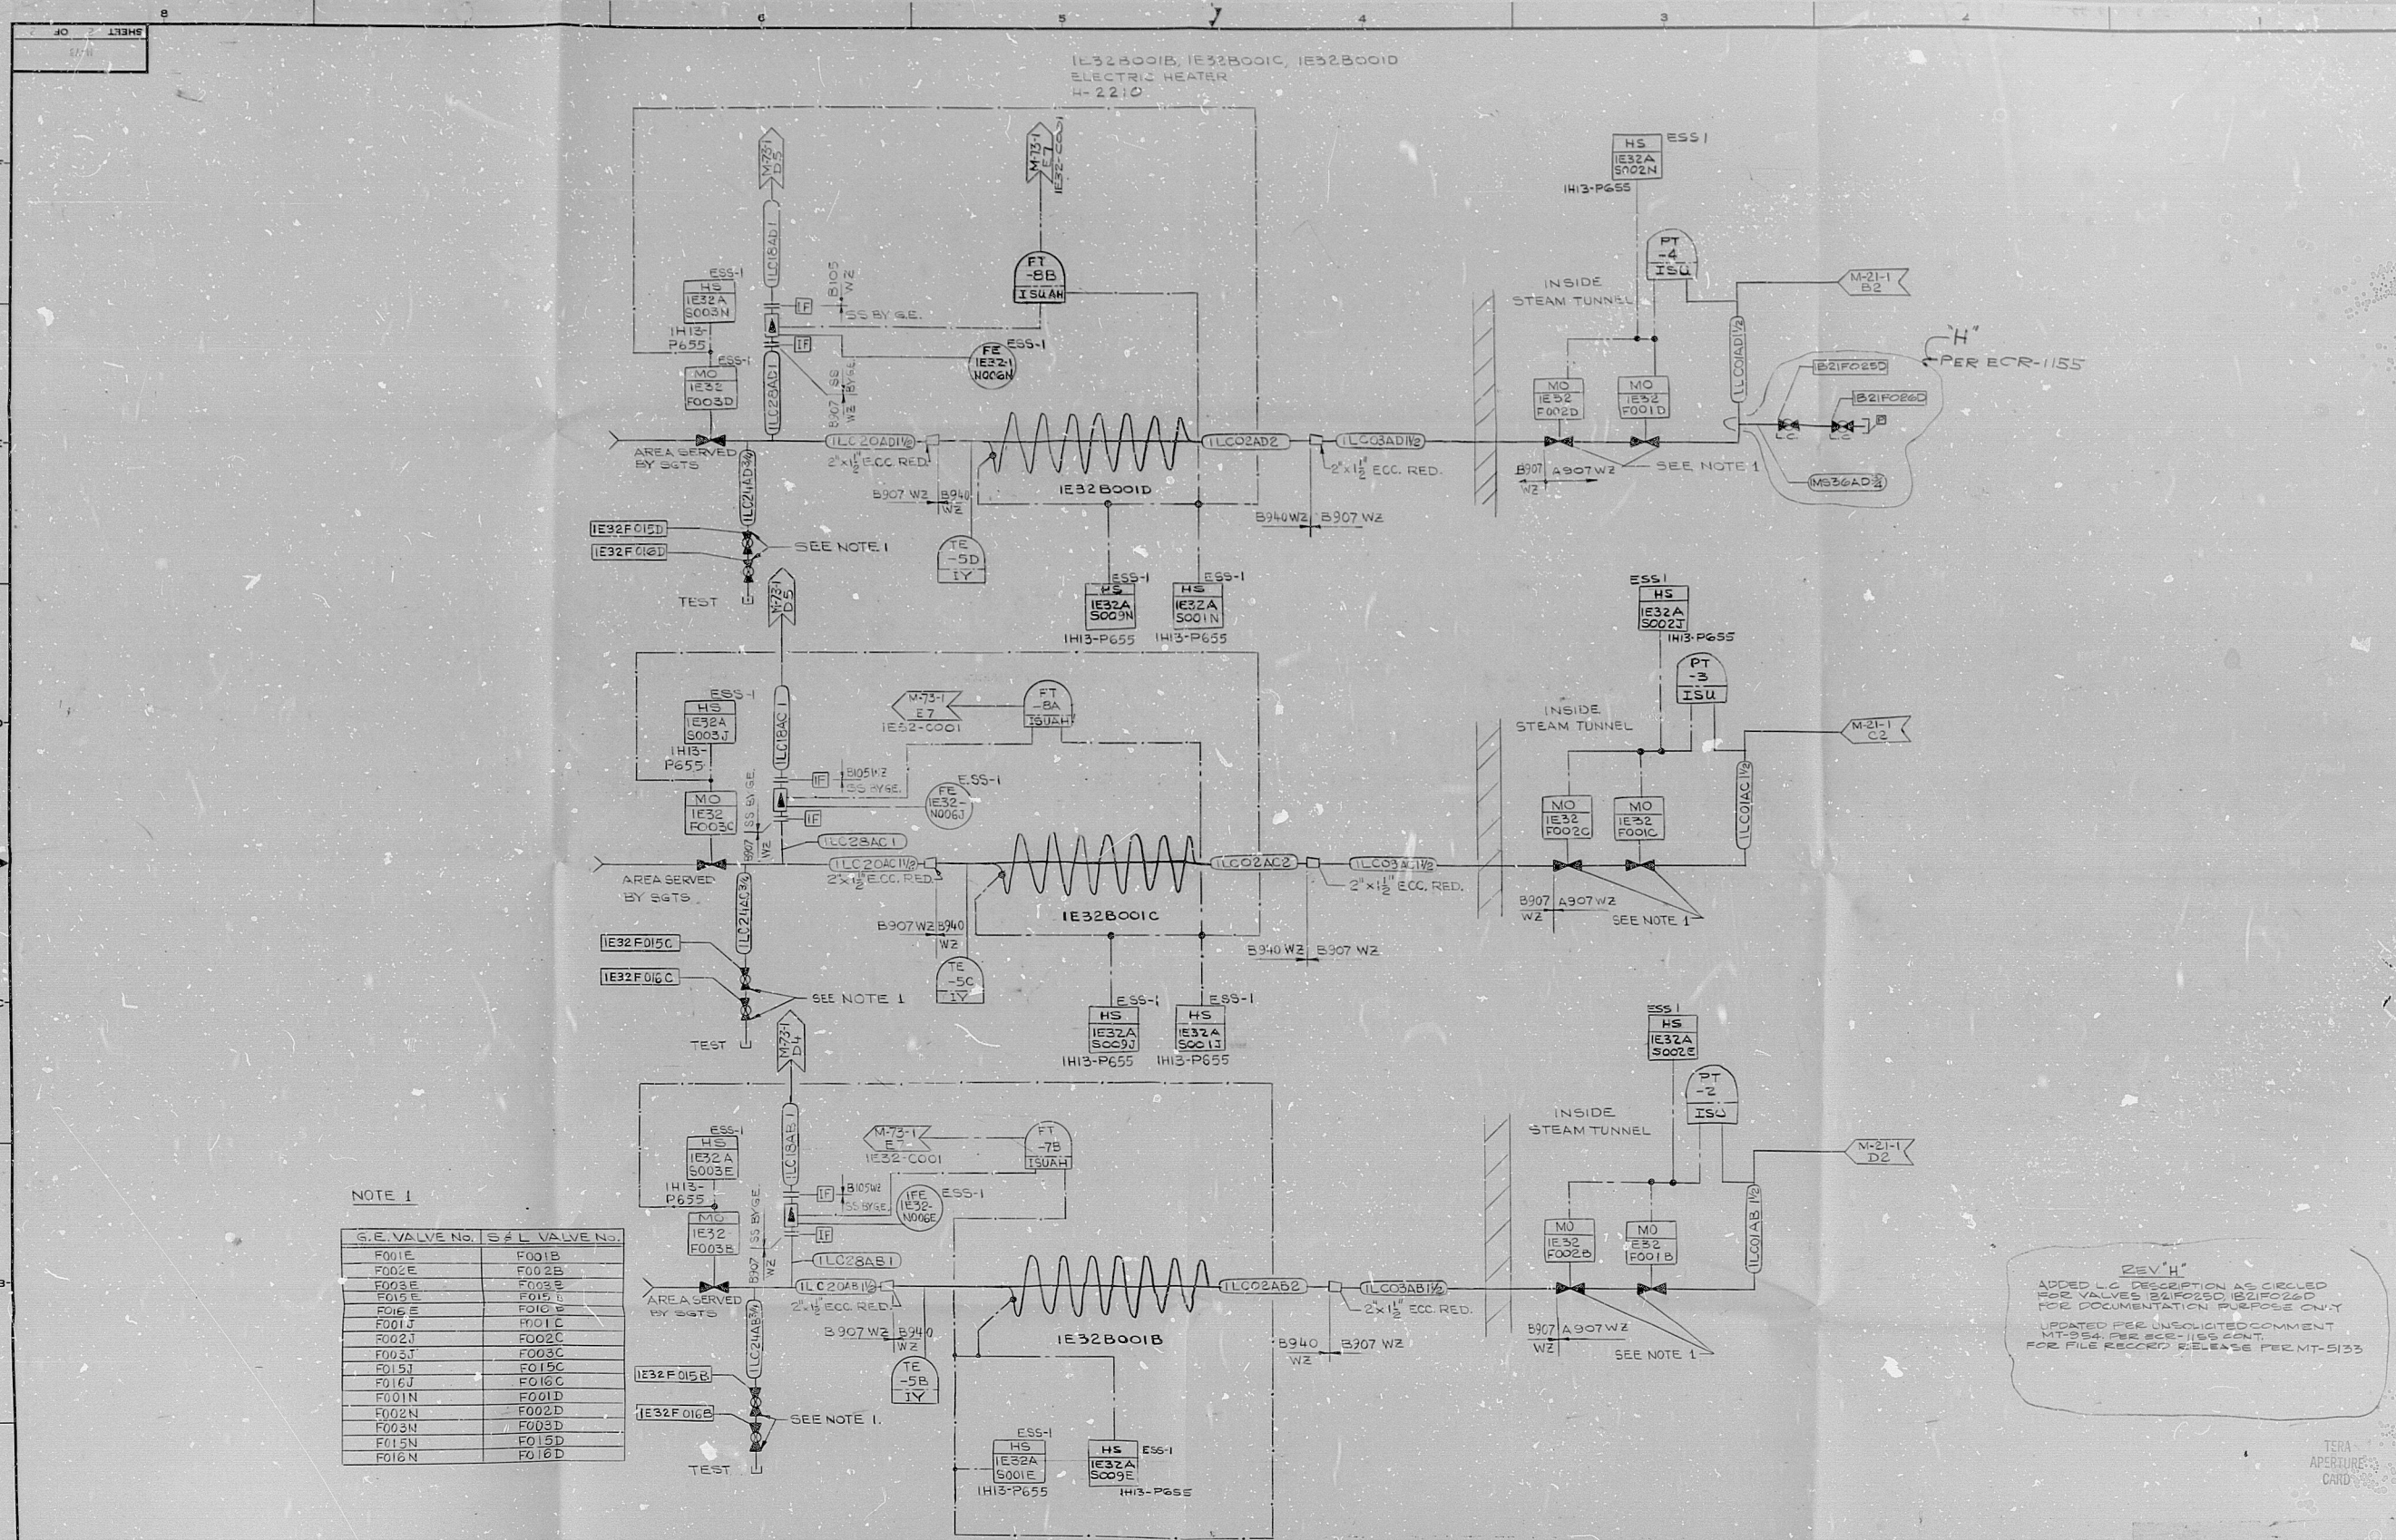

NOTE 1

S.E. VALVE NO.	S.L. VALVE NO.
F001E	F001B
F002E	F002B
F003E	F003B
F015E	F015B
F016E	F016B
F001F	F001C
F002F	F002C
F003F	F003C
F015F	F015C
F016F	F016C
F001N	F001D
F002N	F002D
F003N	F003D
F015N	F015D
F016N	F016D

REV. H
 ADDED LC DESCRIPTION AS CIRCLED FOR VALVES IE32F002B, IE32F002C, IE32F002D FOR DOCUMENTATION PURPOSE ONLY
 UPDATED PER UNCLASSIFIED COMMENT MT-354 PER SEC-1155 CONT. FOR FILE RECORD RELEASE PER MT-5133

DRAWING RELEASE RECORD										DRAWING RELEASE RECORD										PROJECT		INCLUDED	
REV.	SPEC. NO.	DATE	DRAWN	CHECKED	ENGR. APPROVAL	DESCRIPTION	FILM	REV.	SPEC. NO.	DATE	DRAWN	CHECKED	ENGR. APPROVAL	DESCRIPTION	FILM	DRAWN	SCALE	PROJECT NUMBER	
DO NOT USE I, O, OR X FOR REVISION	
8										7										6										5										4										3										2										1	
SHEET 8 OF 8																																																																																																																																																																																																																																																																																																																																																																																																																																																																																																																																																																																																																																																																																																																																																																																																																																																																																																																																																																																																																																																																																																																																																																																																																																																																																																																																																																																																																																																																																																																																																																																																																																																																																																																																																																																																																																																																																																																																																																																																																																																																																																																																																																																																																																																																																																																																																																																																																																																																																																																																																																																																																																																																																																																																																																																																																																																																																																																																																																																																																																																																																																																																																																																																																																																																																																																																																																																																																																																																																																																																																																																																																																																																																																																																																																																																																																																																																																																																																																																																																																																																																																																																																																																																																																																																																																																																																																																																																																														</									

ESSENTIAL COMPONENTS INCLUDED

NSIV LEAKAGE CONTROL SYSTEM (LC)
 THE CINCINNATI GAS & ELECTRIC COMPANY
 COLUMBUS & SOUTHERN OHIO ELECTRIC COMPANY
 THE DAYTON POWER AND LIGHT COMPANY

SARGENT & LUNDY
 ENGINEERS
 CHICAGO
 DRAWING NO. 1154
 SHEET 2 OF 2

RIDS-RDR

8104010418

