

22

17

11


8.5

11

17

22

34

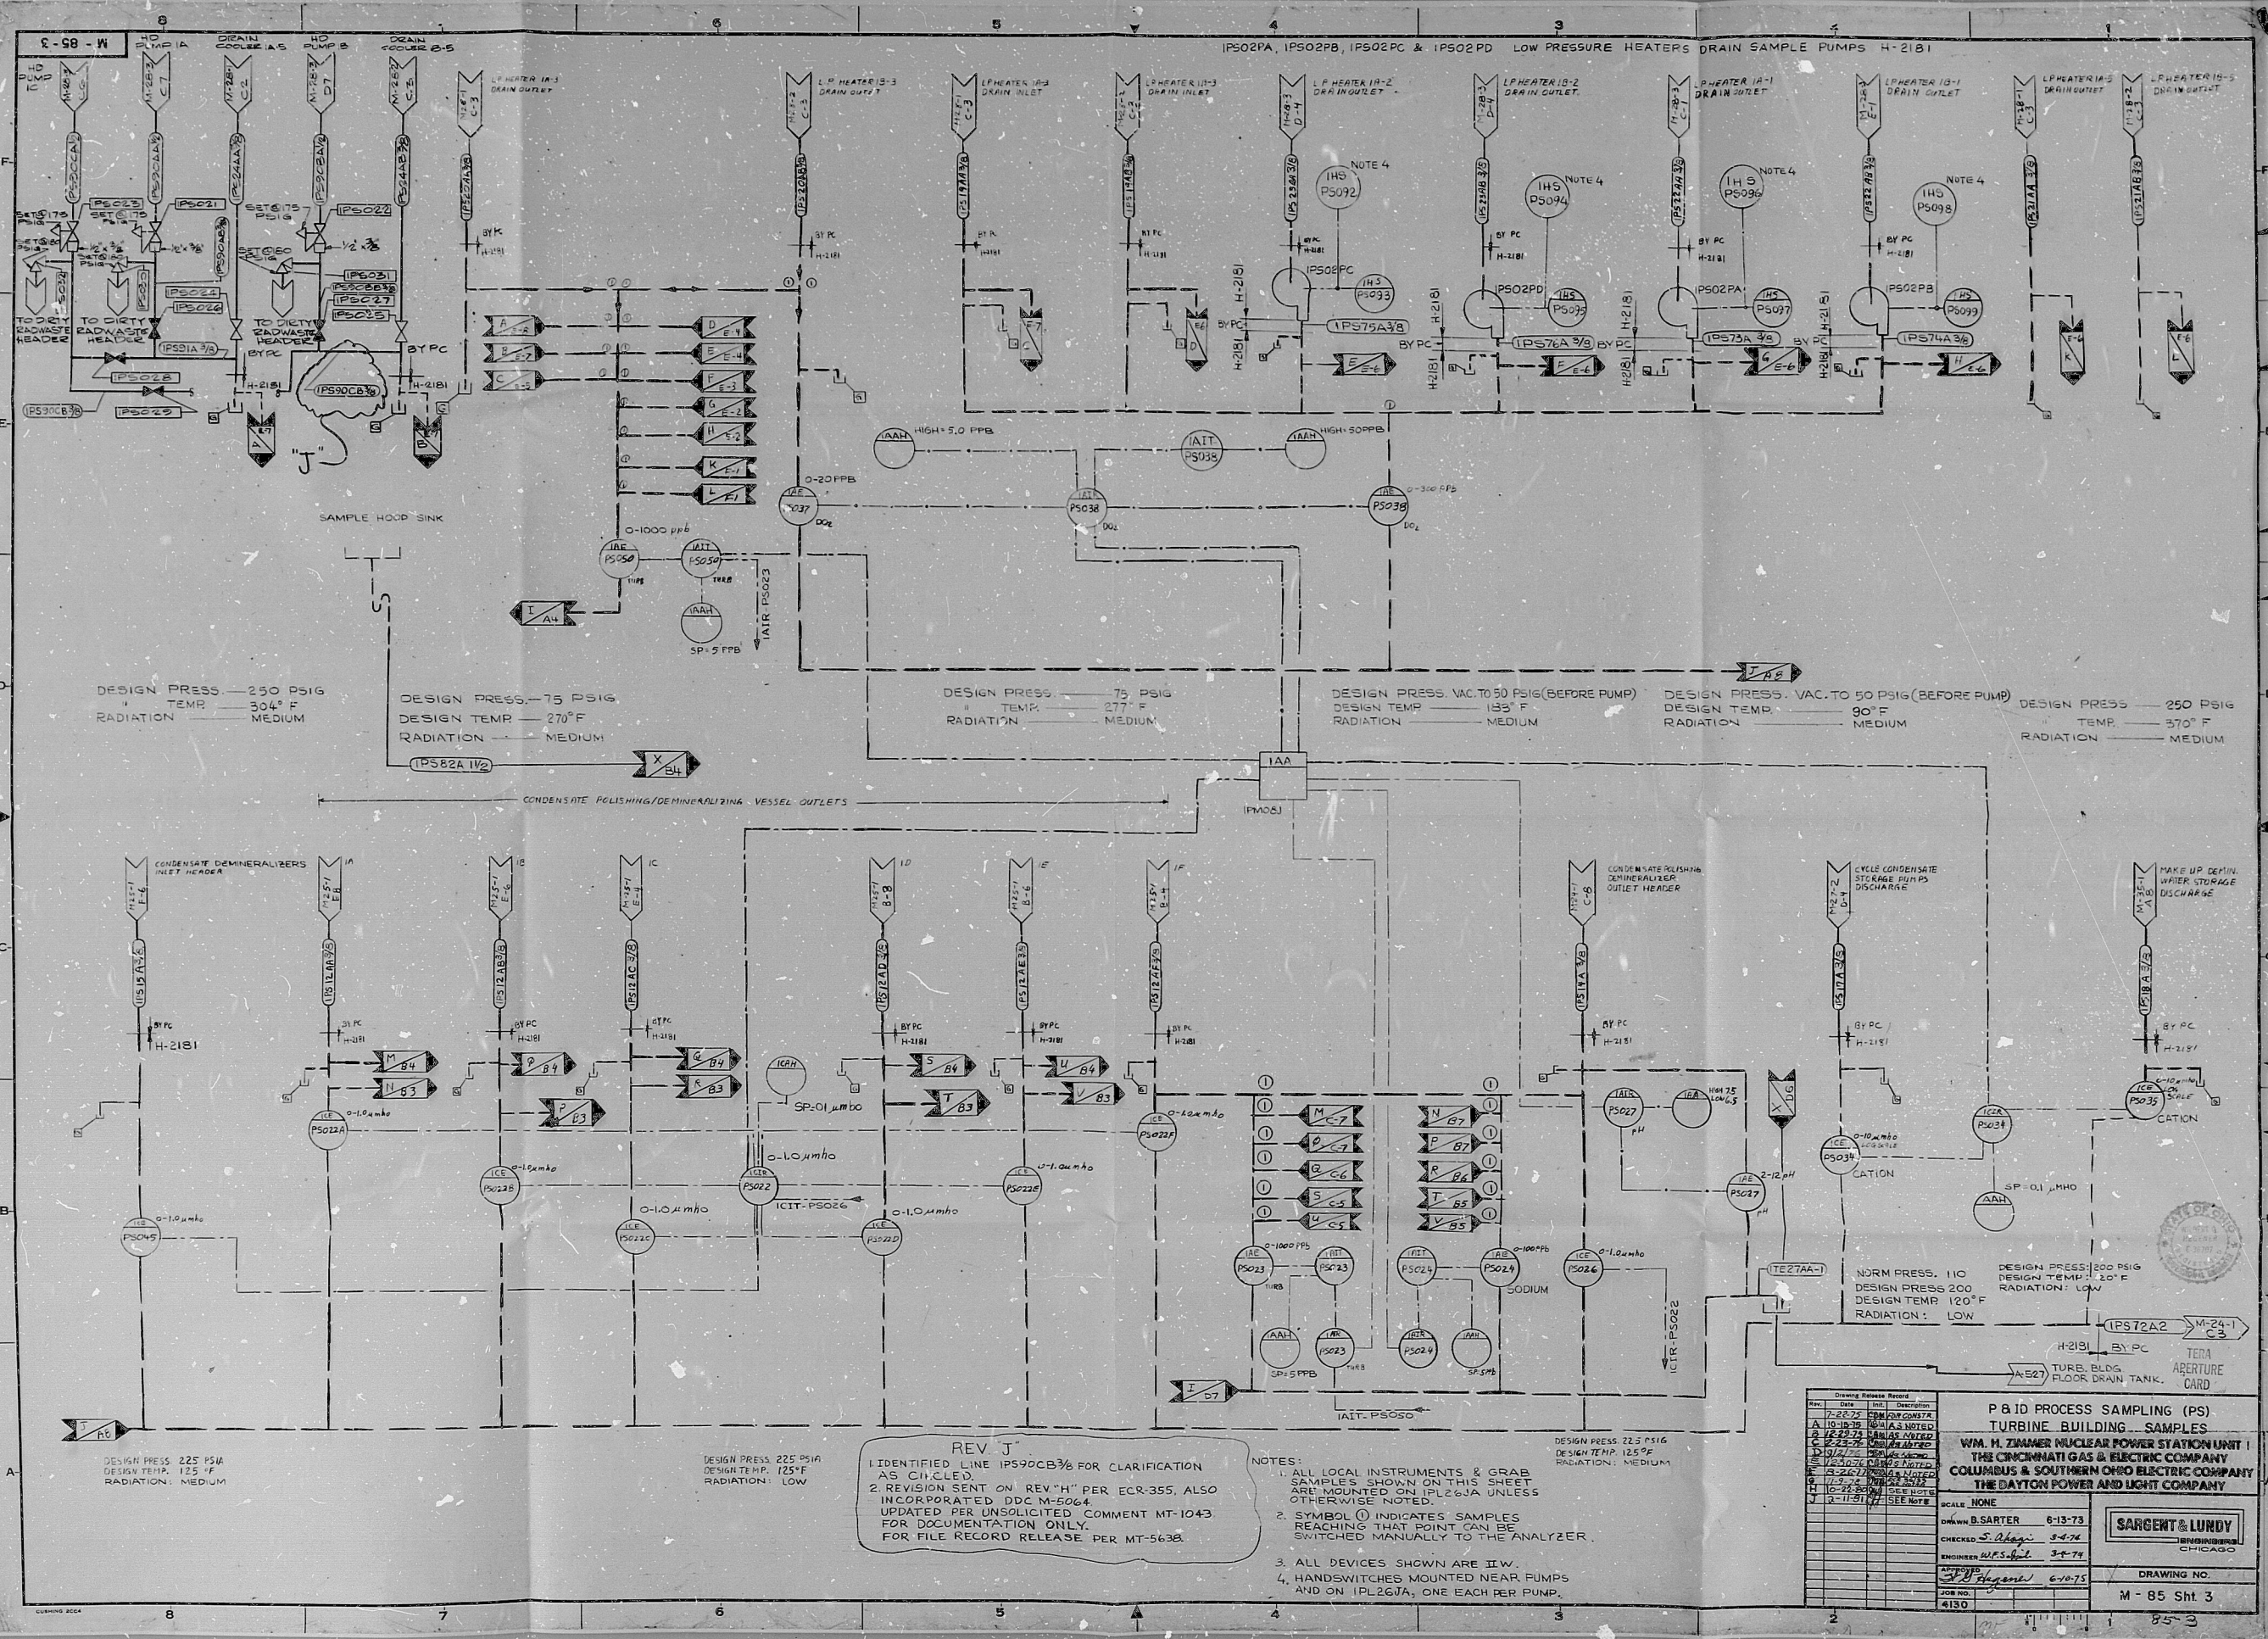

Drawing Revisions			
No.	Date	By	Description

P&ID PROCESS SAMPLING (PS)
TURBINE BUILDING - SAMPLES
WM. H. ZIMMER NUCLEAR POWER STATION UNIT 1
THE CINCINNATI GAS & ELECTRIC COMPANY
COLUMBUS & SOUTHERN OHIO ELECTRIC COMPANY
THE DAYTON POWER AND LIGHT COMPANY

SCALE: NONE
DRAWN: B. SARTER 6-13-73
CHECKED: S. B. B. 5-4-74
ENGINEER: W. H. ZIMMER 3-4-74
DATE: 6-13-73
JOB NO.: 4130
DRAWING NO.: M-85 Sht 3
85-3

RDS-PDR

8104010425

