


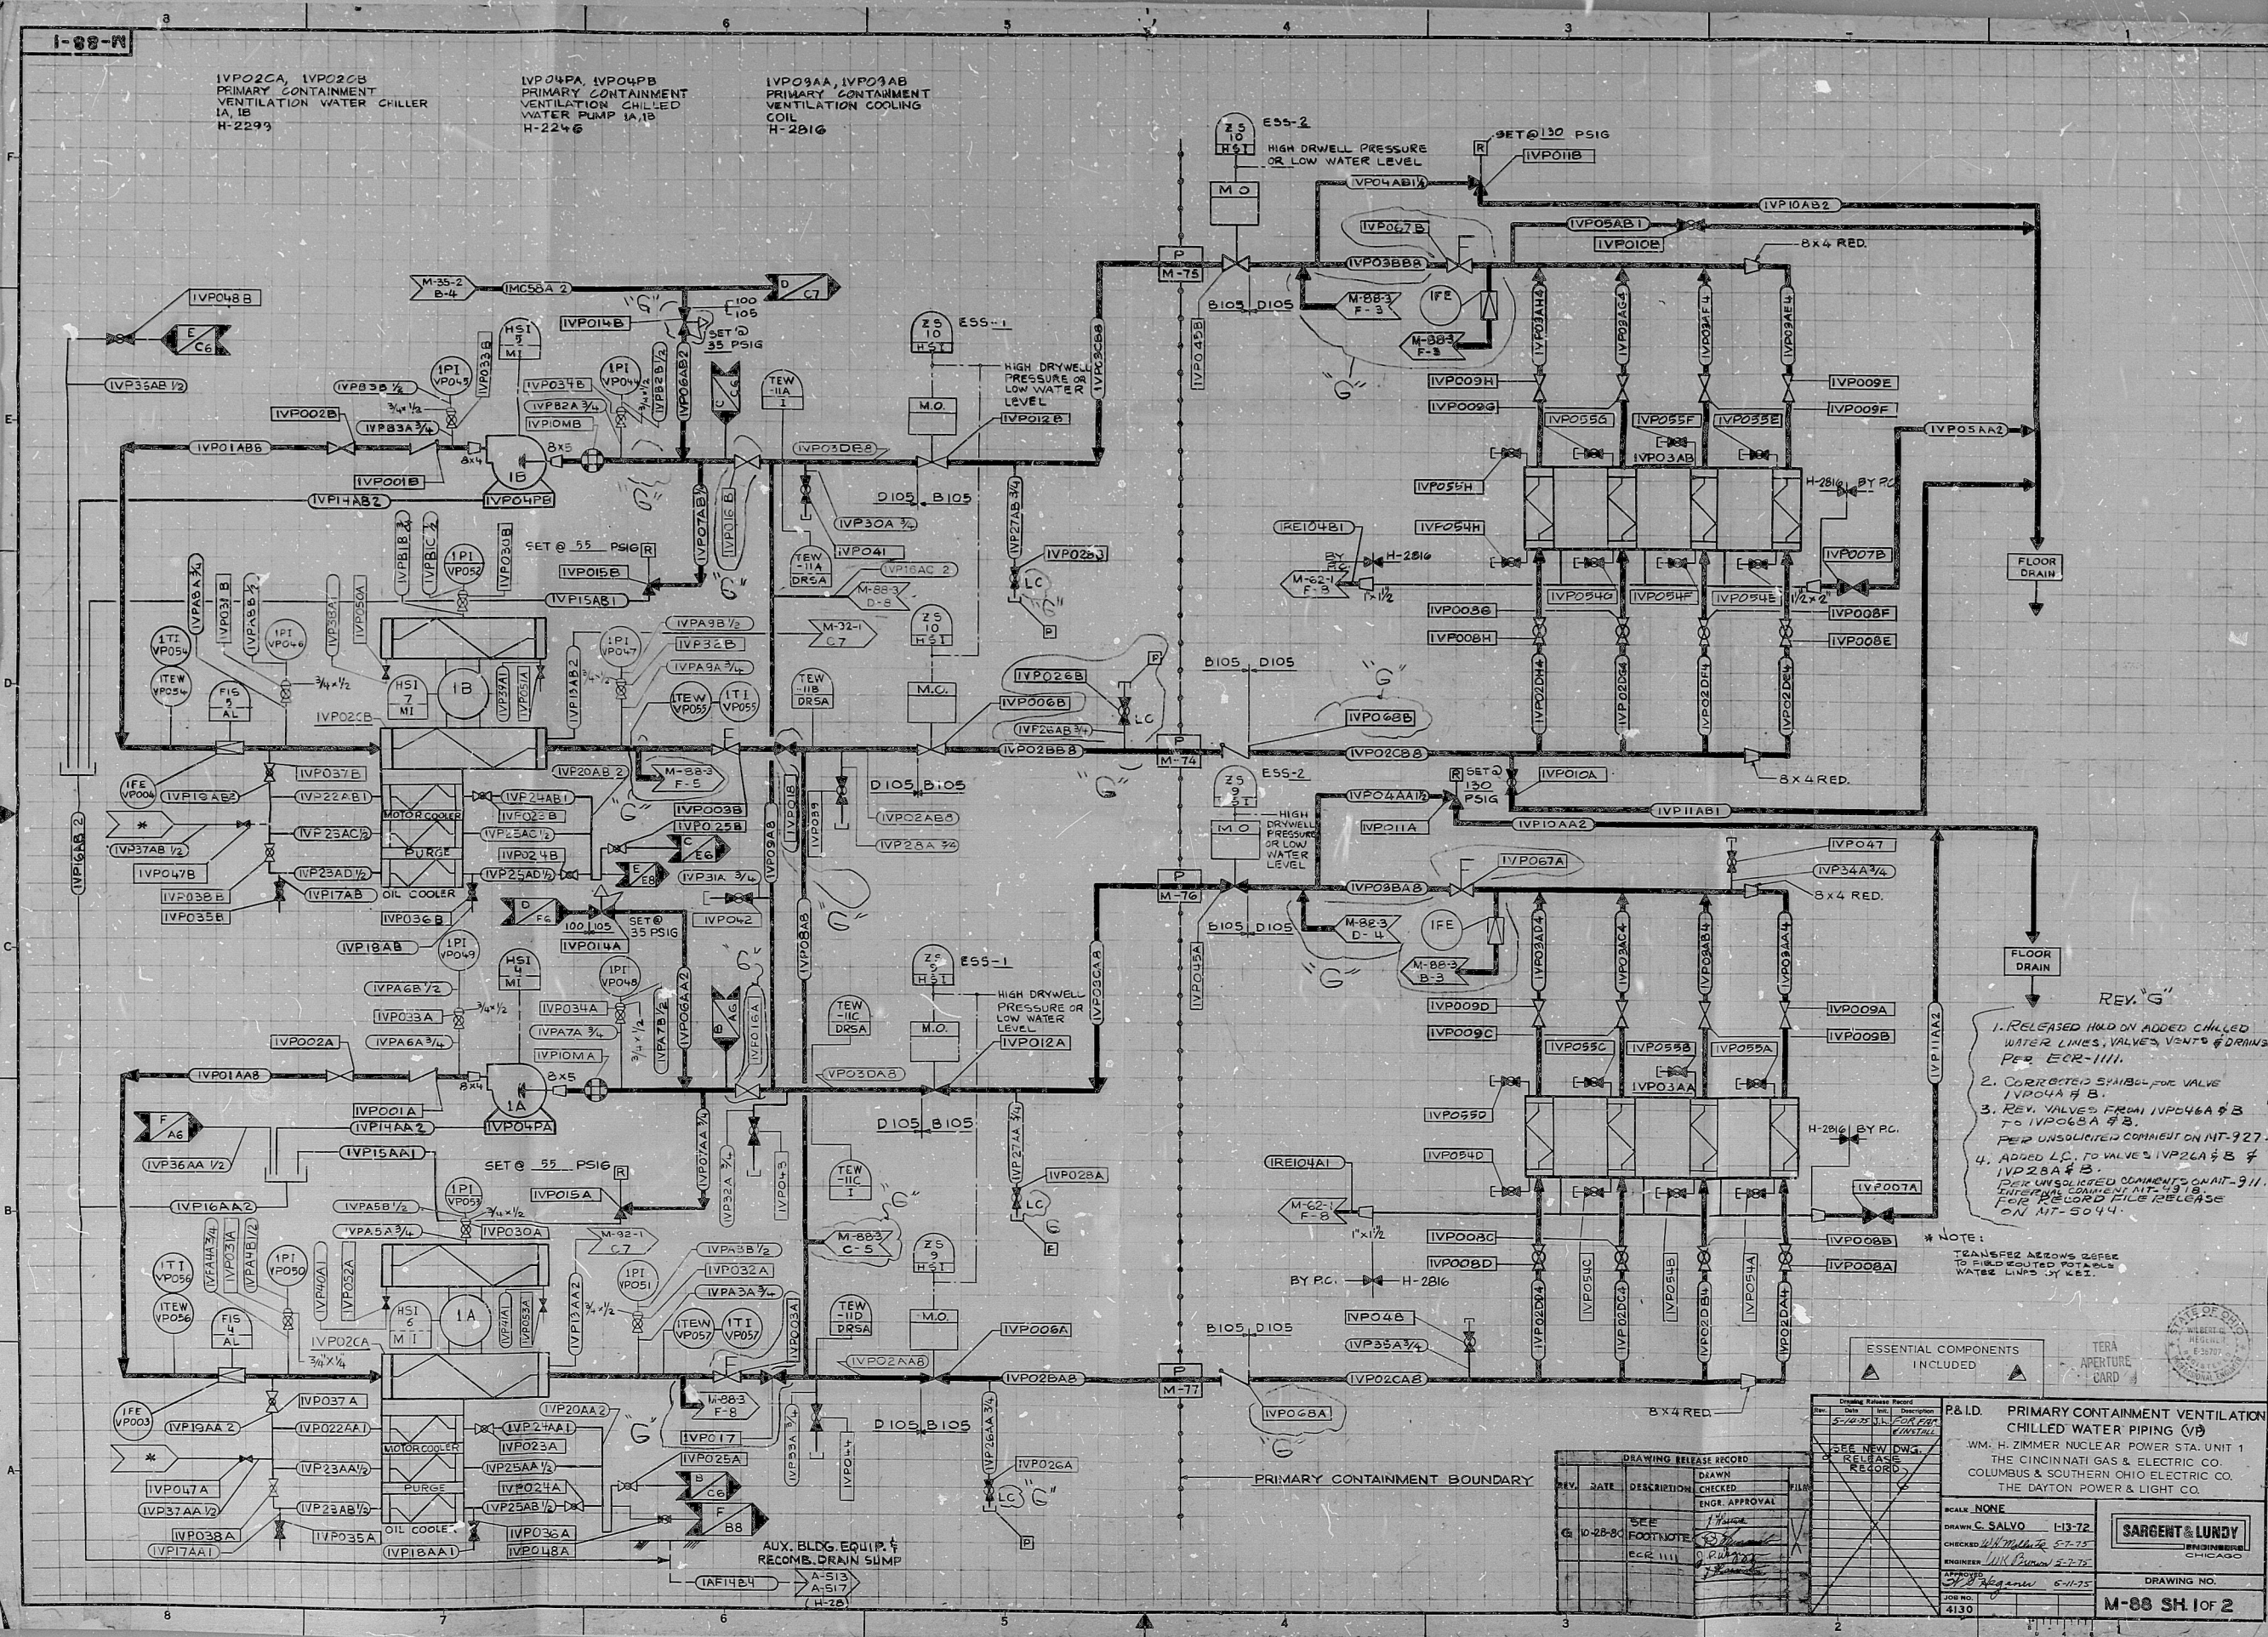



RDS-RIR

8104010433

