

146

22

21

11

9.8


8.5

11

17

22

34

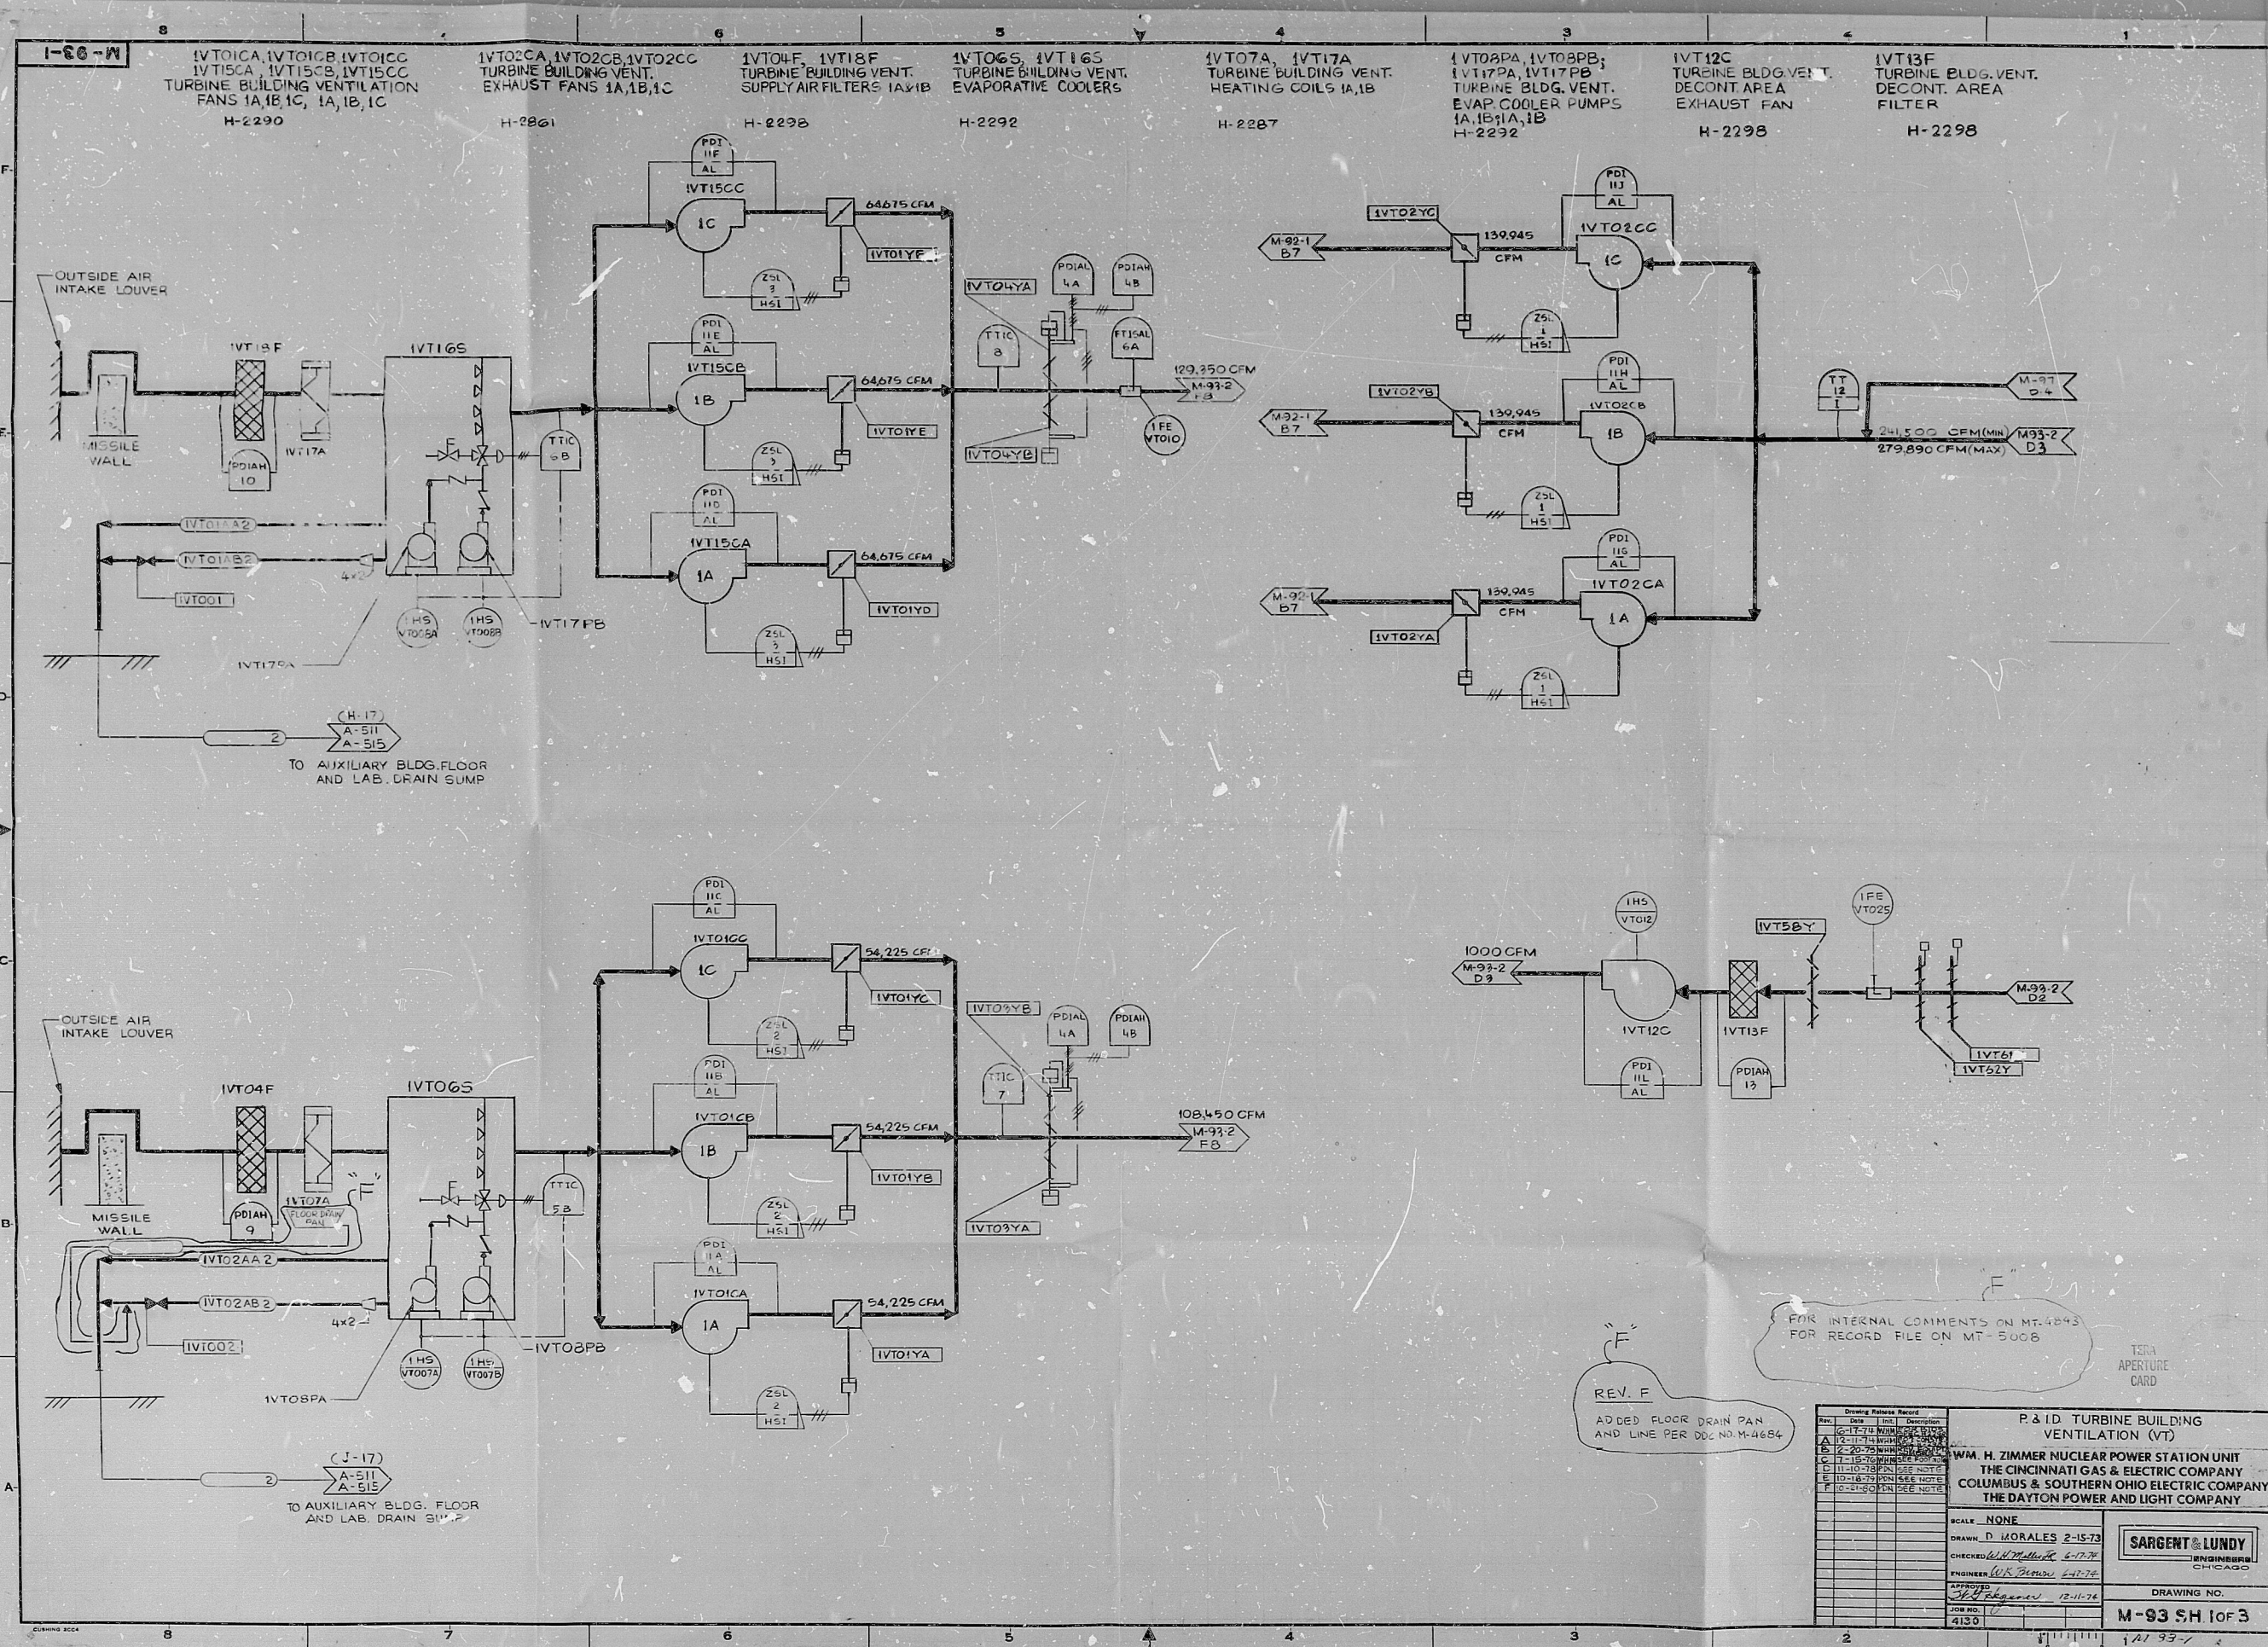

146

22

21

11

9.8

8.5

11

17

22

34



RDS-PDR

8104010442

