


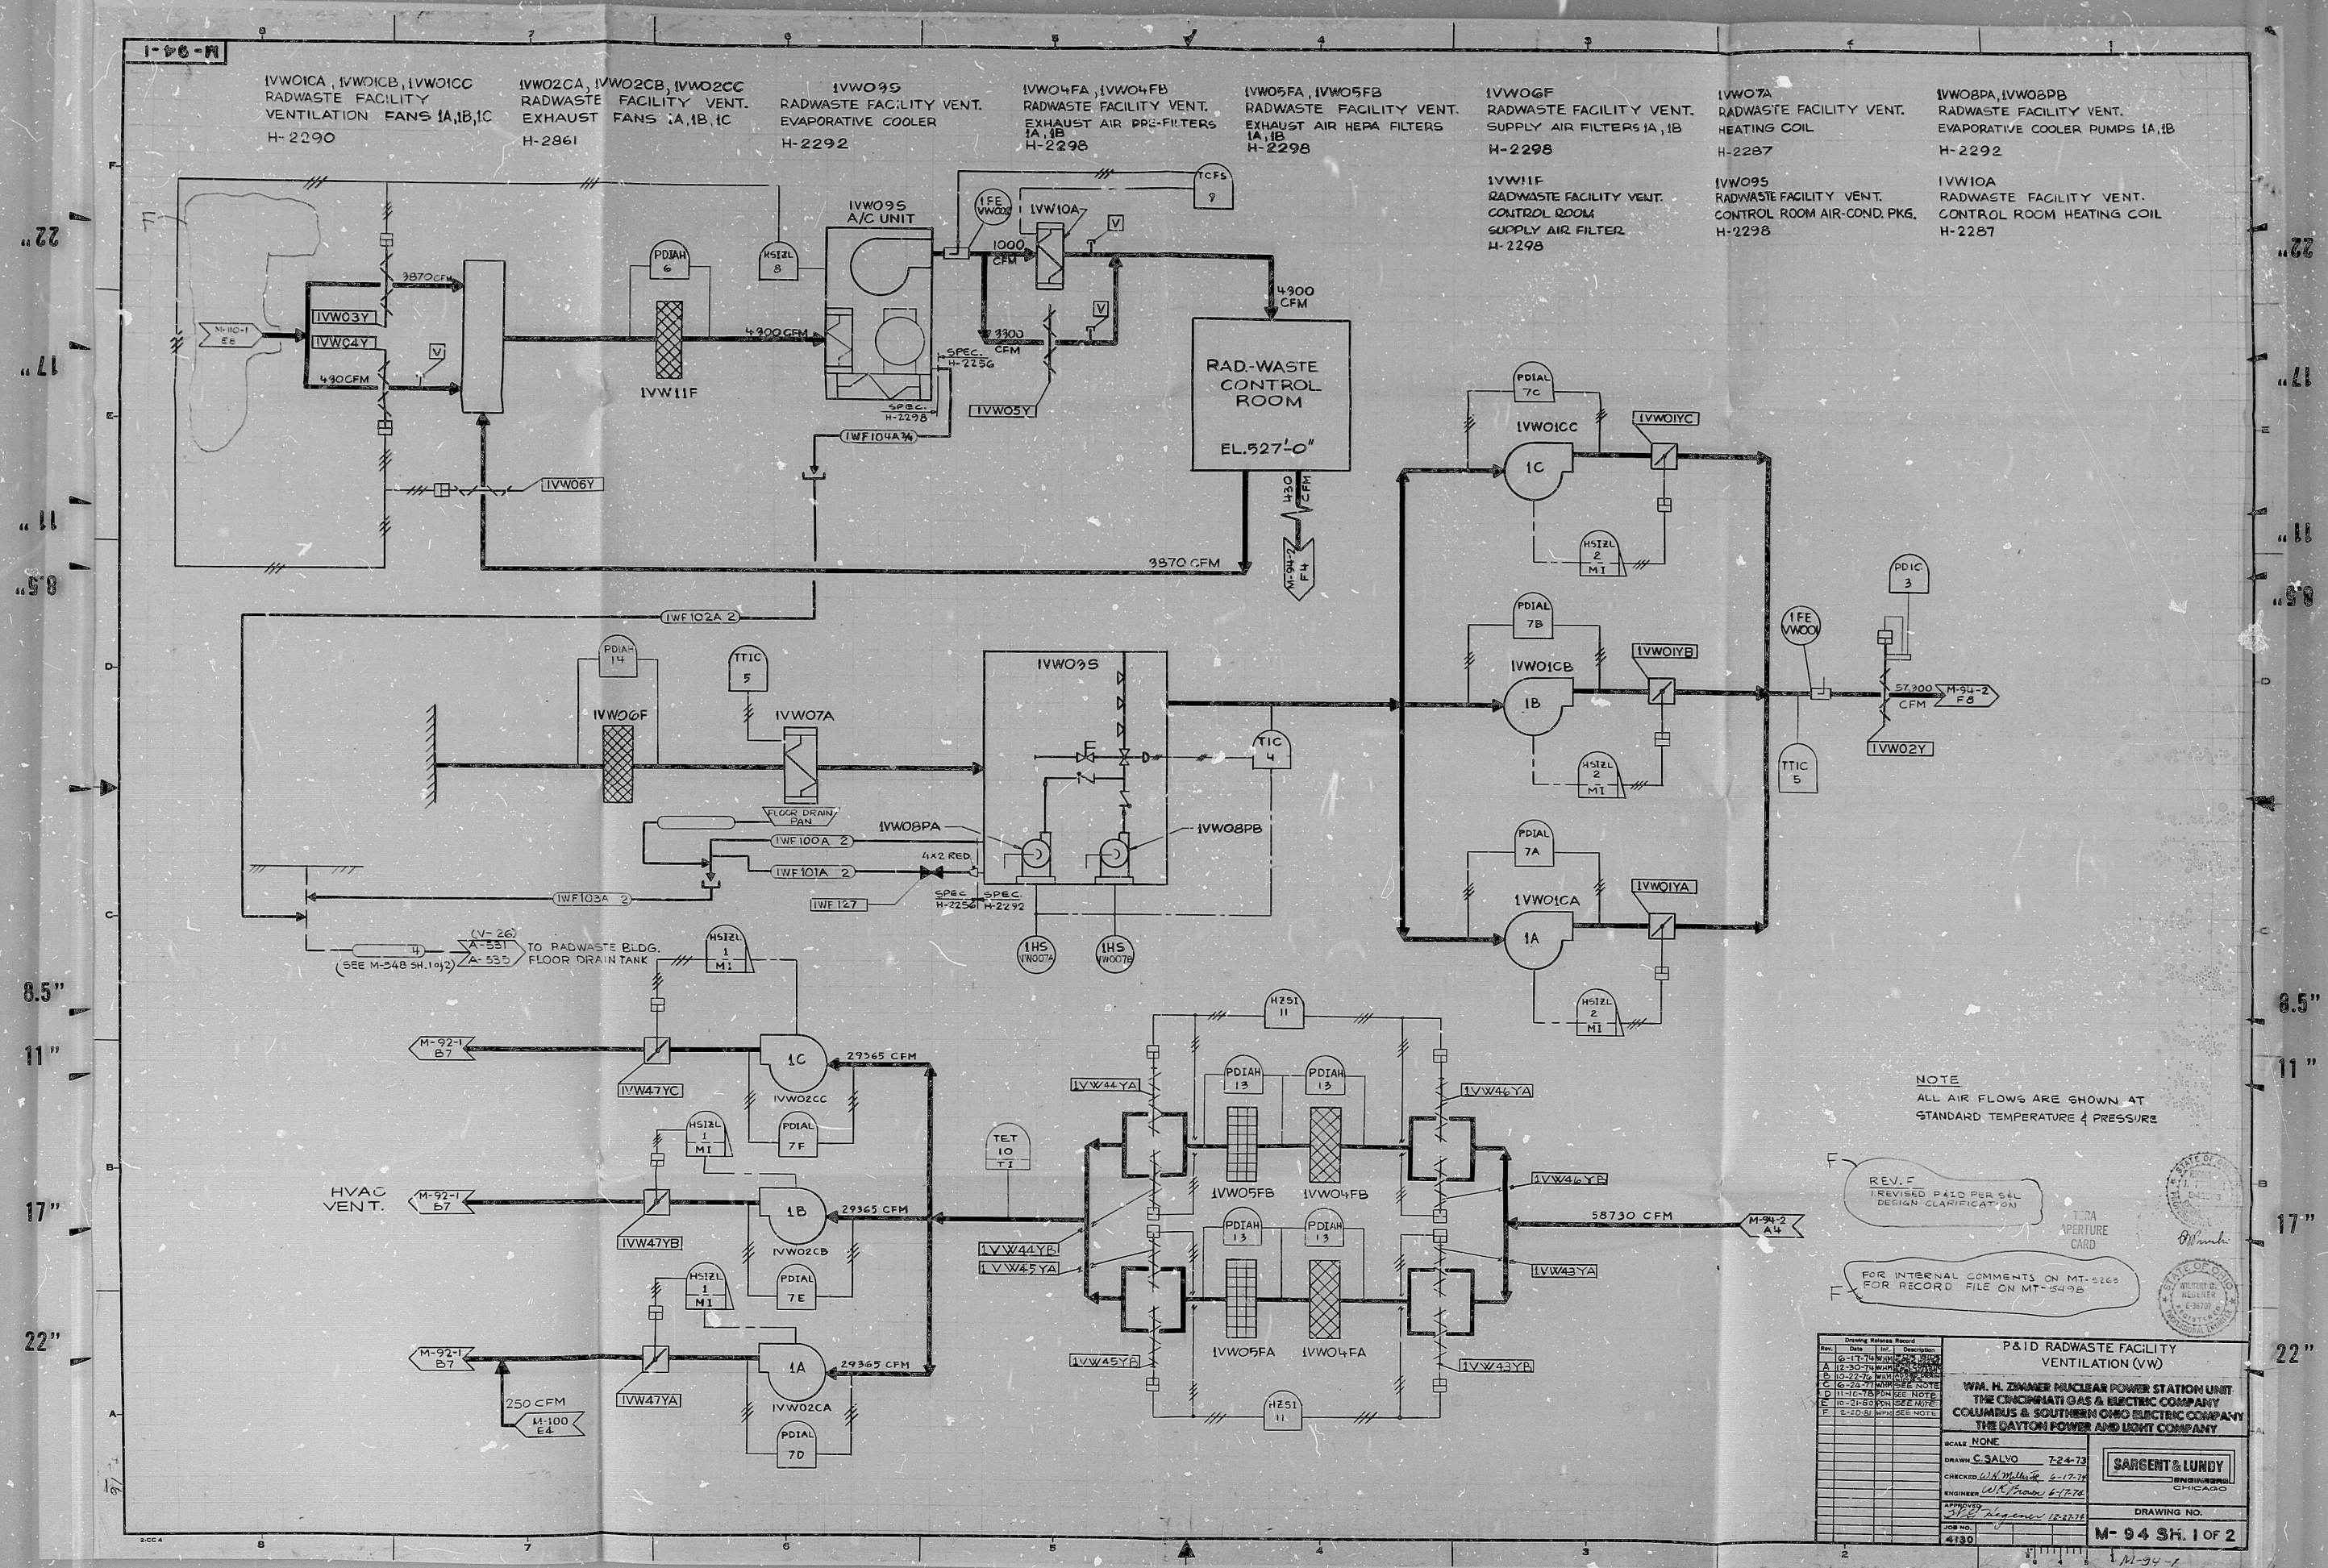

RDS-ROR

8104010449

