


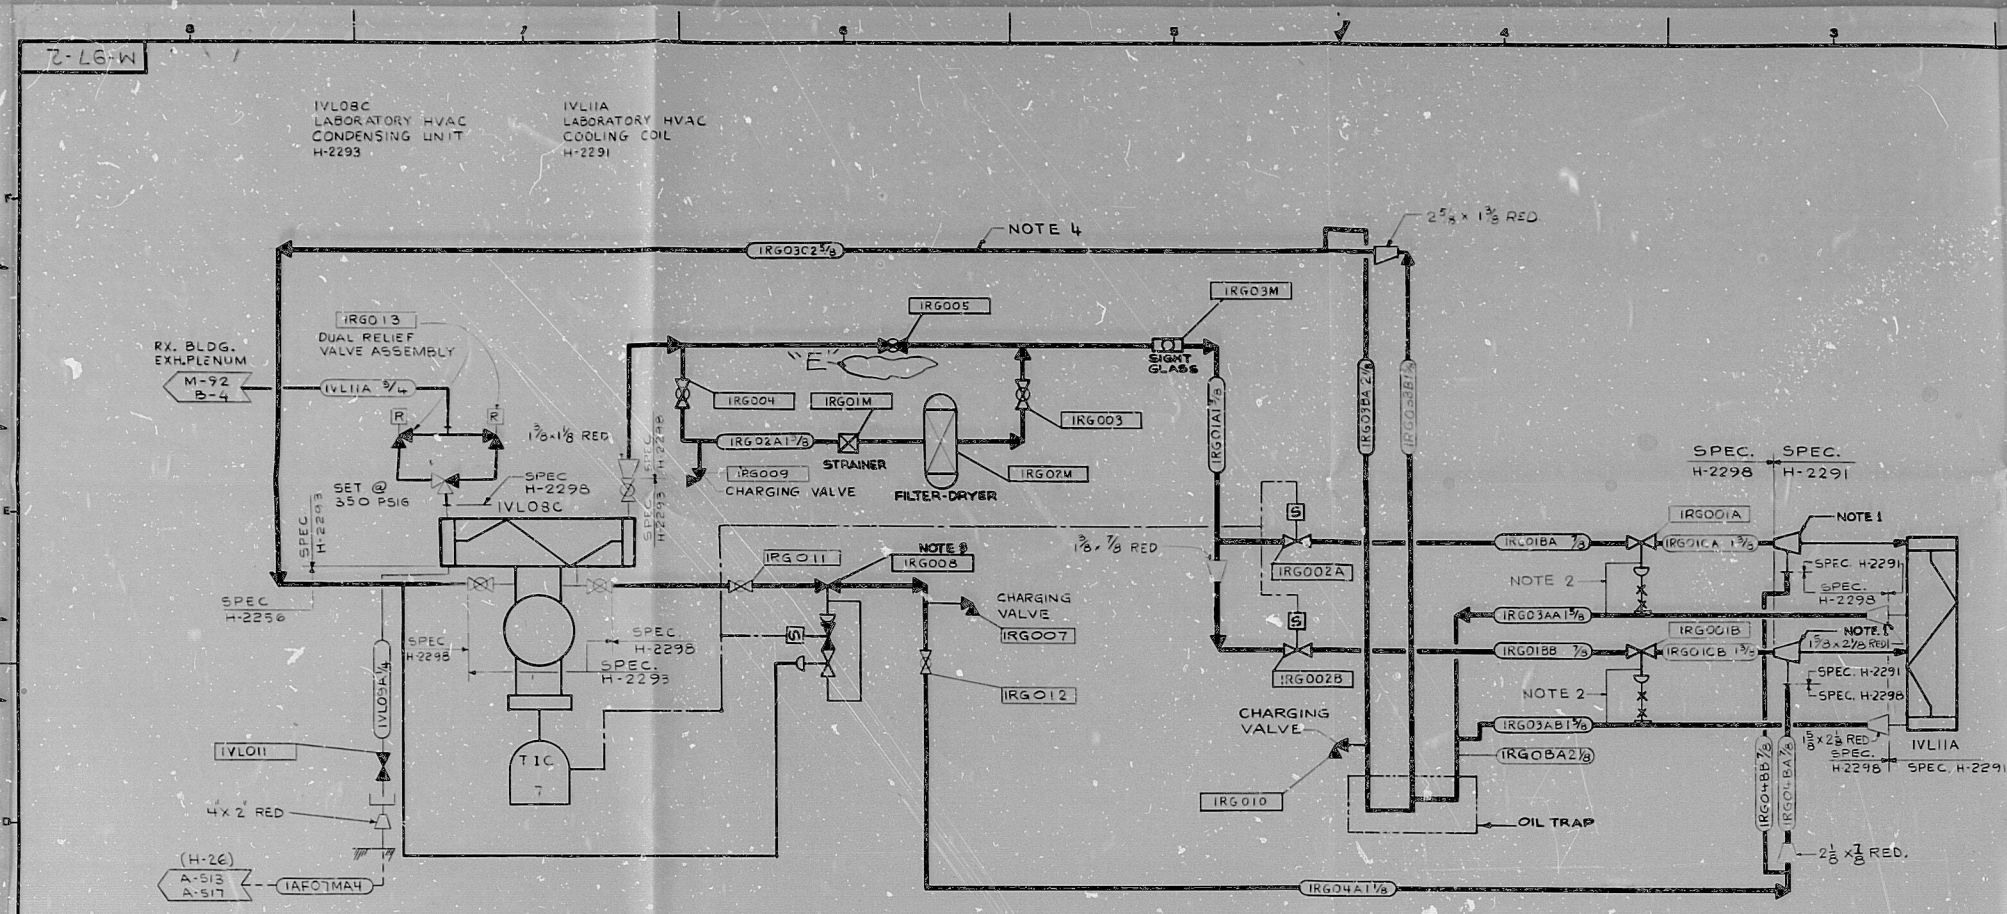

- NOTES
1. SIDE-INLET HOT GAS BY-PASS VENTURI TYPE DISTRIBUTOR.
 2. 1/4" EQUALIZER LINES.
 3. HOT GAS BY-PASS ASSEMBLY.
 4. ALL THE HORIZONTAL REFRIGERANT PIPING SHALL BE SLOPED DOWN 1/4" / 20' IN THE DIRECTION OF FLOW.

REV. "E"

1. REMOVED "LC" FROM VALVE IRG005.

PER MT. 511.

FOR INTERNAL COMMENTS ON MT-4918 FOR RECORD FILE ON MT-5044








PROJECT: P&ID LABORATORY HVAC REFRIGERATION SYSTEM (RG)

CLIENT: WM. H. ZIMMER NUCLEAR POWER STATION UNIT

OWNER: THE CINCINNATI GAS & ELECTRIC COMPANY

DESIGNER: COLUMBUS & SOUTHERN OHIO ELECTRIC COMPANY

CONTRACTOR: THE DAYTON POWER AND LIGHT COMPANY

DRAWING NO. M-97 SH. 2 OF 3


RDS-RDR

81040/0457

