


It covers are the property of BECHTEL. They are merely loaned and on the borrower's express agreement that they will not be reproduced, copied, loaned, exhibited, or used except in the private use permitted by any written consent given by the lender to the borrower.

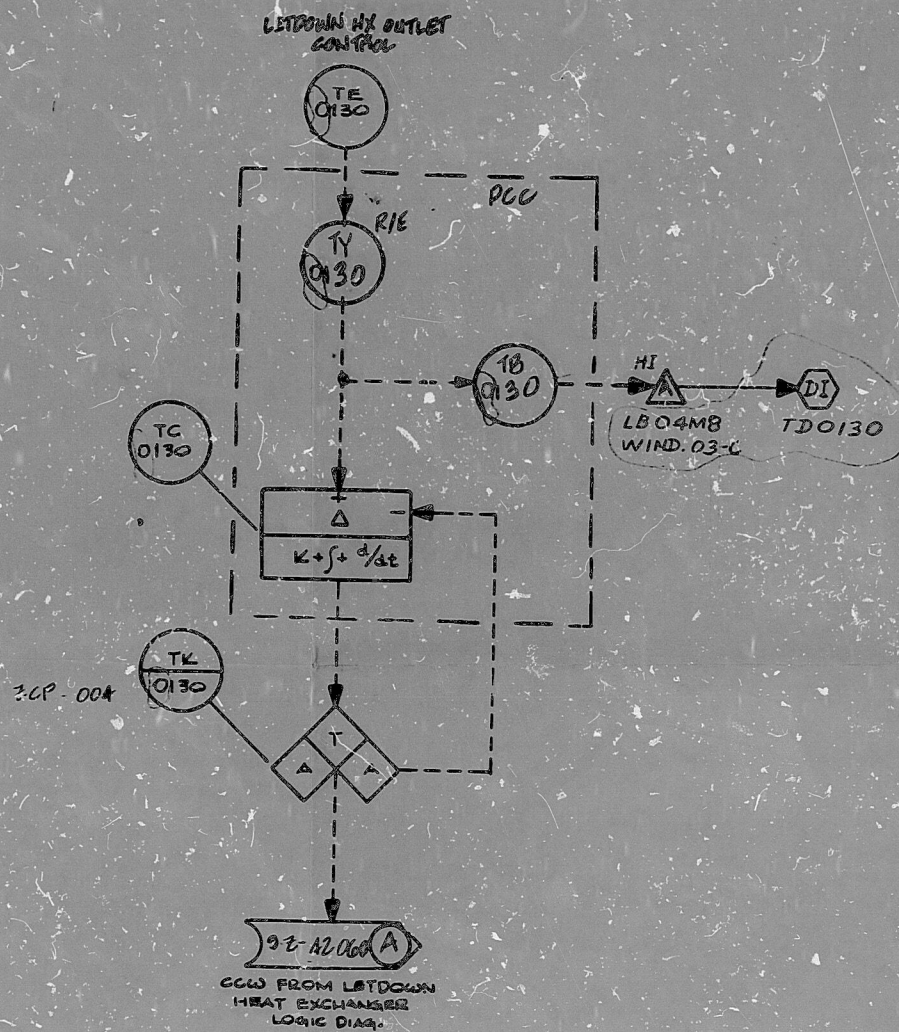

REFERENCE DWGS.

PG'1D: 9F05006

LOGIC SYMBOLS: 9-E-40418 AND 9-E-40421

99 FLOW DIAG: 1207E15 A.2

ELECT. REF. DWG. NO: 9-E-CV10-04

TI
APERTURE
CARD

HOUSTON OFFICE ISSUED
INFORMATION ONLY
STP 14926

GENERAL NOTE:

THIS DWG. REPRESENTS FUNCTIONAL REQUIREMENTS ONLY.

THIS DWG SUPERSEDES B&P DWG: GR-17-1-Z-3664 SA.10 REV. D												LETDOWN HX OUTLET CONTROL LOGIC DIAGRAM SYSTEM: CV			
BENTEL ENERGY CORPORATION HOUSTON, TEXAS												SCALE: JDD 60. NONE 14526			
HOUSTON LIGHTING & POWER CO. SOUTH TEXAS PROJECT												DRAWING NO. GR-17-9-Z-42445			
CHIEF ENGR. A.P. CAINE MIA 1/3												NO REVISION			
1 ADDED EMT. REF. DWG. AND US 4000 (1/10/83) 1/13/83												NO REVISION			
2 CORR. IDS & MISCL.												NO REVISION			
3 ISSUED FOR CONSTRUCTION												NO REVISION			
DFT CKR GL EGS PEM DATE												DFT CKR GL EGS PEM DATE			

PDR RIDS

8506060138

