


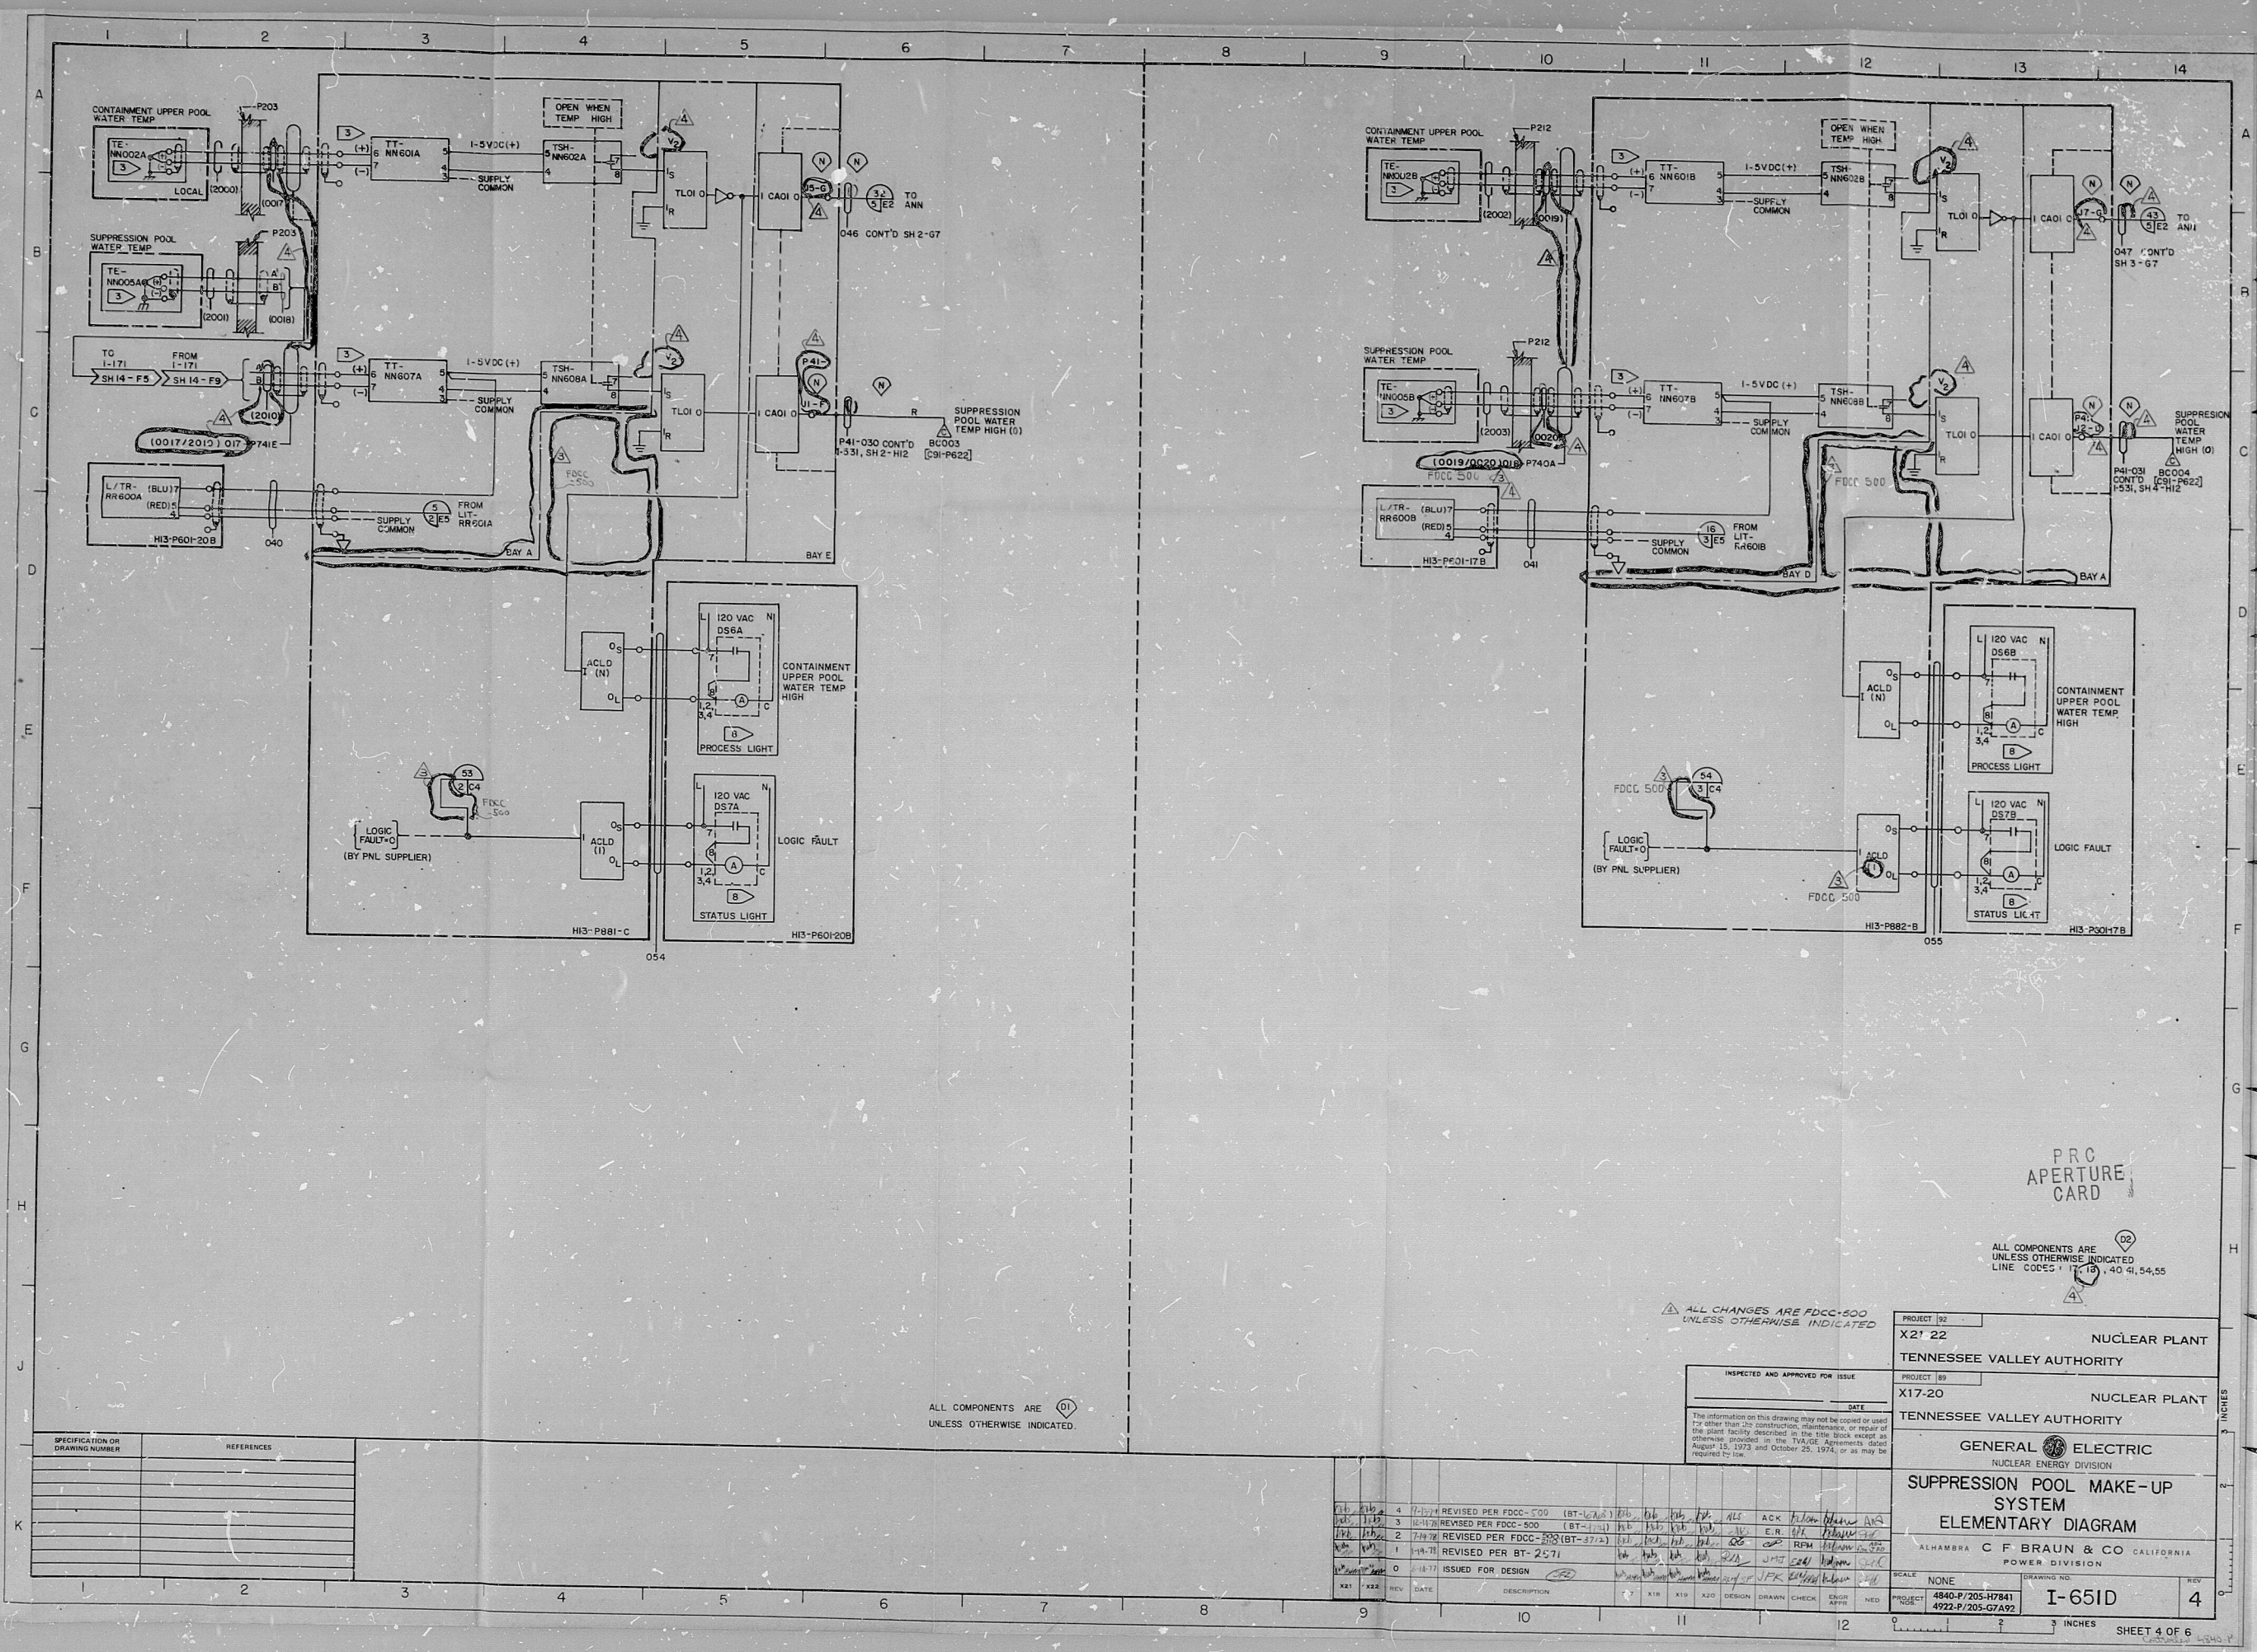

SPECIFICATION OR DRAWING NUMBER	REFERENCES

ALL CHANGES ARE FDCC-500
UNLESS OTHERWISE INDICATED

ALL COMPONENTS ARE
UNLESS OTHERWISE INDICATED.

PRC
APERTURE
CARD

ALL COMPONENTS ARE
UNLESS OTHERWISE INDICATED
LINE CODES: 1, 13, 40, 41, 54, 55

PROJECT 22	NUCLEAR PLANT
X21-22	TENNESSEE VALLEY AUTHORITY
PROJECT 89	NUCLEAR PLANT
X17-20	TENNESSEE VALLEY AUTHORITY
GENERAL ELECTRIC NUCLEAR ENERGY DIVISION	
SUPPRESSION POOL MAKE-UP SYSTEM ELEMENTARY DIAGRAM	
ALHAMBRA C F BRAUN & CO CALIFORNIA POWER DIVISION	
SCALE NONE	DRAWING NO. I-651D
PROJECT 4840-P-205-H7841	REV 4
4922-P-205-G7A92	

REV	DATE	DESCRIPTION	DESIGN	CHECK	ENGR	APPR	NEED

RIDS

8206290339

