
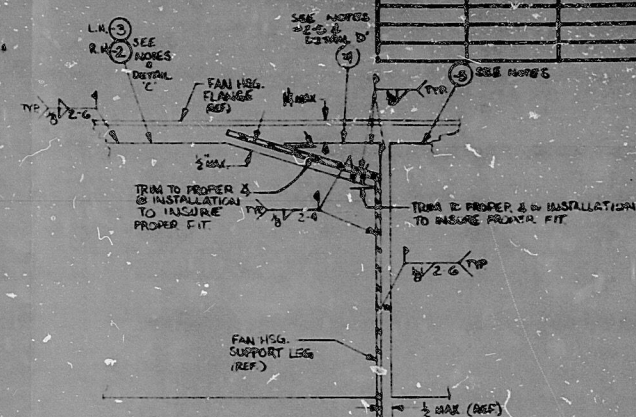
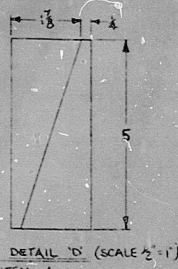
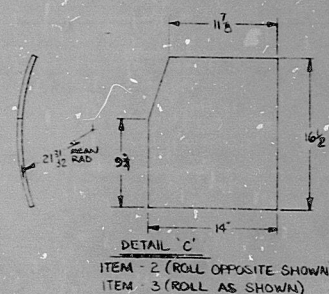


"WORK SAFELY TODAY"

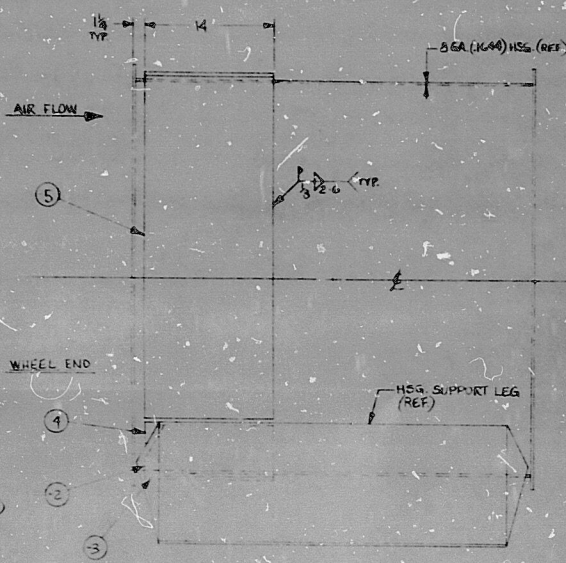

VIEW A-A (SCALE - $\frac{1}{4}" = 1"$)
TYPICAL FOR RH & LH SIDE

- RESERVED FOR
SARGENT & Lundy
EPCOM-2229
1. ☒ NO EXISTING TRAIL CONTRACTOR
MAY PROCEED WITH FABRICATION OR
CONSTRUCTION IN ACCORDANCE
WITH SPECIFICATION.
2. ☐ CONTRACTOR MAY PROCEED IN
ACCORDANCE WITH SPECIFICATION
BASED ON NACM REVISIONS
AND REVISIONS.
3. ☐ REUSE AS NOTED AND RECONSTRUCT
WELD FABRICATION.
- ANY ACTION SHOWN ABOVE IS
SUBJECT TO THE TERMS OF THE
CONTRACT AND DOES NOT RELIEVE
CONTRACTOR FROM HIS OBLIGATIONS
UNDER THE CONTRACT
INCLUDING DESIGN AND DETAILING
FOR FWH AND EQUIPMENT.
- EQUIPMENT NO. 506-2076 / 2076
BY: R. RUTINA DATE: 5/14/84
REF: RD 4394 PWA: WLD 4536

ORG. & F.O. ORDER NO.	FAN MARKS	ASS.
77K-26031	0VA04CA- AUX. BLDG. VENT SUPPLY FAN	-1
77K-26032	0VA04CB- AUX. BLDG. VENT SUPPLY FAN	-1
77K-26043	0VW03CB- RADWASTE BLDG. VENT SUPPLY FAN	-1
77K-26044	0VW03B- A- RADWASTE BLDG. VENT SUPPLY FAN	-1
77K-26050	1VW03CA- TURBINE BLDG. VENT SUPPLY FAN	-1
77K-26051	1VW03CB- TURBINE BLDG. VENT SUPPLY FAN	-1
77K-26054	1VW03CB- CONTAINMENT BLDG. VENT SUPPLY FAN	-1
77K-26055	1VW03CA- CONTAINMENT BLDG. VENT SUPPLY FAN	-1

PRC
APERTURE
CARD

[illegible]

THIS DRAWING IS THE PROPERTY
OF THE BUFFALO FORGE COMPANY

REFERENCE DIA#	MARKS
	SEE TAB
REFERENCE ORDER	ORIGINAL E
	SEE T

BUFFALO FORGE CO
BUFFALO, N.Y. 14202 U.S.A.

DI-5439

8207020094

17"

RIDS

8207020094

