




RIDS

8309010373

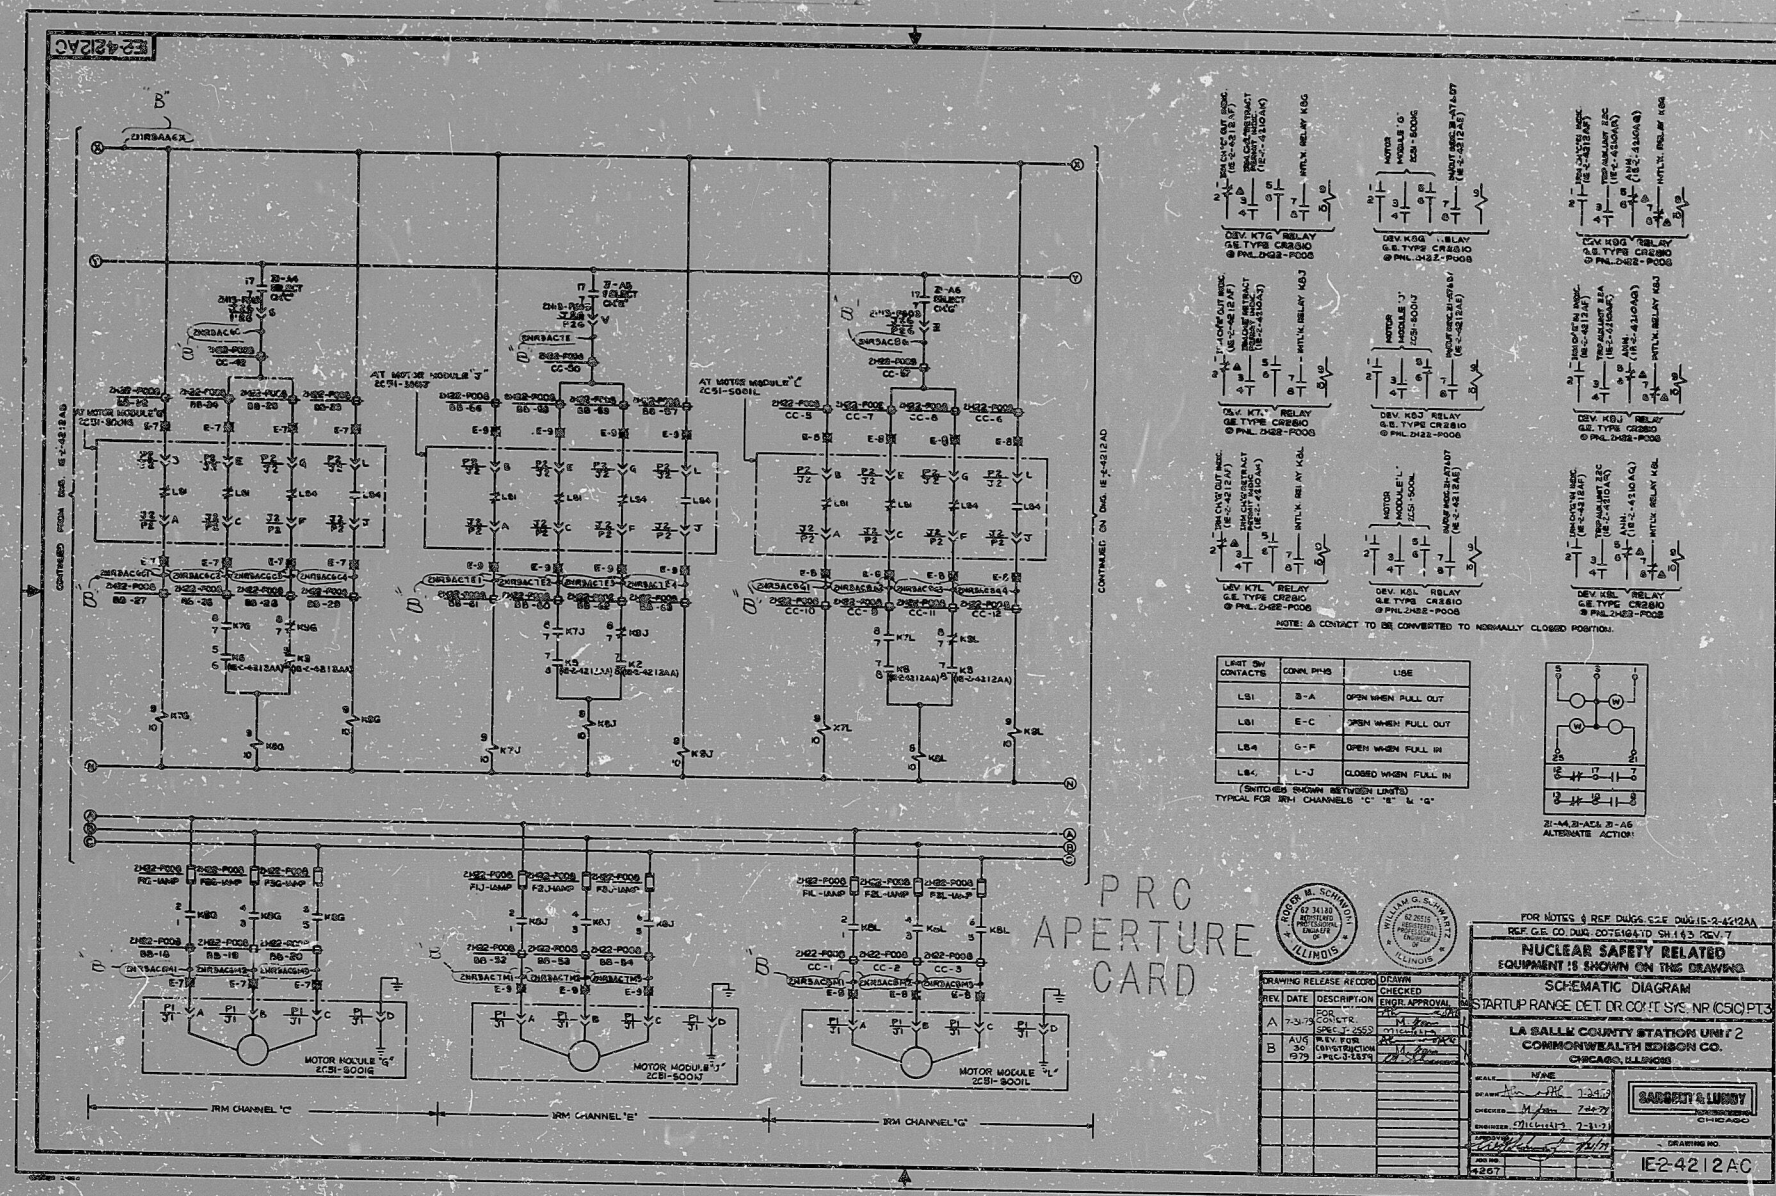