


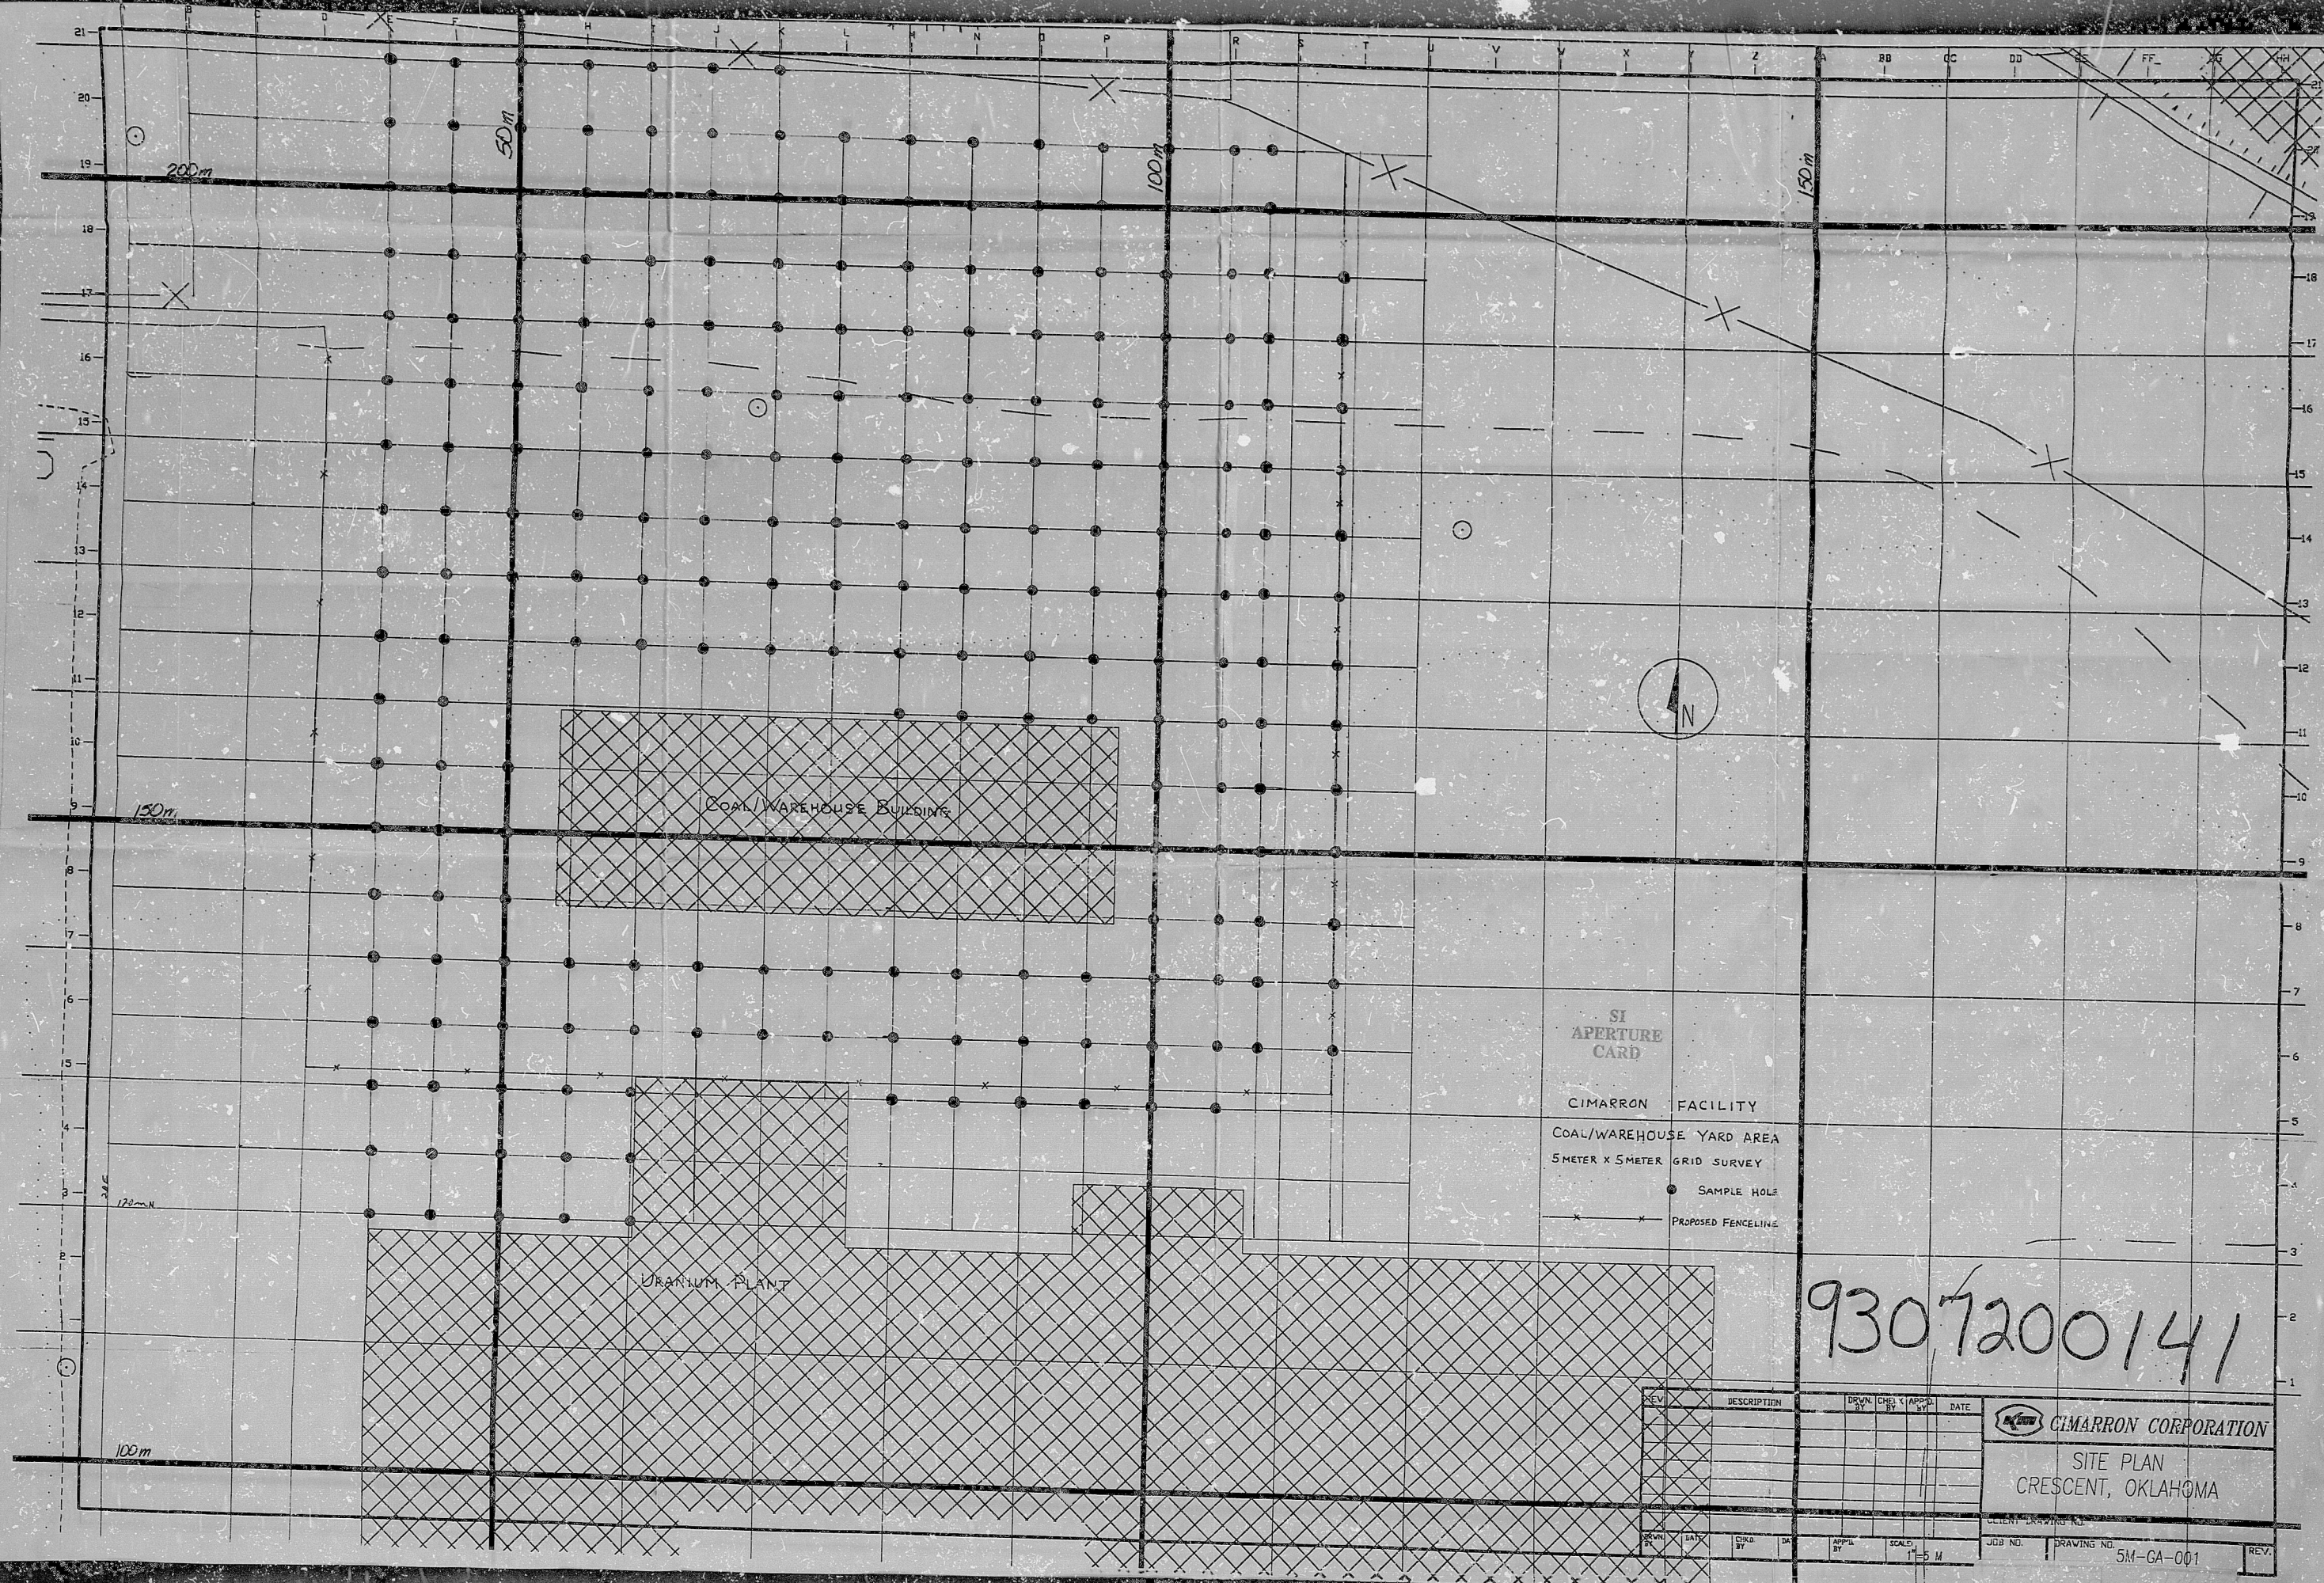

9307200141

REV.	DESCRIPTION	DATE

DATE	BY	CHKD	BY	APPR	BY	SCALE	1"=5 M

JOB NO.		DRAWING NO.		REV.
		5M-GA-001		

CIMARRON CORPORATION
SITE PLAN
CRESCENT, OKLAHOMA
CLIENT DRAWING NO.

X 9307150165

PDR RIDS

9307200141

