


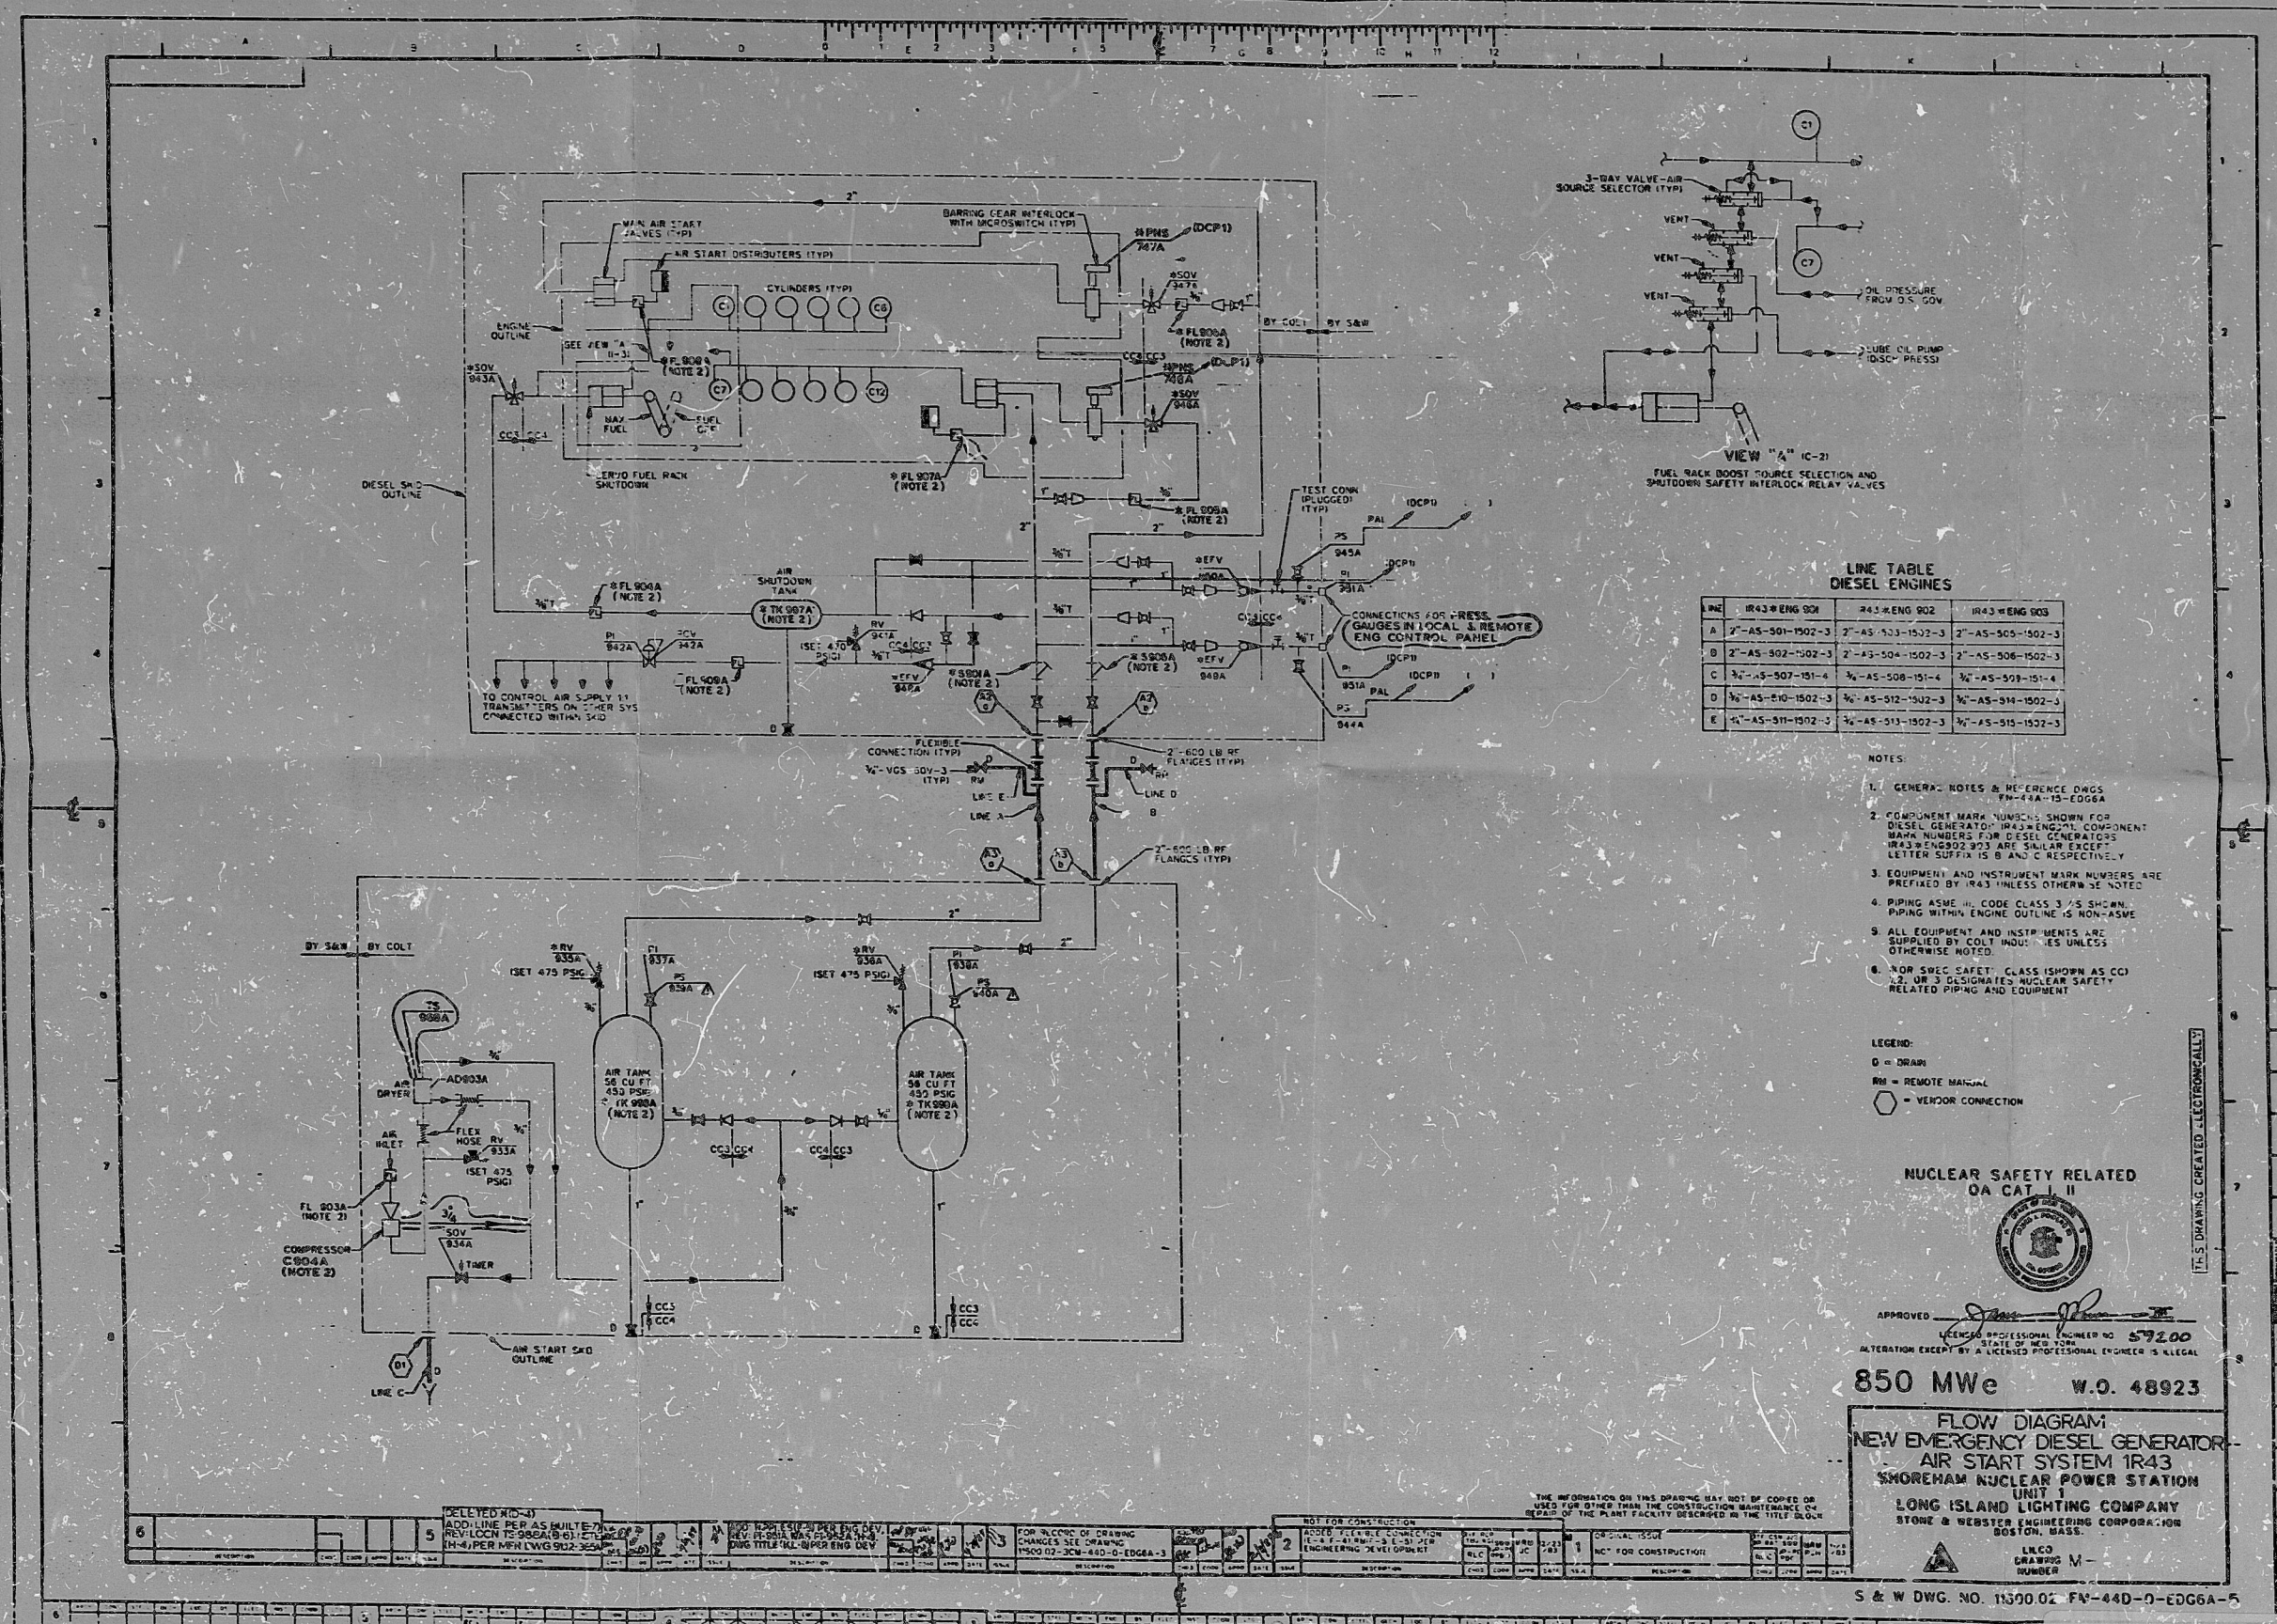

TI
APERTURE
CARD

8500070605

NEW FSAR FIGURE 9.5.6A-1
COLT DIESEL GENERATOR
AIR START SYSTEM
(FM-44D)

PDR RIDS

8506070605

