



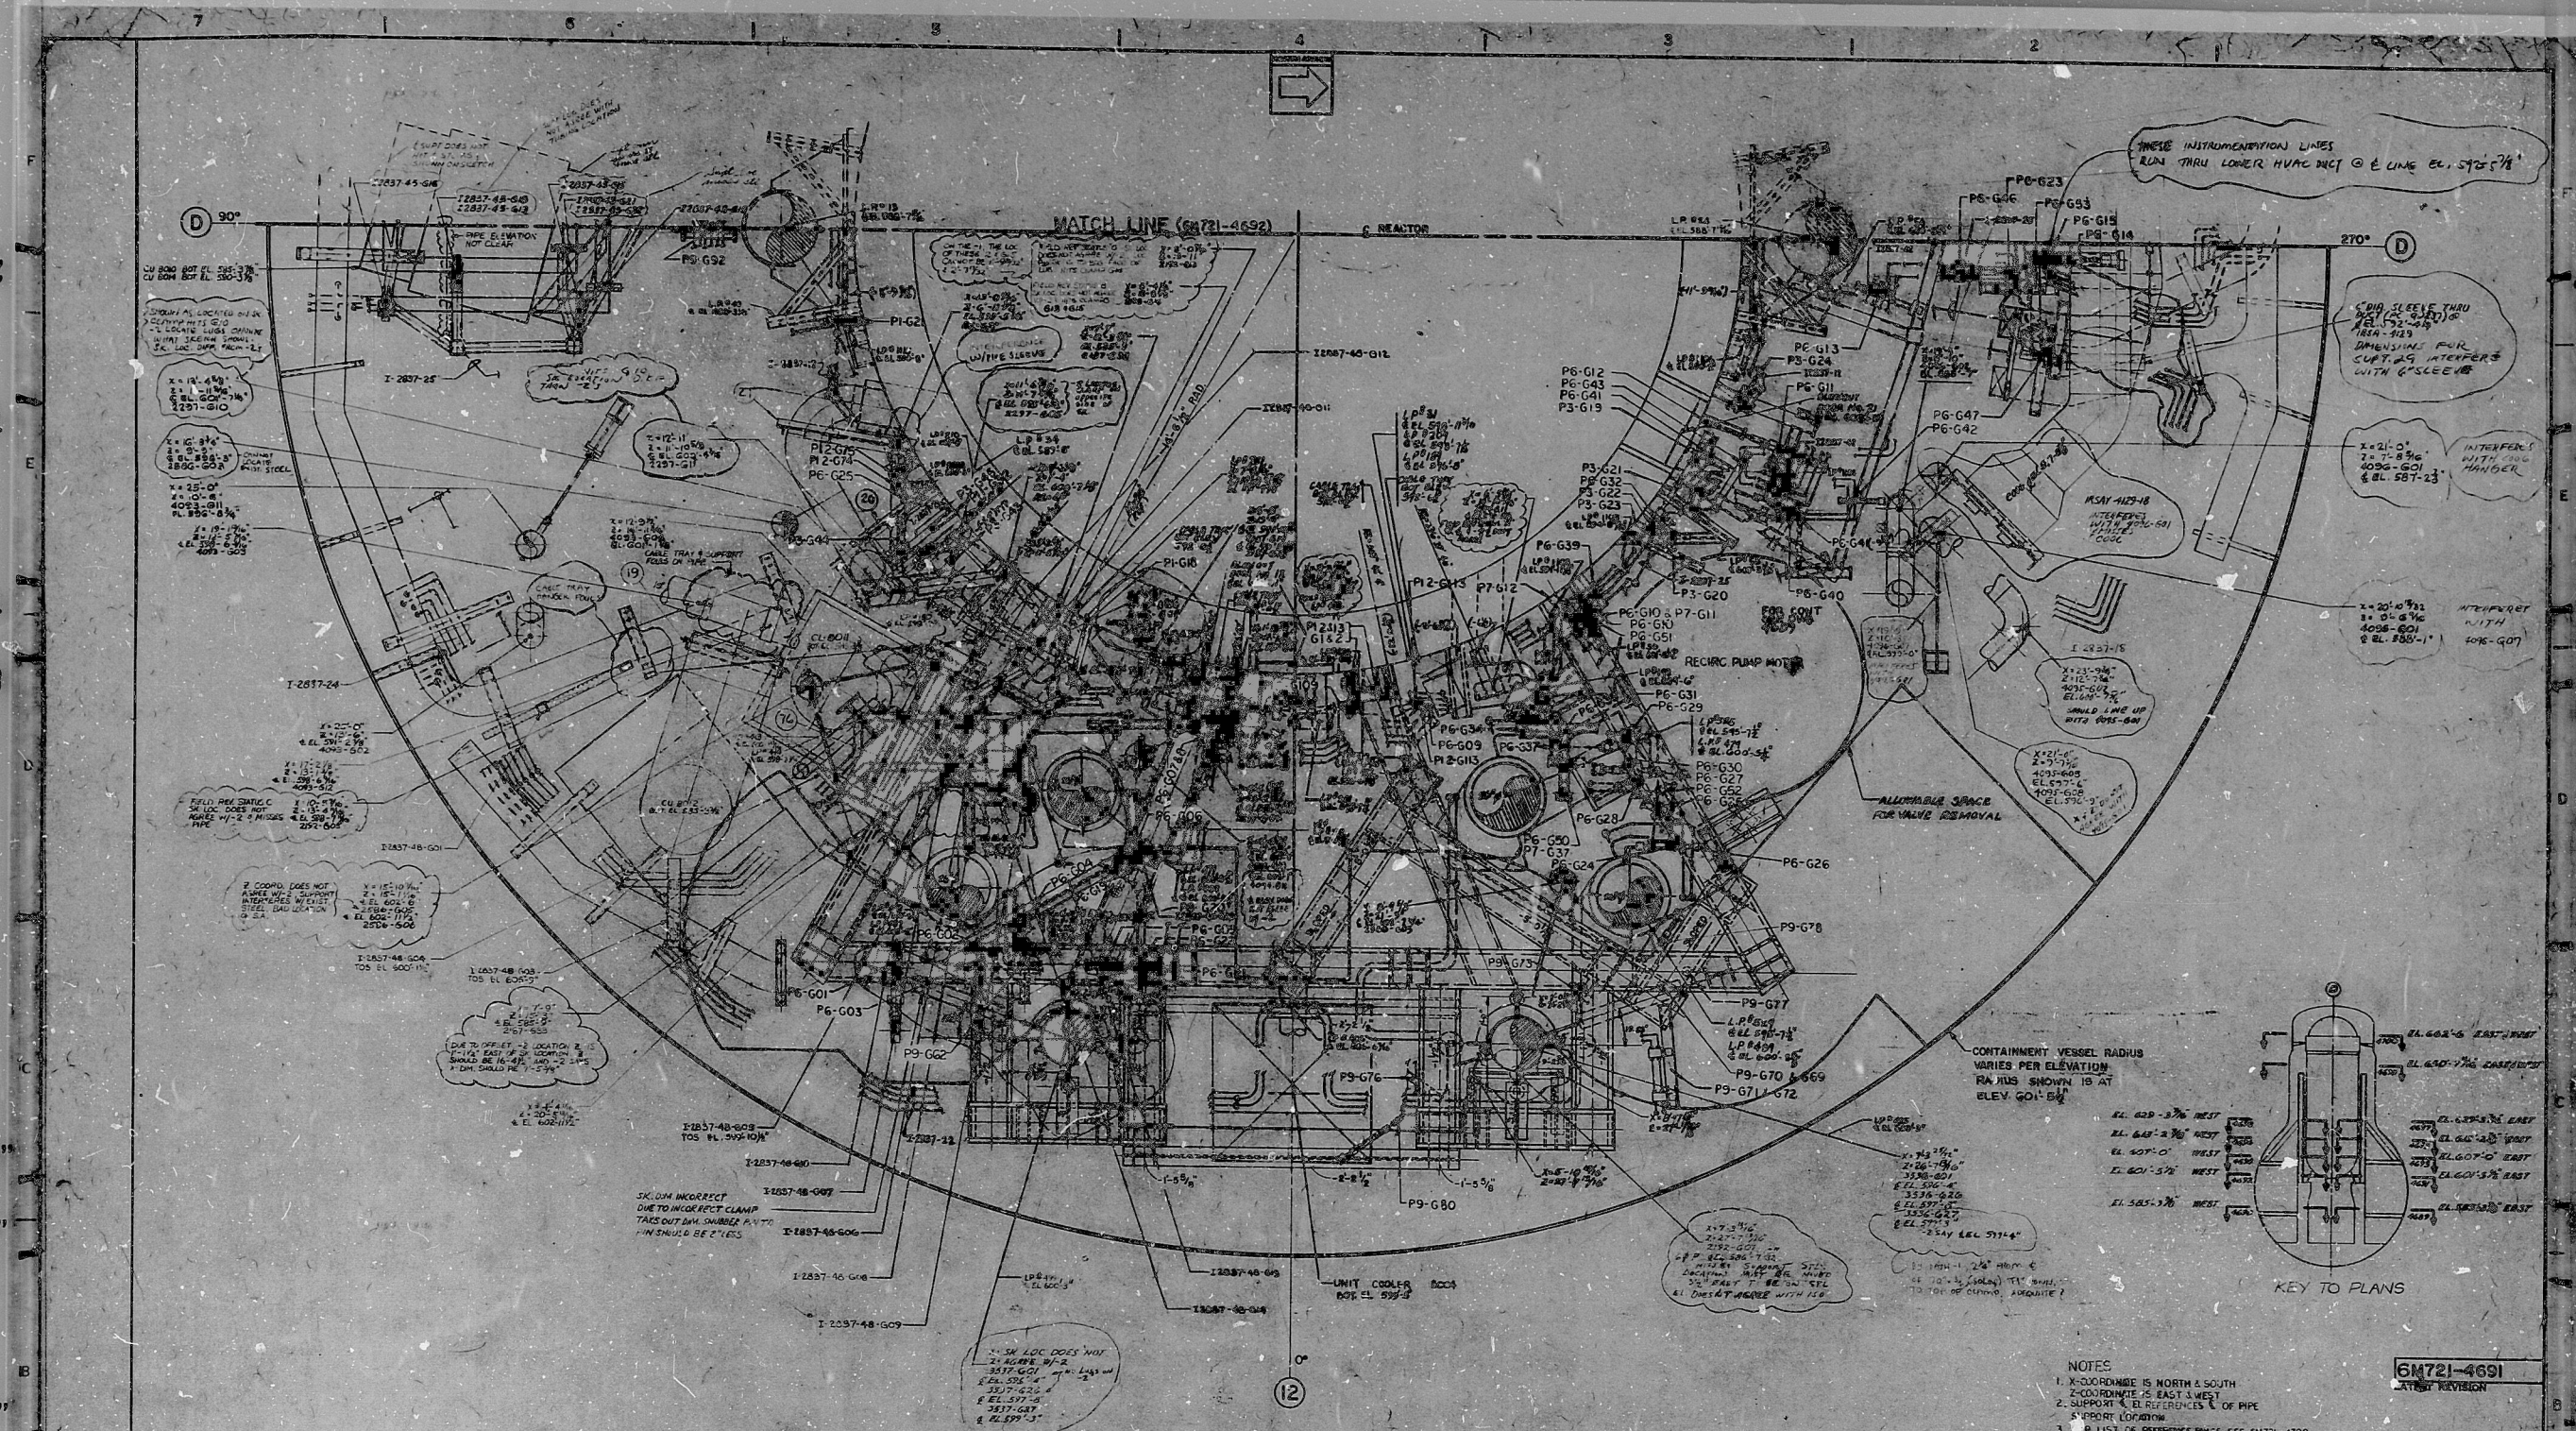

TOP OF STEEL AT EL. 601'-5 1/2"
(UNLESS OTHERWISE NOTED)

- NOTES
1. X-DIRECTION IS NORTH & SOUTH
 2. COORDINATE IS EAST & WEST
 3. SUPPORT & B. REFERENCE X OF PIPE SUPPORT LOCATION
 4. LIST OF REFERENCE DIMS. SEE 0470-1400
 5. THIS LIST IS INTENDED AS A DESIGN TOOL ONLY AND SHOULD NOT BE USED FOR FABRICATION

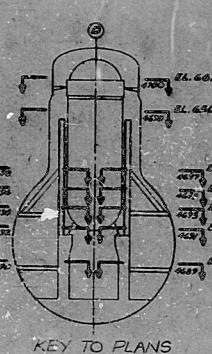


STONE & WEBSTER ENGINEERING, INC.

PROJECT NO. 6M721-4691
DATE 12/07/05
PROJECT ENGINEER: [Signature]
DESIGNER: [Signature]
CHECKER: [Signature]
APPROVED: [Signature]

THE DETROIT Edison CO. NUCLEAR DIVISION
DRYWELL COMPOSITE PLAN
@ EL. 601'-5 1/2" EAST
LOCATION: EHRIC FERRI ATOMIC POWER PLANT N. 2
PROJECT NO. 6M721-4691
SCALE: 1" = 1'-0"

RIDS-RDR

8104060408

